C.S. FILE 40/305
M16-32

COUNTY SURVEYORS FILE DATA
DO NOT REMOVE FROM OFFICE

C. S. NO.

MAR-LINN TIMBER CORP.

SEC. 13 & 24, T. 26 S., R. 6W., W.M.

SCALE: 1" = 400

DEC. 1950

BERT W. UDELL
LISC. ENGR.

Bert W. Udell

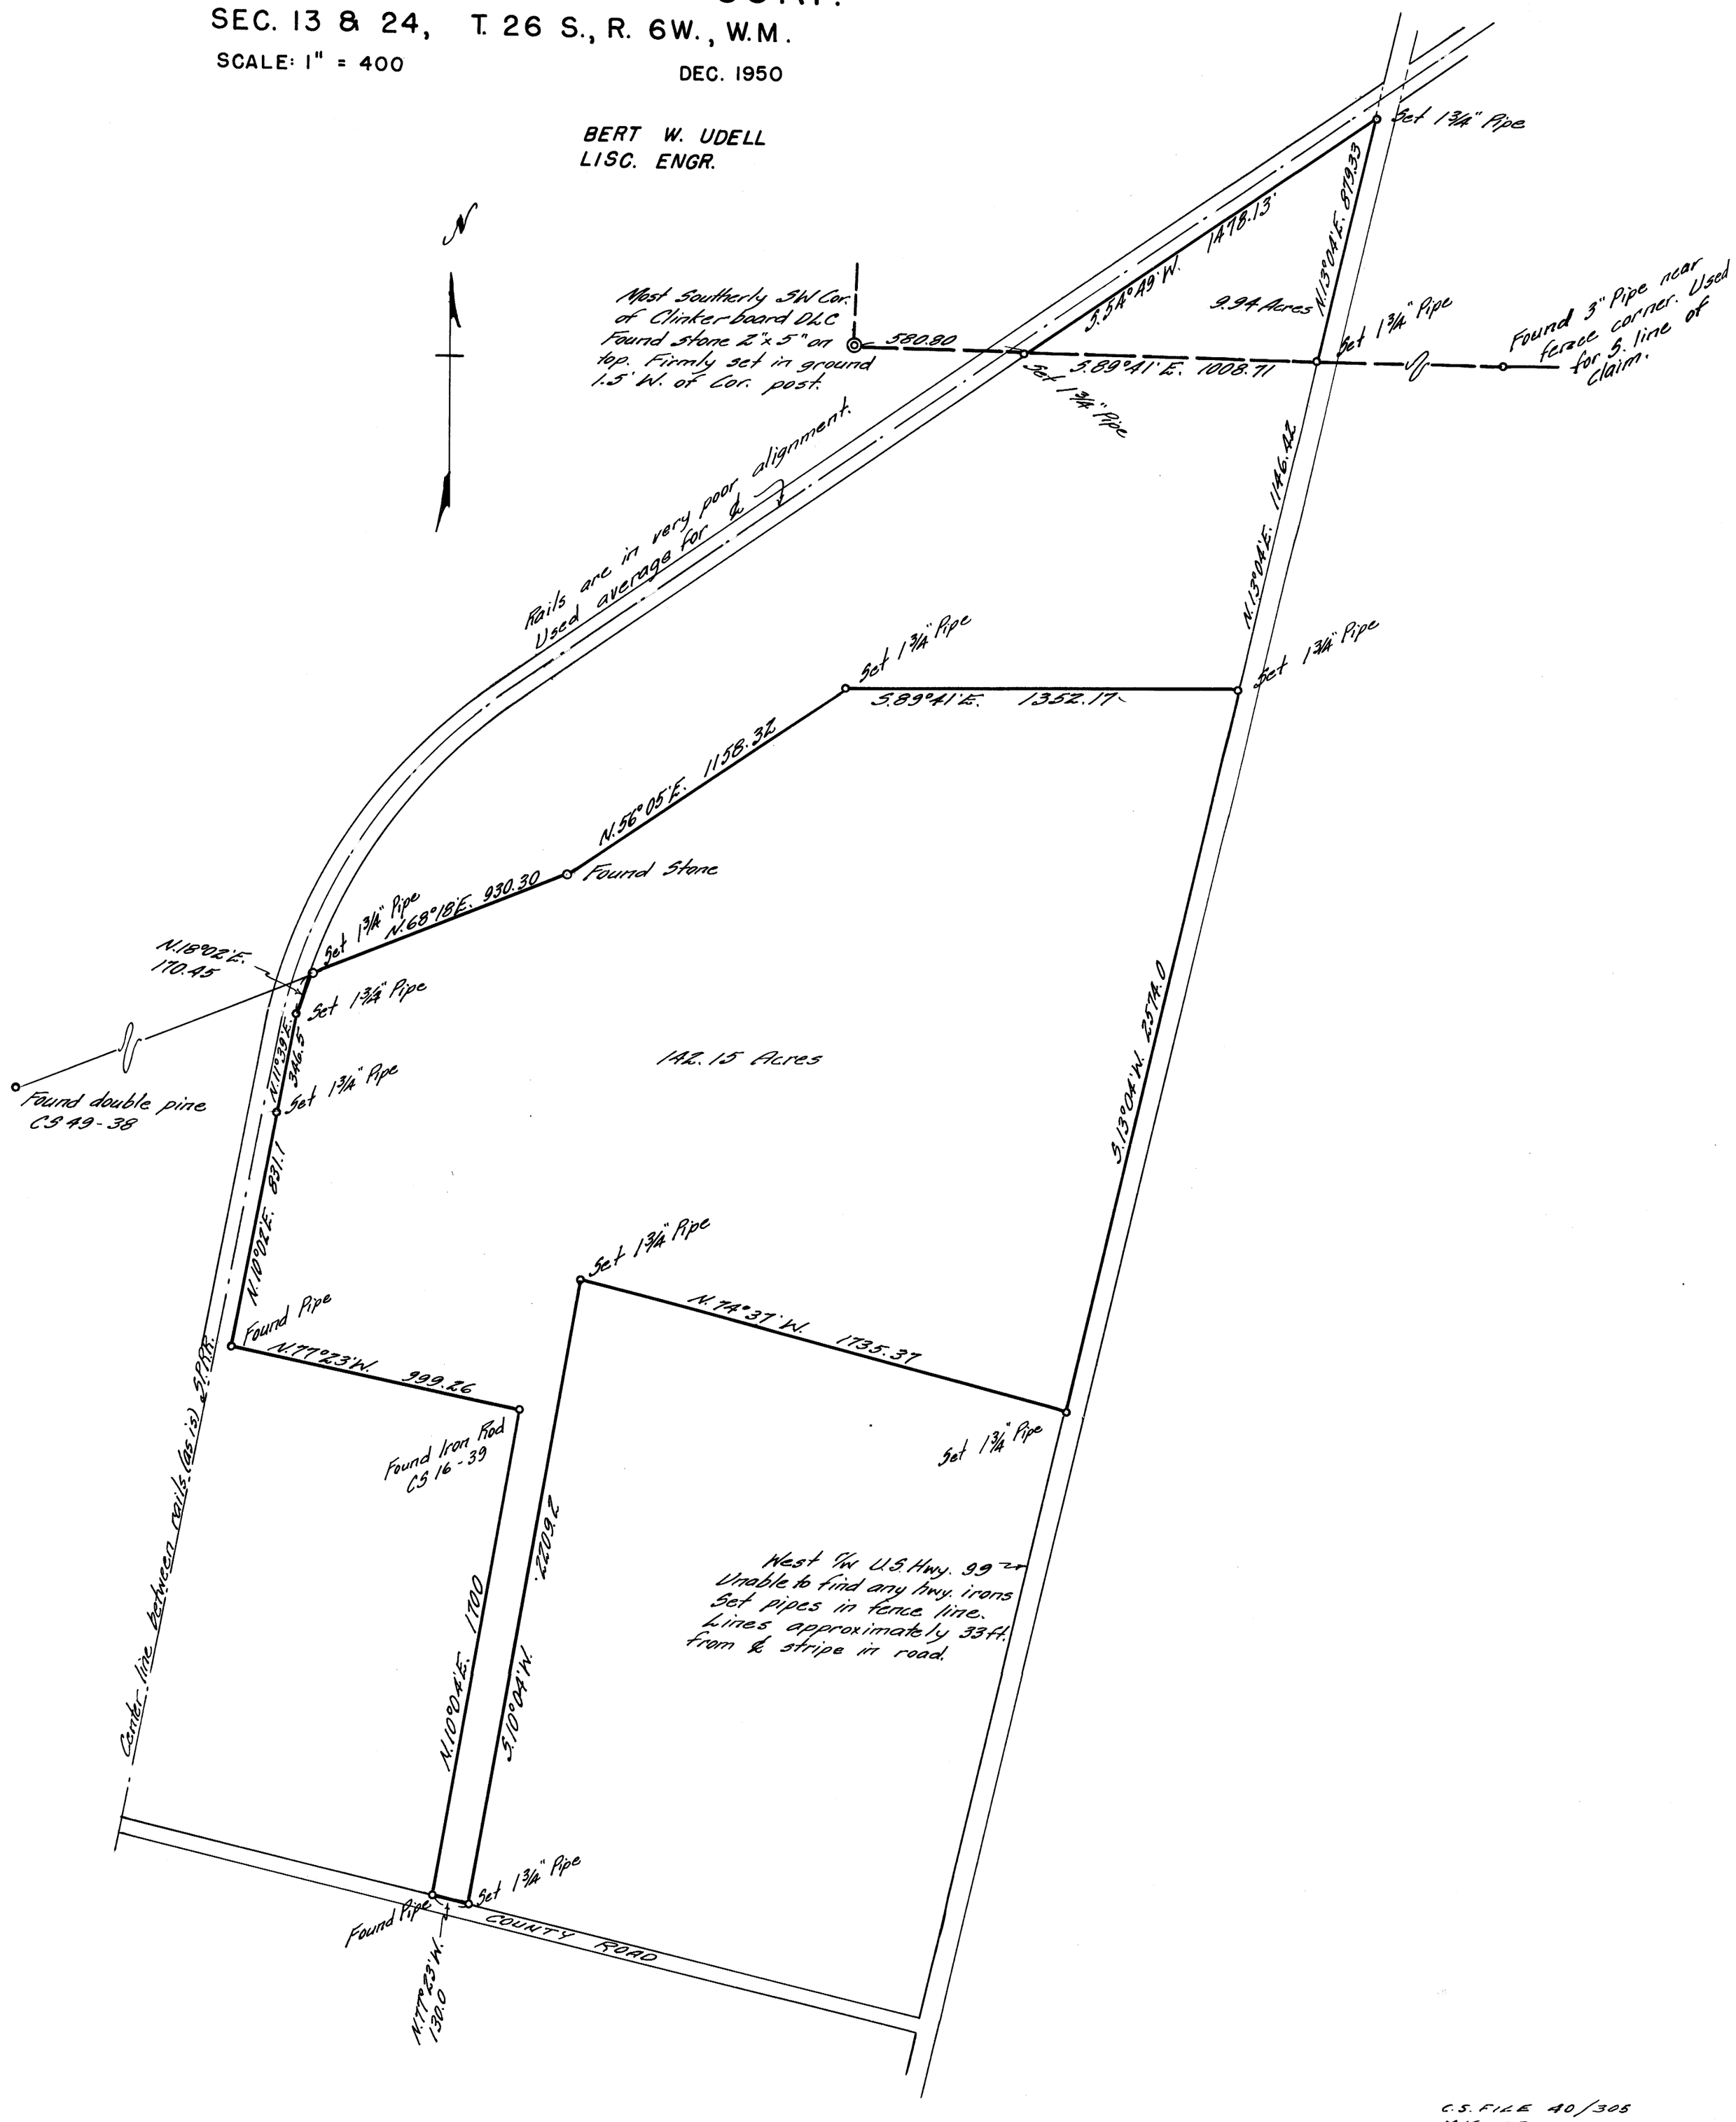

C.S. FILE 40/305
M16-32