COUNTY SURVEYORS FILE DATA
DO NOT REMOVE FROM OFFICE

COUNTY SURVEYOR'S OFFICE
DOUGLAS COUNTY OREGON

B. R. SHOEMAKER TO QUAKER INDUSTRIES
SECTIONS 24-25 T26S., R6W., W.M.

BEN. B. IRVING — County Surveyor
N. E. RICHARDSON — Deputy

SCALE 1" = 200'

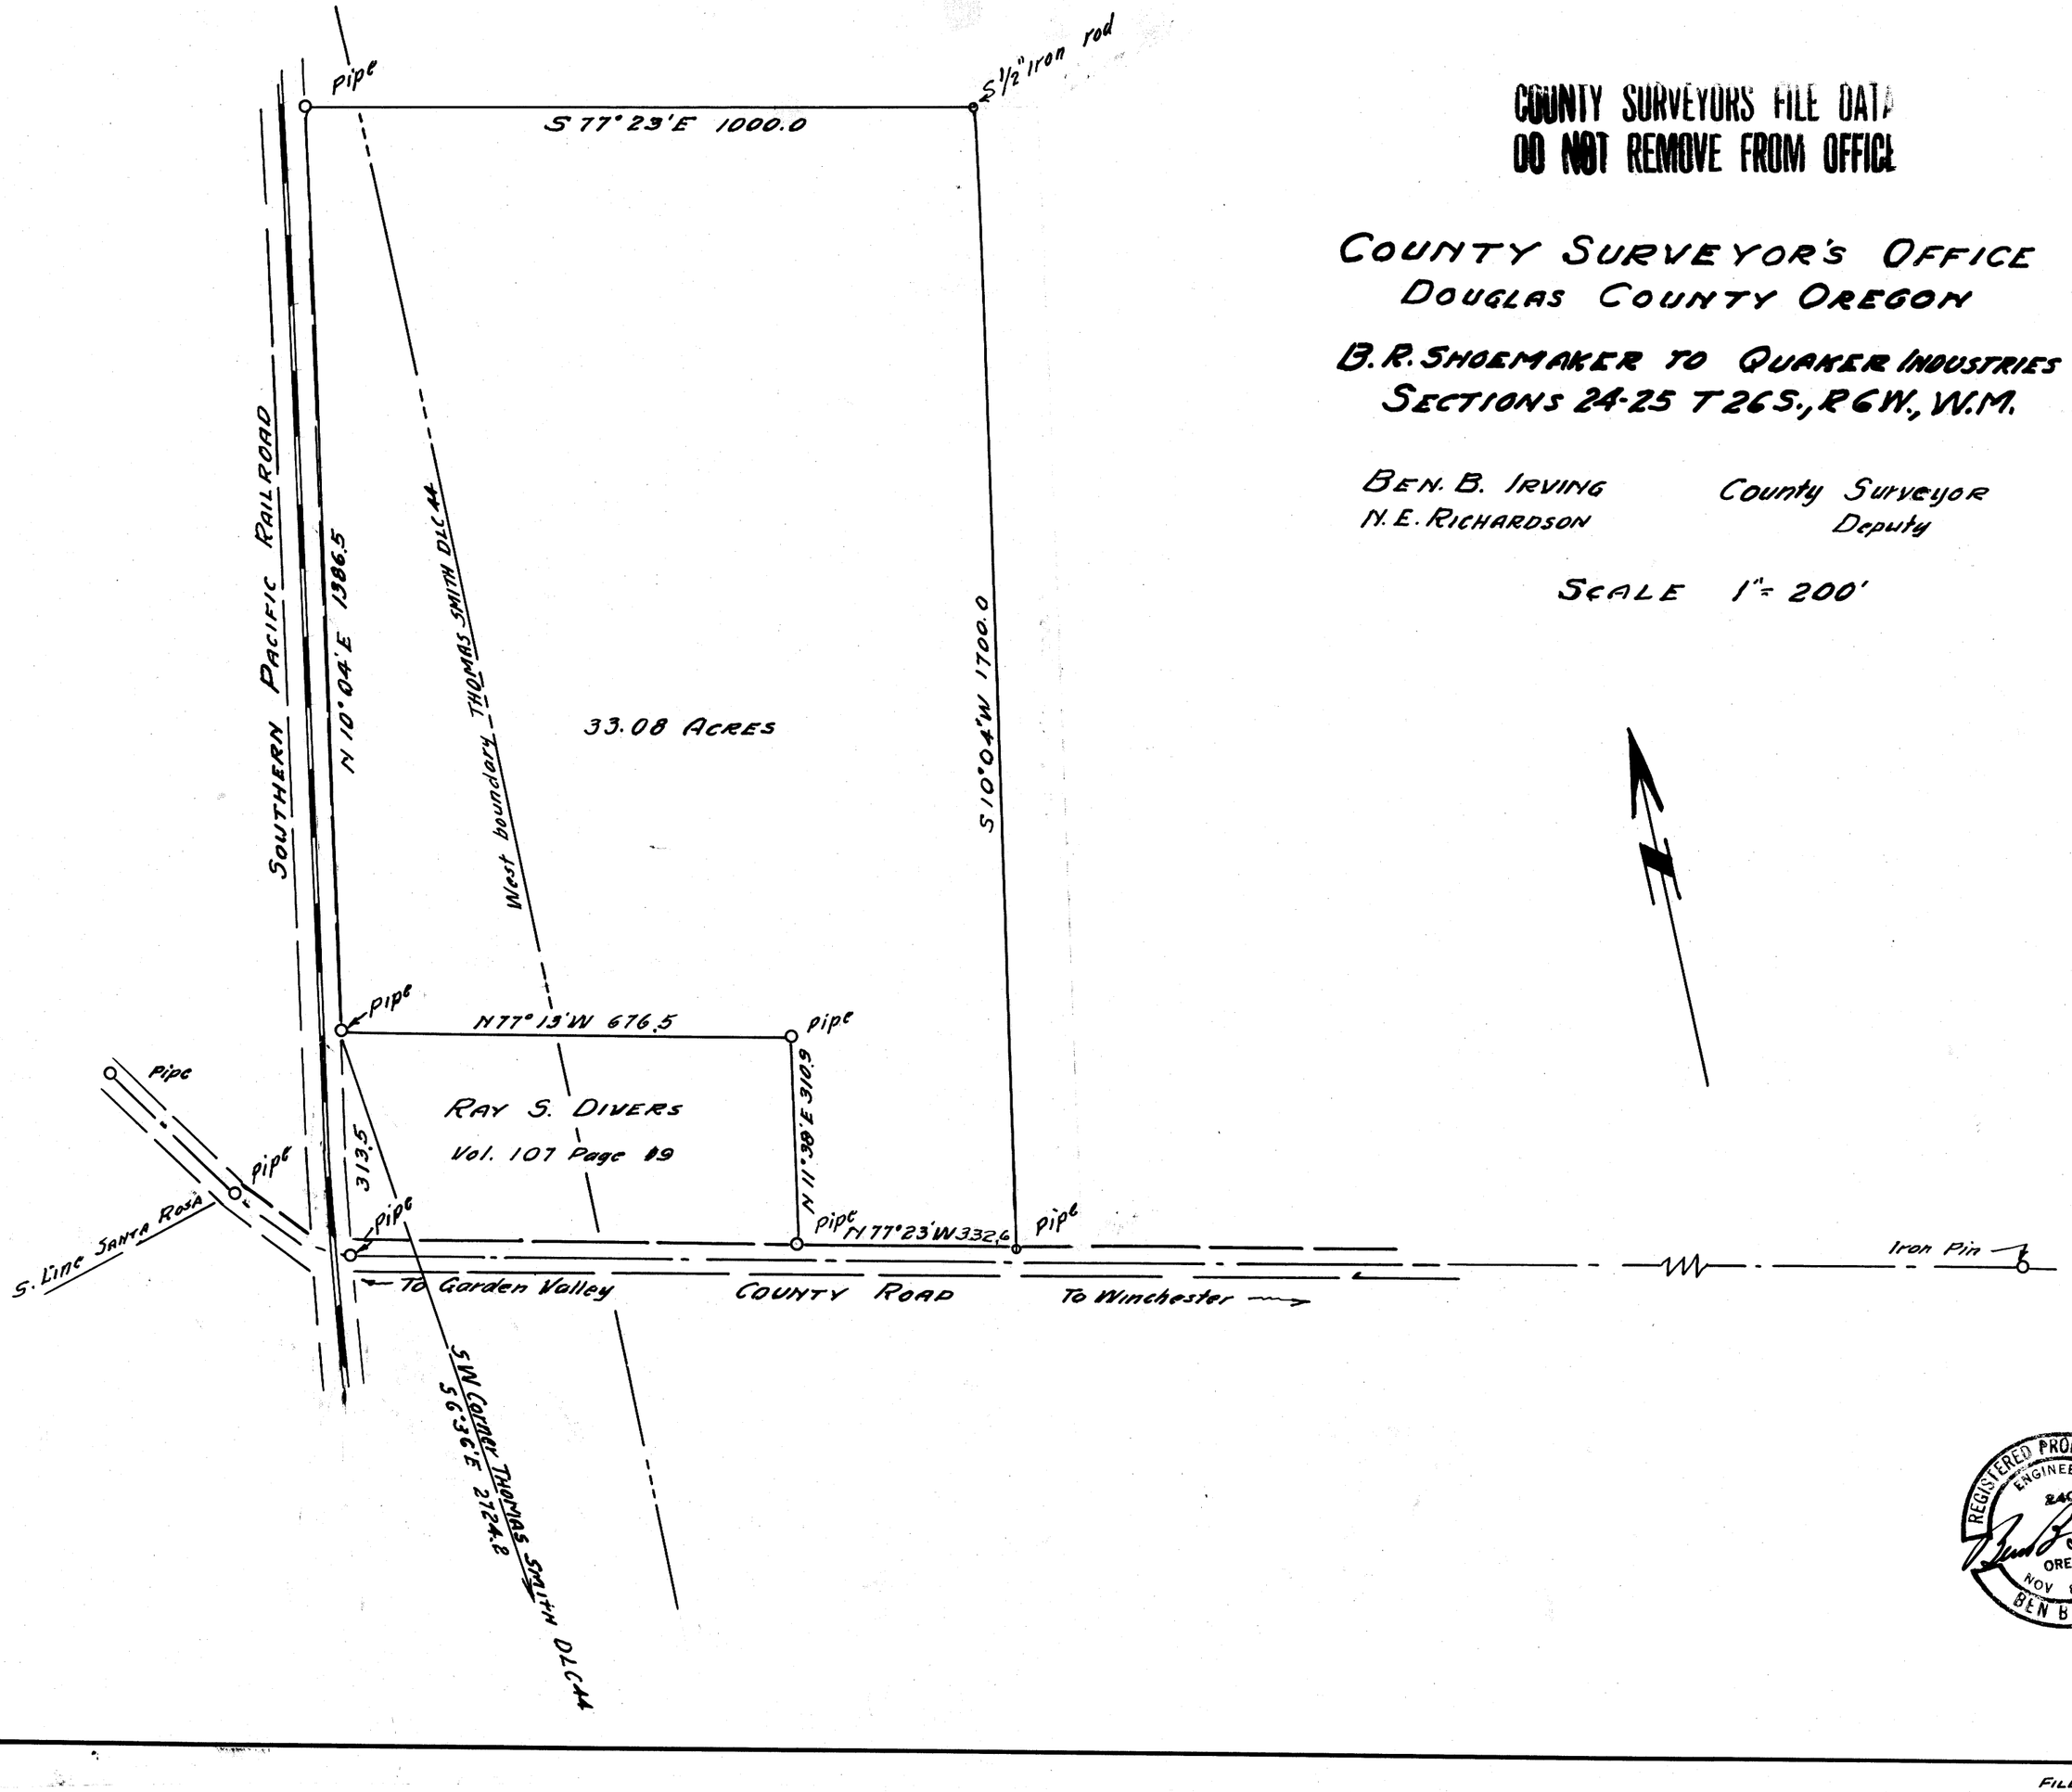

REGISTERED PROFESSIONAL ENGINEER 240 OREGON NOV 8, 1919 BEN B. IRVING

M16-68

FILE 16 DRAWER 39