MAP FILE M 16-63

COUNTY SURVEYORS FILE DATA
DO NOT REMOVE FROM OFFICE

COUNTY SURVEYOR'S OFFICE
DOUGLAS COUNTY, OREGON.
SURVEY FOR
LEE KELLOR in D.L.C. No. 45
Section 20, T.30 S., R.5 W. W.M.
Geo. J. Wenderoth, Deputy. Dec. 1954
Scale 1" = 200 ft.

REGISTERED
OREGON
LAND SURVEYOR
Geo J. Wenderoth
MARCH 10, 1944
George J. Wenderoth
5

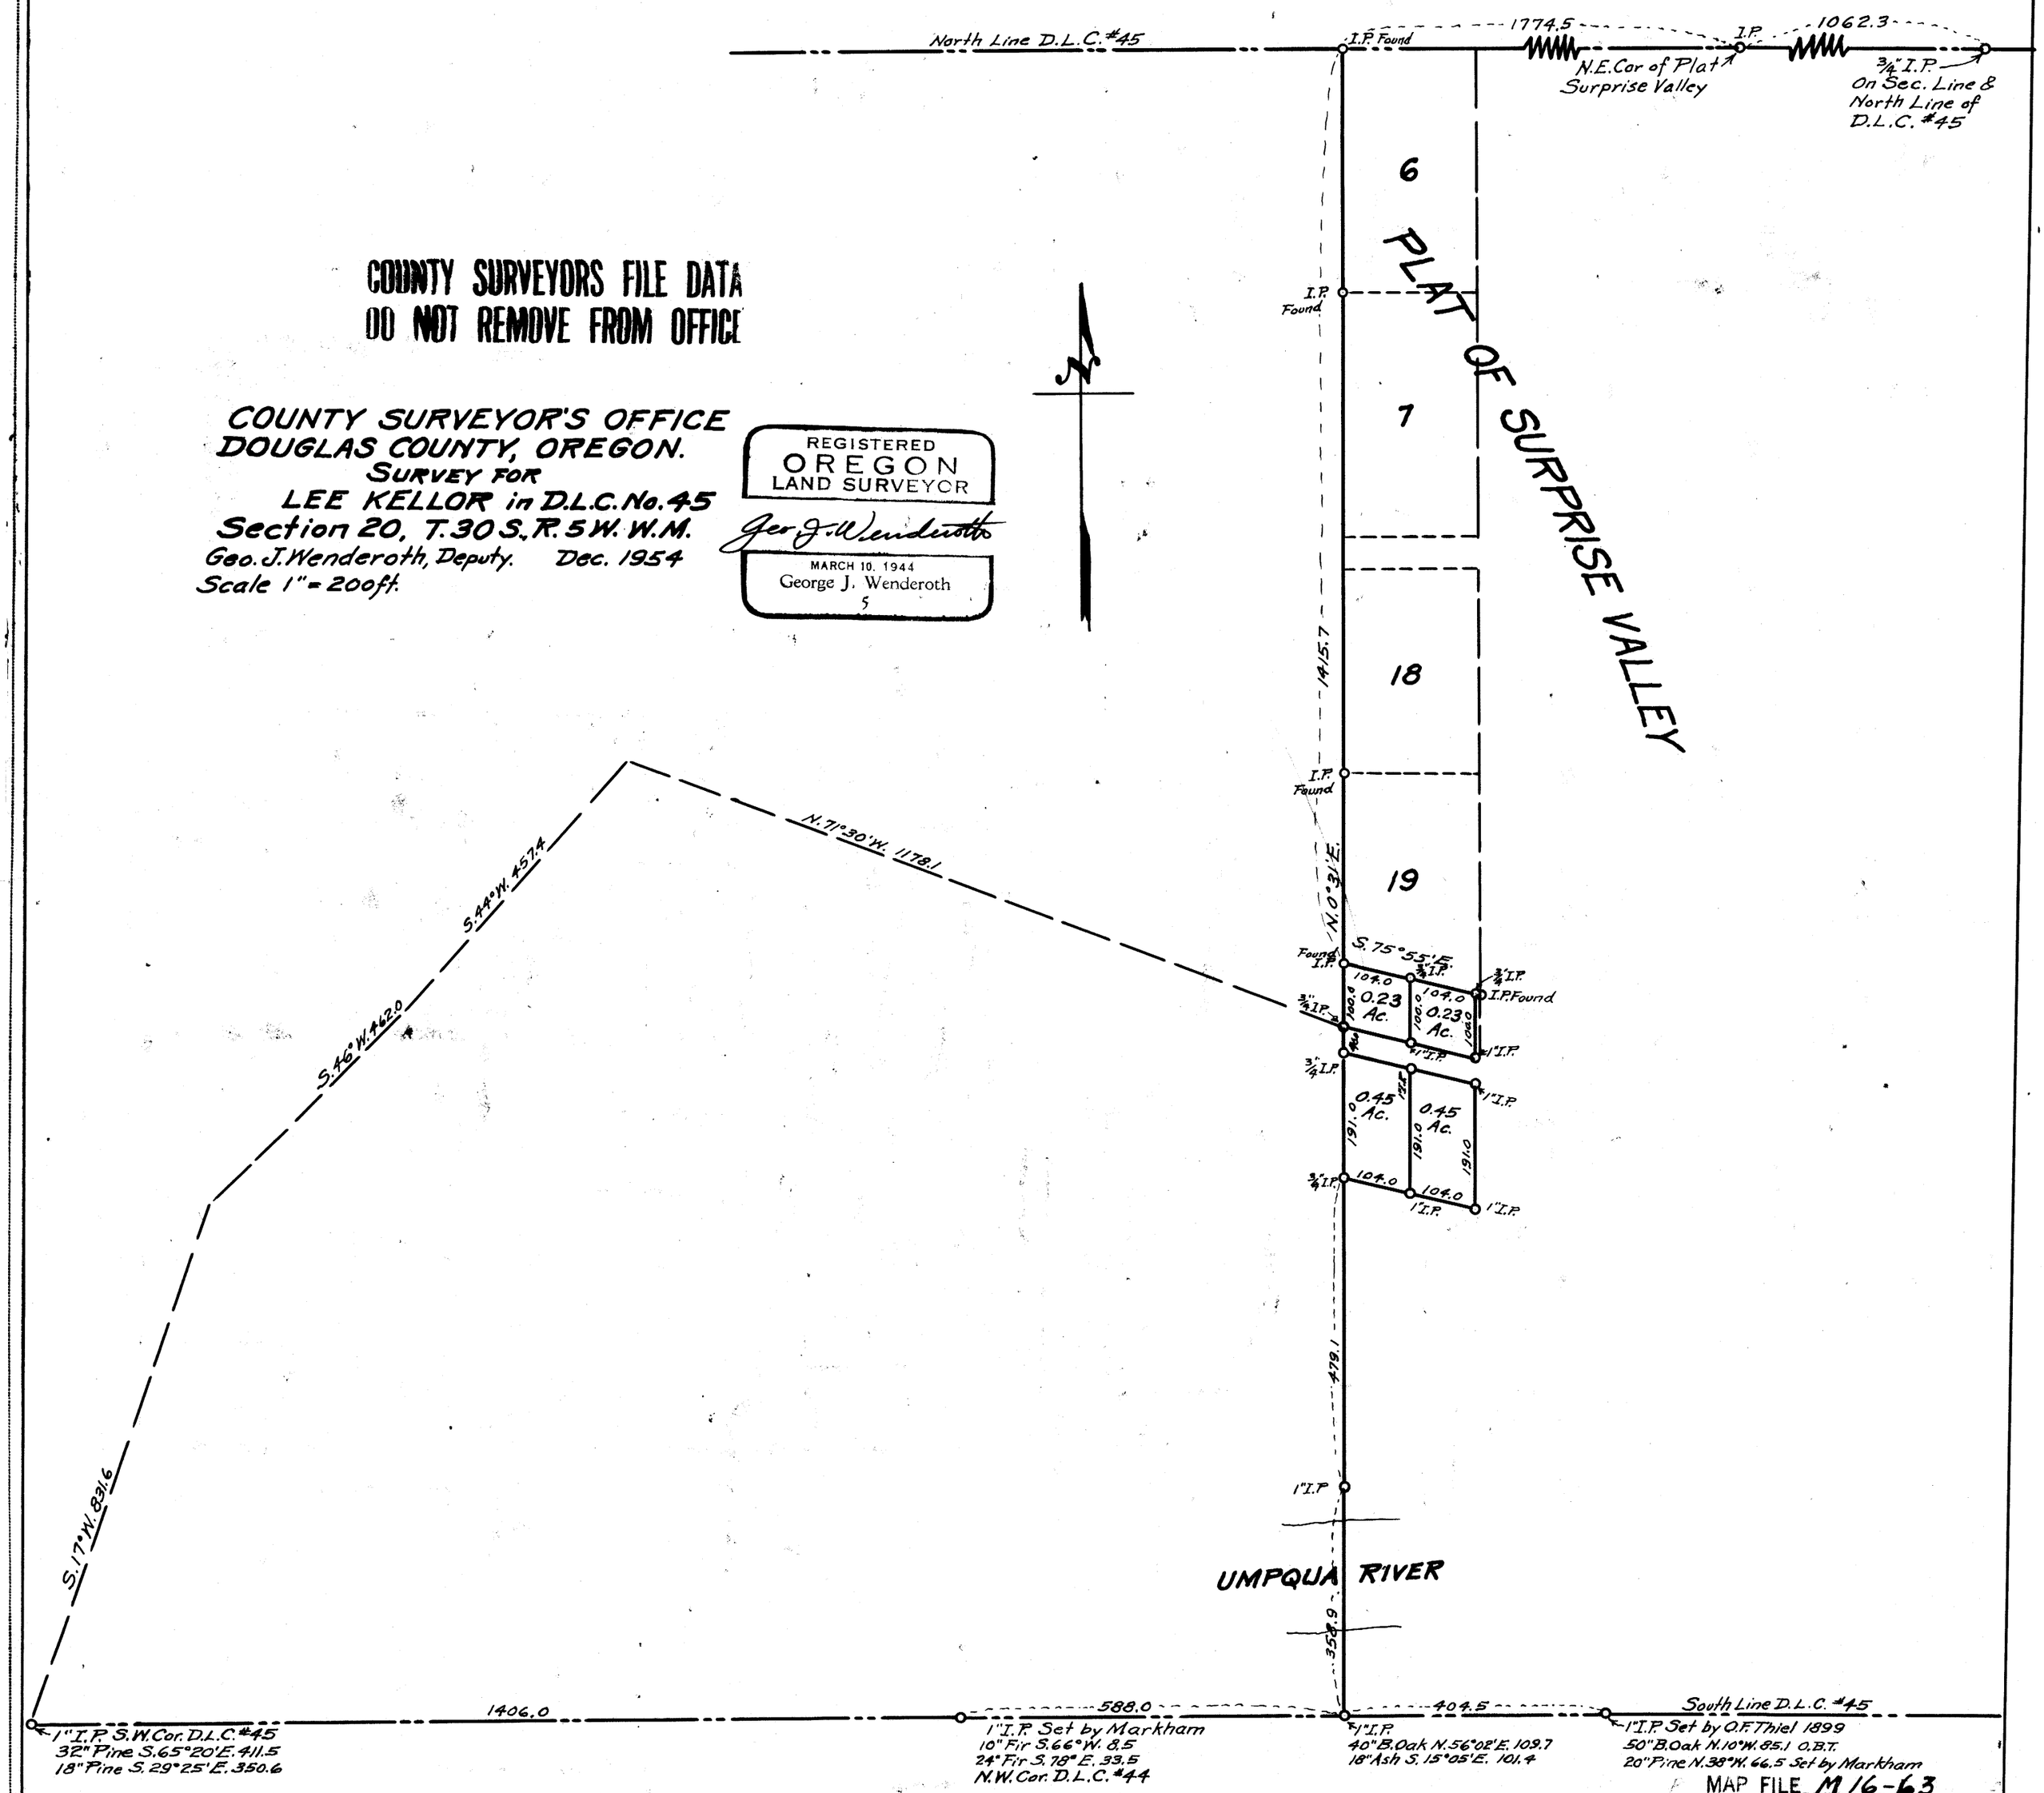

MAP FILE M 16-63

C.S. FILE No. 46/73