C.S. FILE 40/237
M16-76

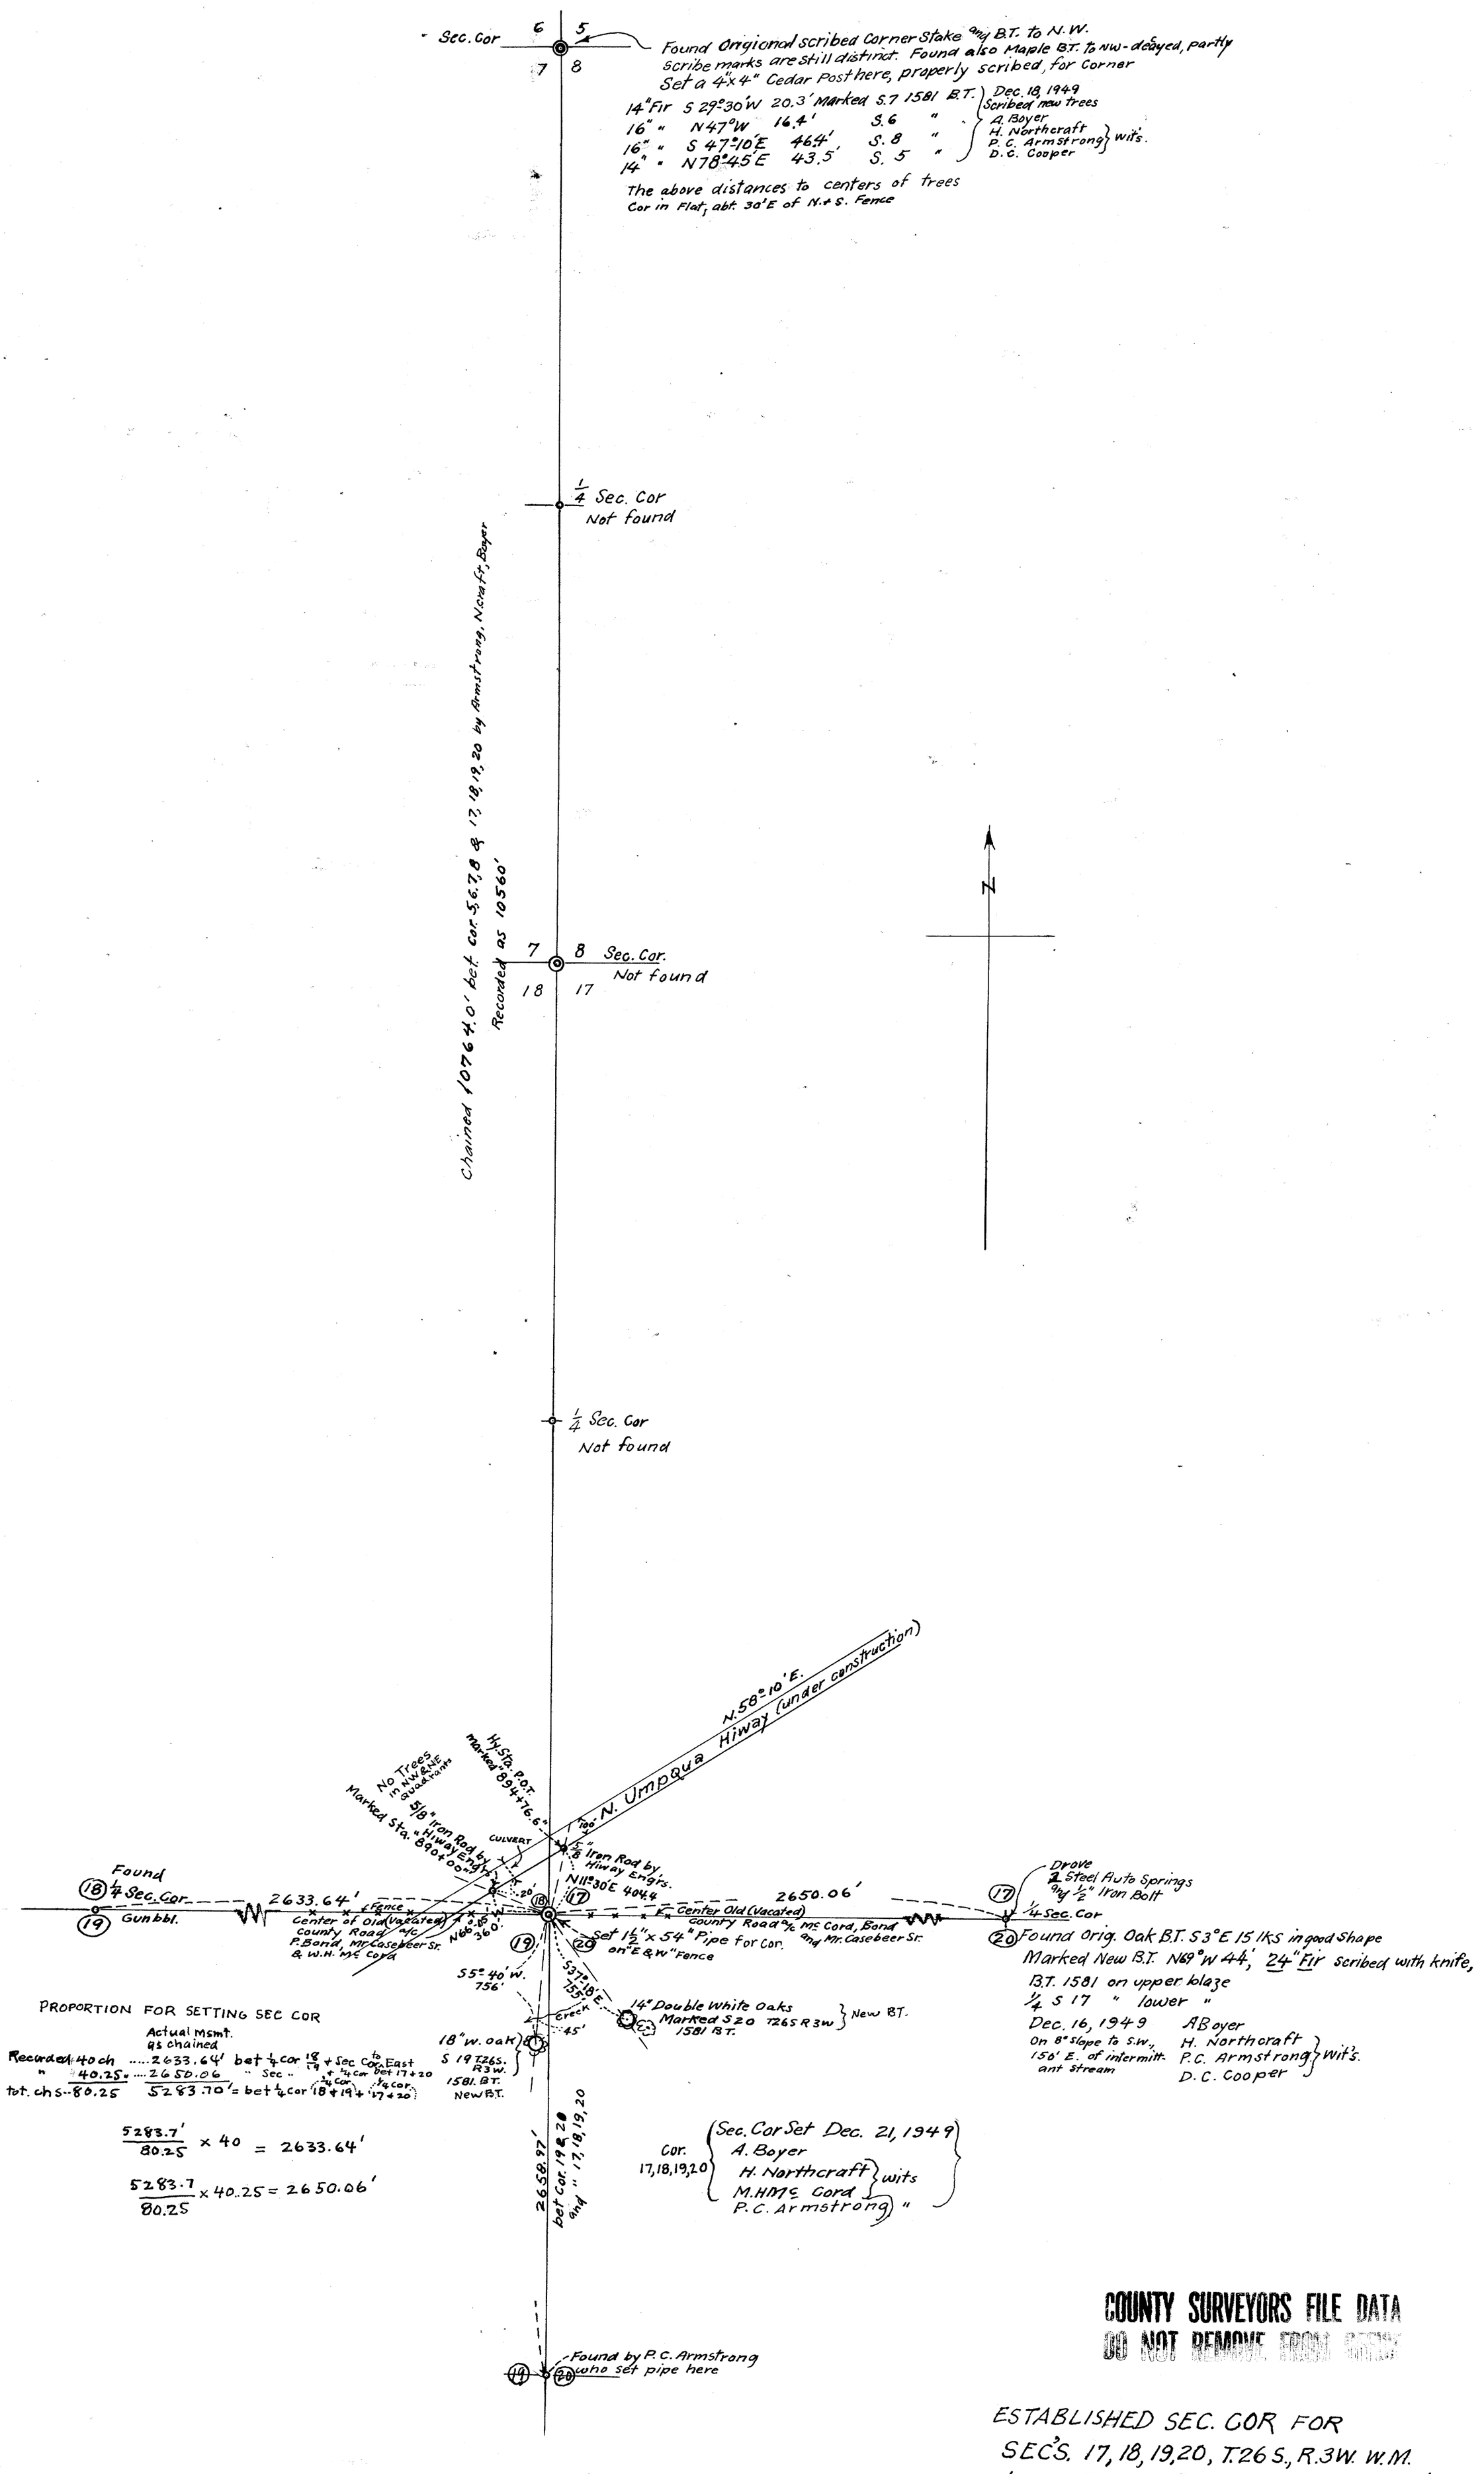

PROPORTION FOR SETTING SEC COR

	Actual msmt. as chained	
Recorded 40 ch	....2633.64'	bet 1/4 cor 18/19 + Sec Cor. to East + 1/4 cor bet 17+20
" 40.25 "	....2650.06	" Sec " + 1/4 cor + 1/4 cor.
tot. chs--80.25	5283.70'	= bet 1/4 cor 18+19+17+20

$$\frac{5283.7'}{80.25} \times 40 = 2633.64'$$

$$\frac{5283.7}{80.25} \times 40.25 = 2650.06'$$

COUNTY SURVEYORS FILE DATA
DO NOT REMOVE FROM OFFICE

ESTABLISHED SEC. COR FOR
SEC'S. 17, 18, 19, 20, T.26 S., R.3W. W.M.
Jan 1950 A Boyer. 1" = 600'
CORNER LOST OR OBLITERATED

C.S. FILE 40/237
M16-76
MAP FILE M 16 - 76