C.S. 42/44
M16-8

DEC 30 1955

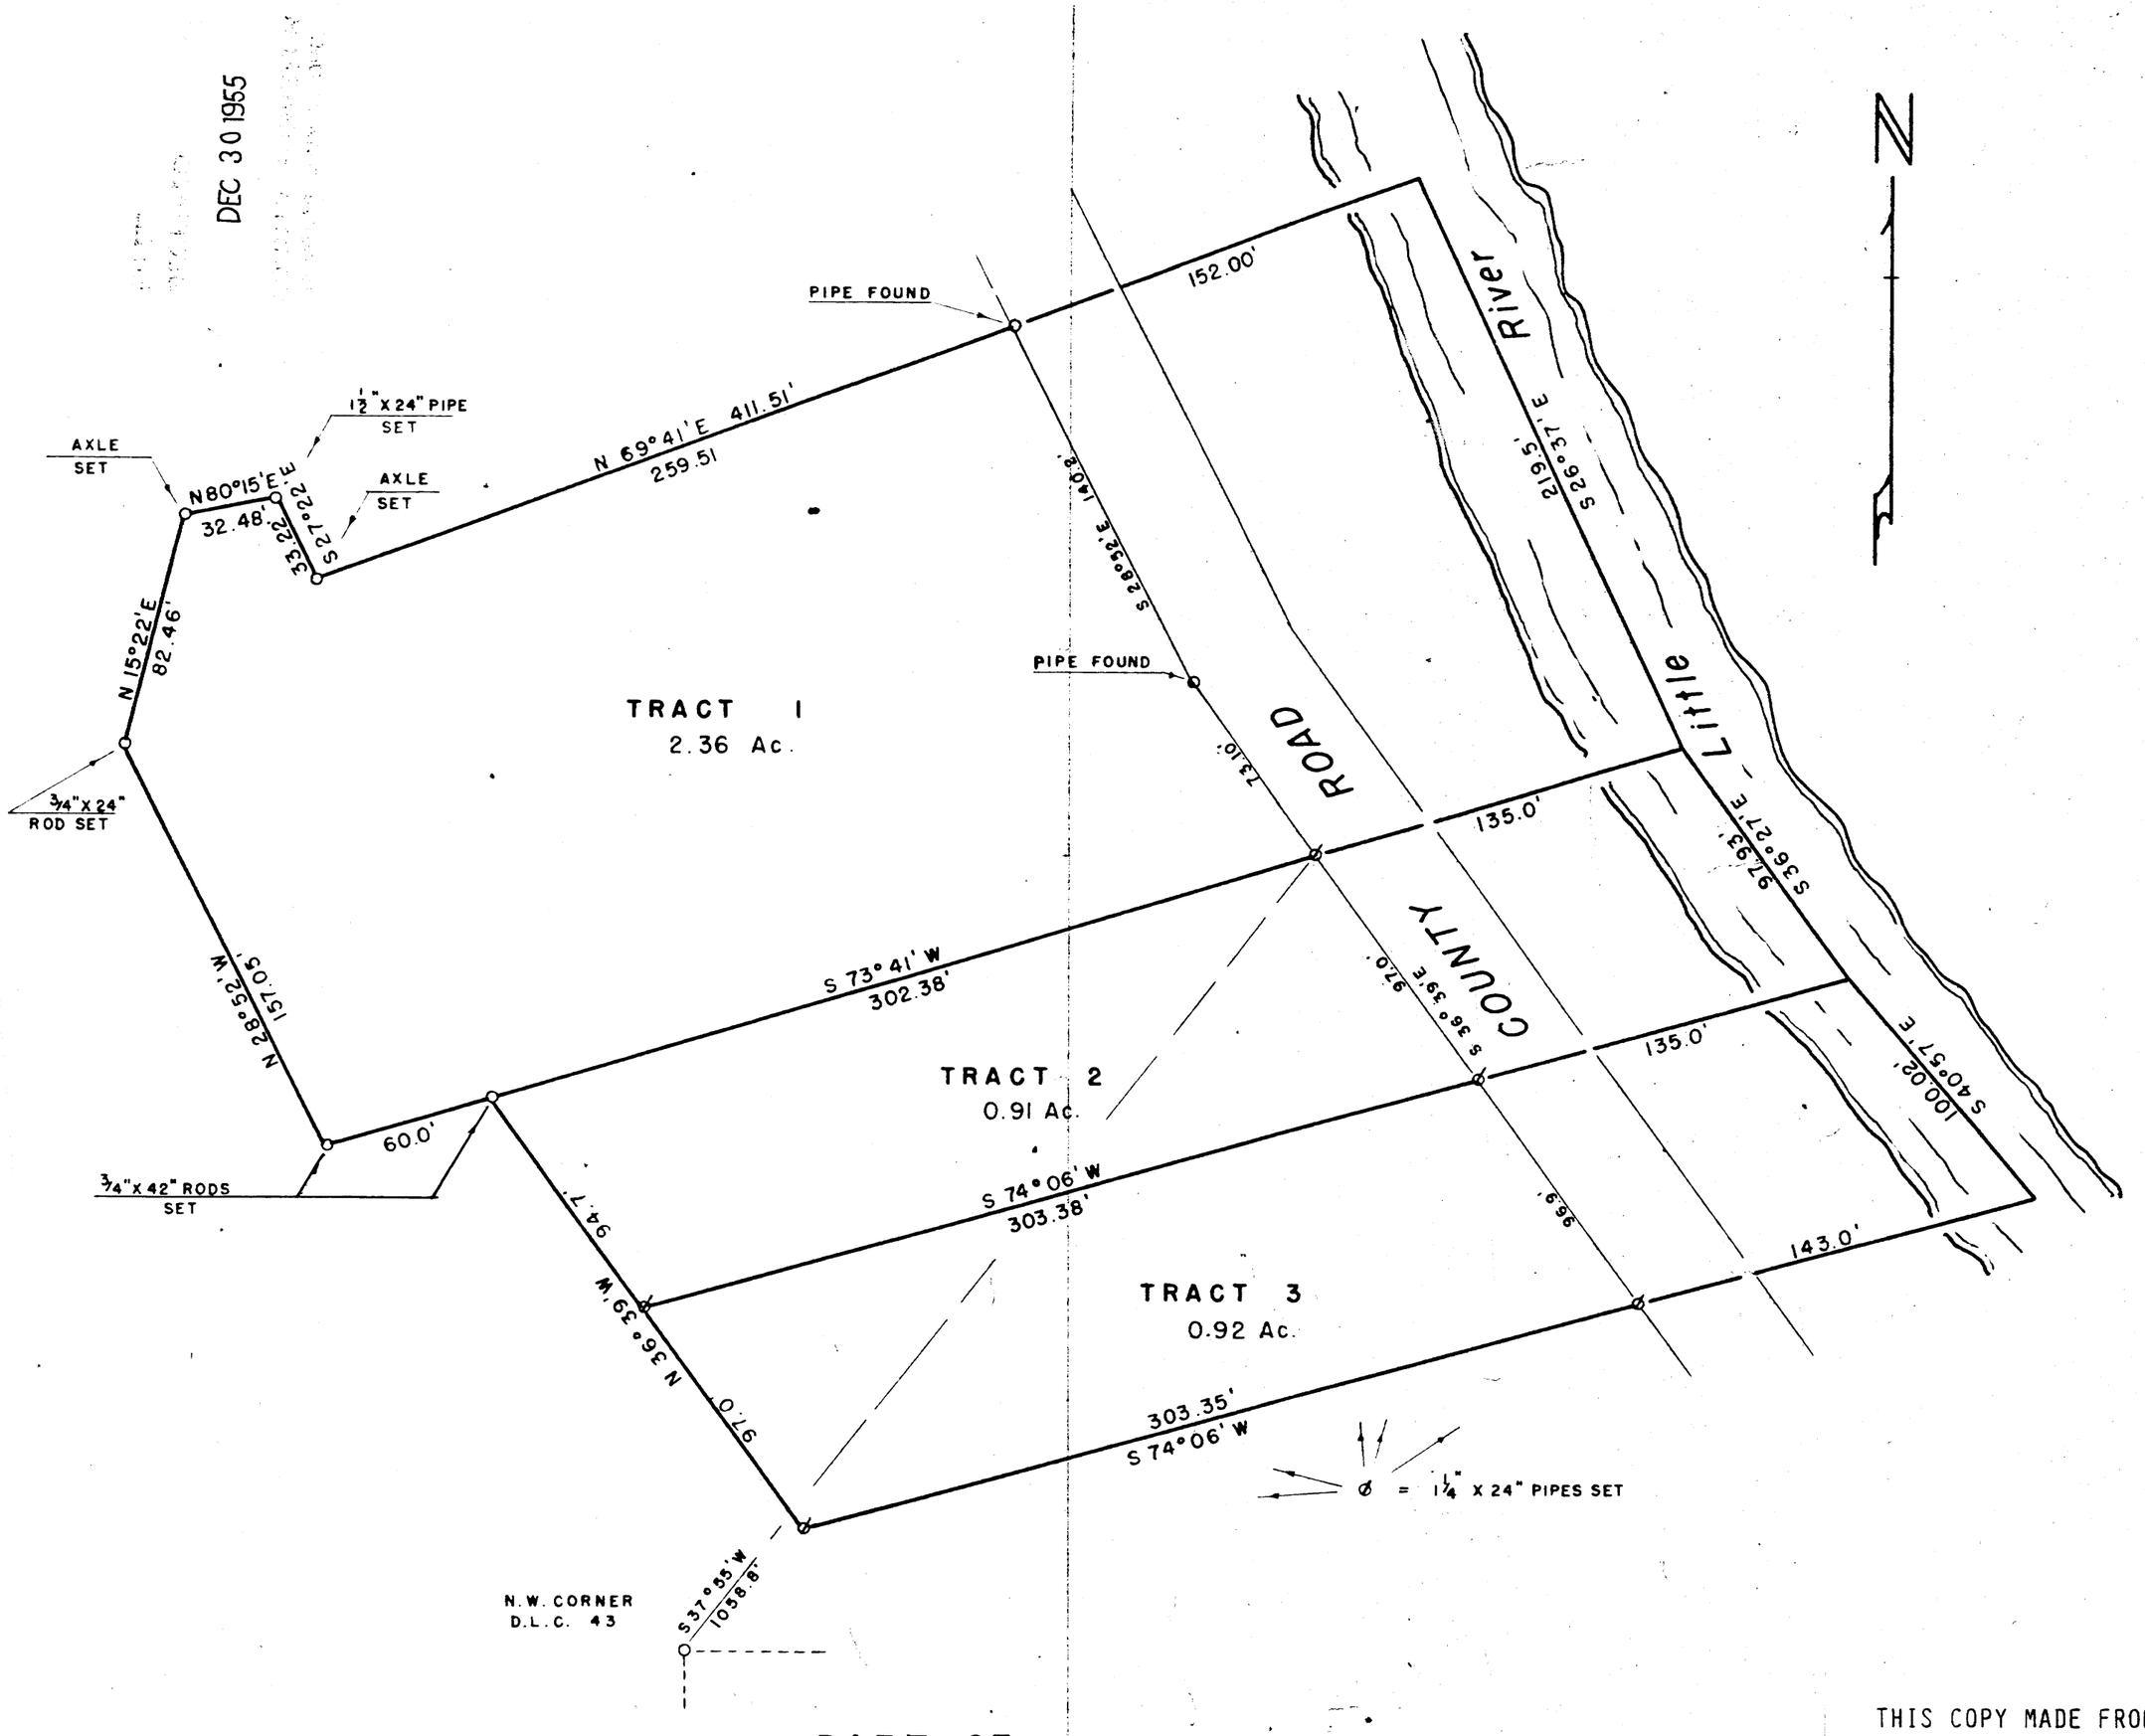

PART OF

H.L. BRUFFY PROPERTY

IN SEC 19 - T 26 S - R 3 W W.M. Douglas Co., Ore.

AUGUST 1951

SCALE 1" = 50'

THIS COPY MADE FROM
A XEROX 2510
DATE 6-6-89

COUNTY SURVEYORS FILE
DO NOT REMOVE FROM OFF

C.S. 42/44
M16-8

C.S. 42/44
M16-8