COUNTY SURVEYORS FILE MAP
DO NOT REMOVE FROM OFFICE

SURVEY TO ESTABLISH PROPERTY CORNERS IN LOTS 1, 9, 10 & 11, A. J. BELLOWS ADDITION TO WEST ROSEBURG, DOUGLAS COUNTY, OREGON

SURVEYED FOR: B. A. YOUNG & S. J. COOPER — JANUARY, 1960

SURVEYED BY: G. R. LECKLIDER – ENG'R. — SCALE: 1" = 50'

● DENOTES SURVEY CORNERS FOUND AS SHOWN.

○ DENOTES SURVEY CORNERS SET (STEEL TUBE WITH SURVEY CAP).

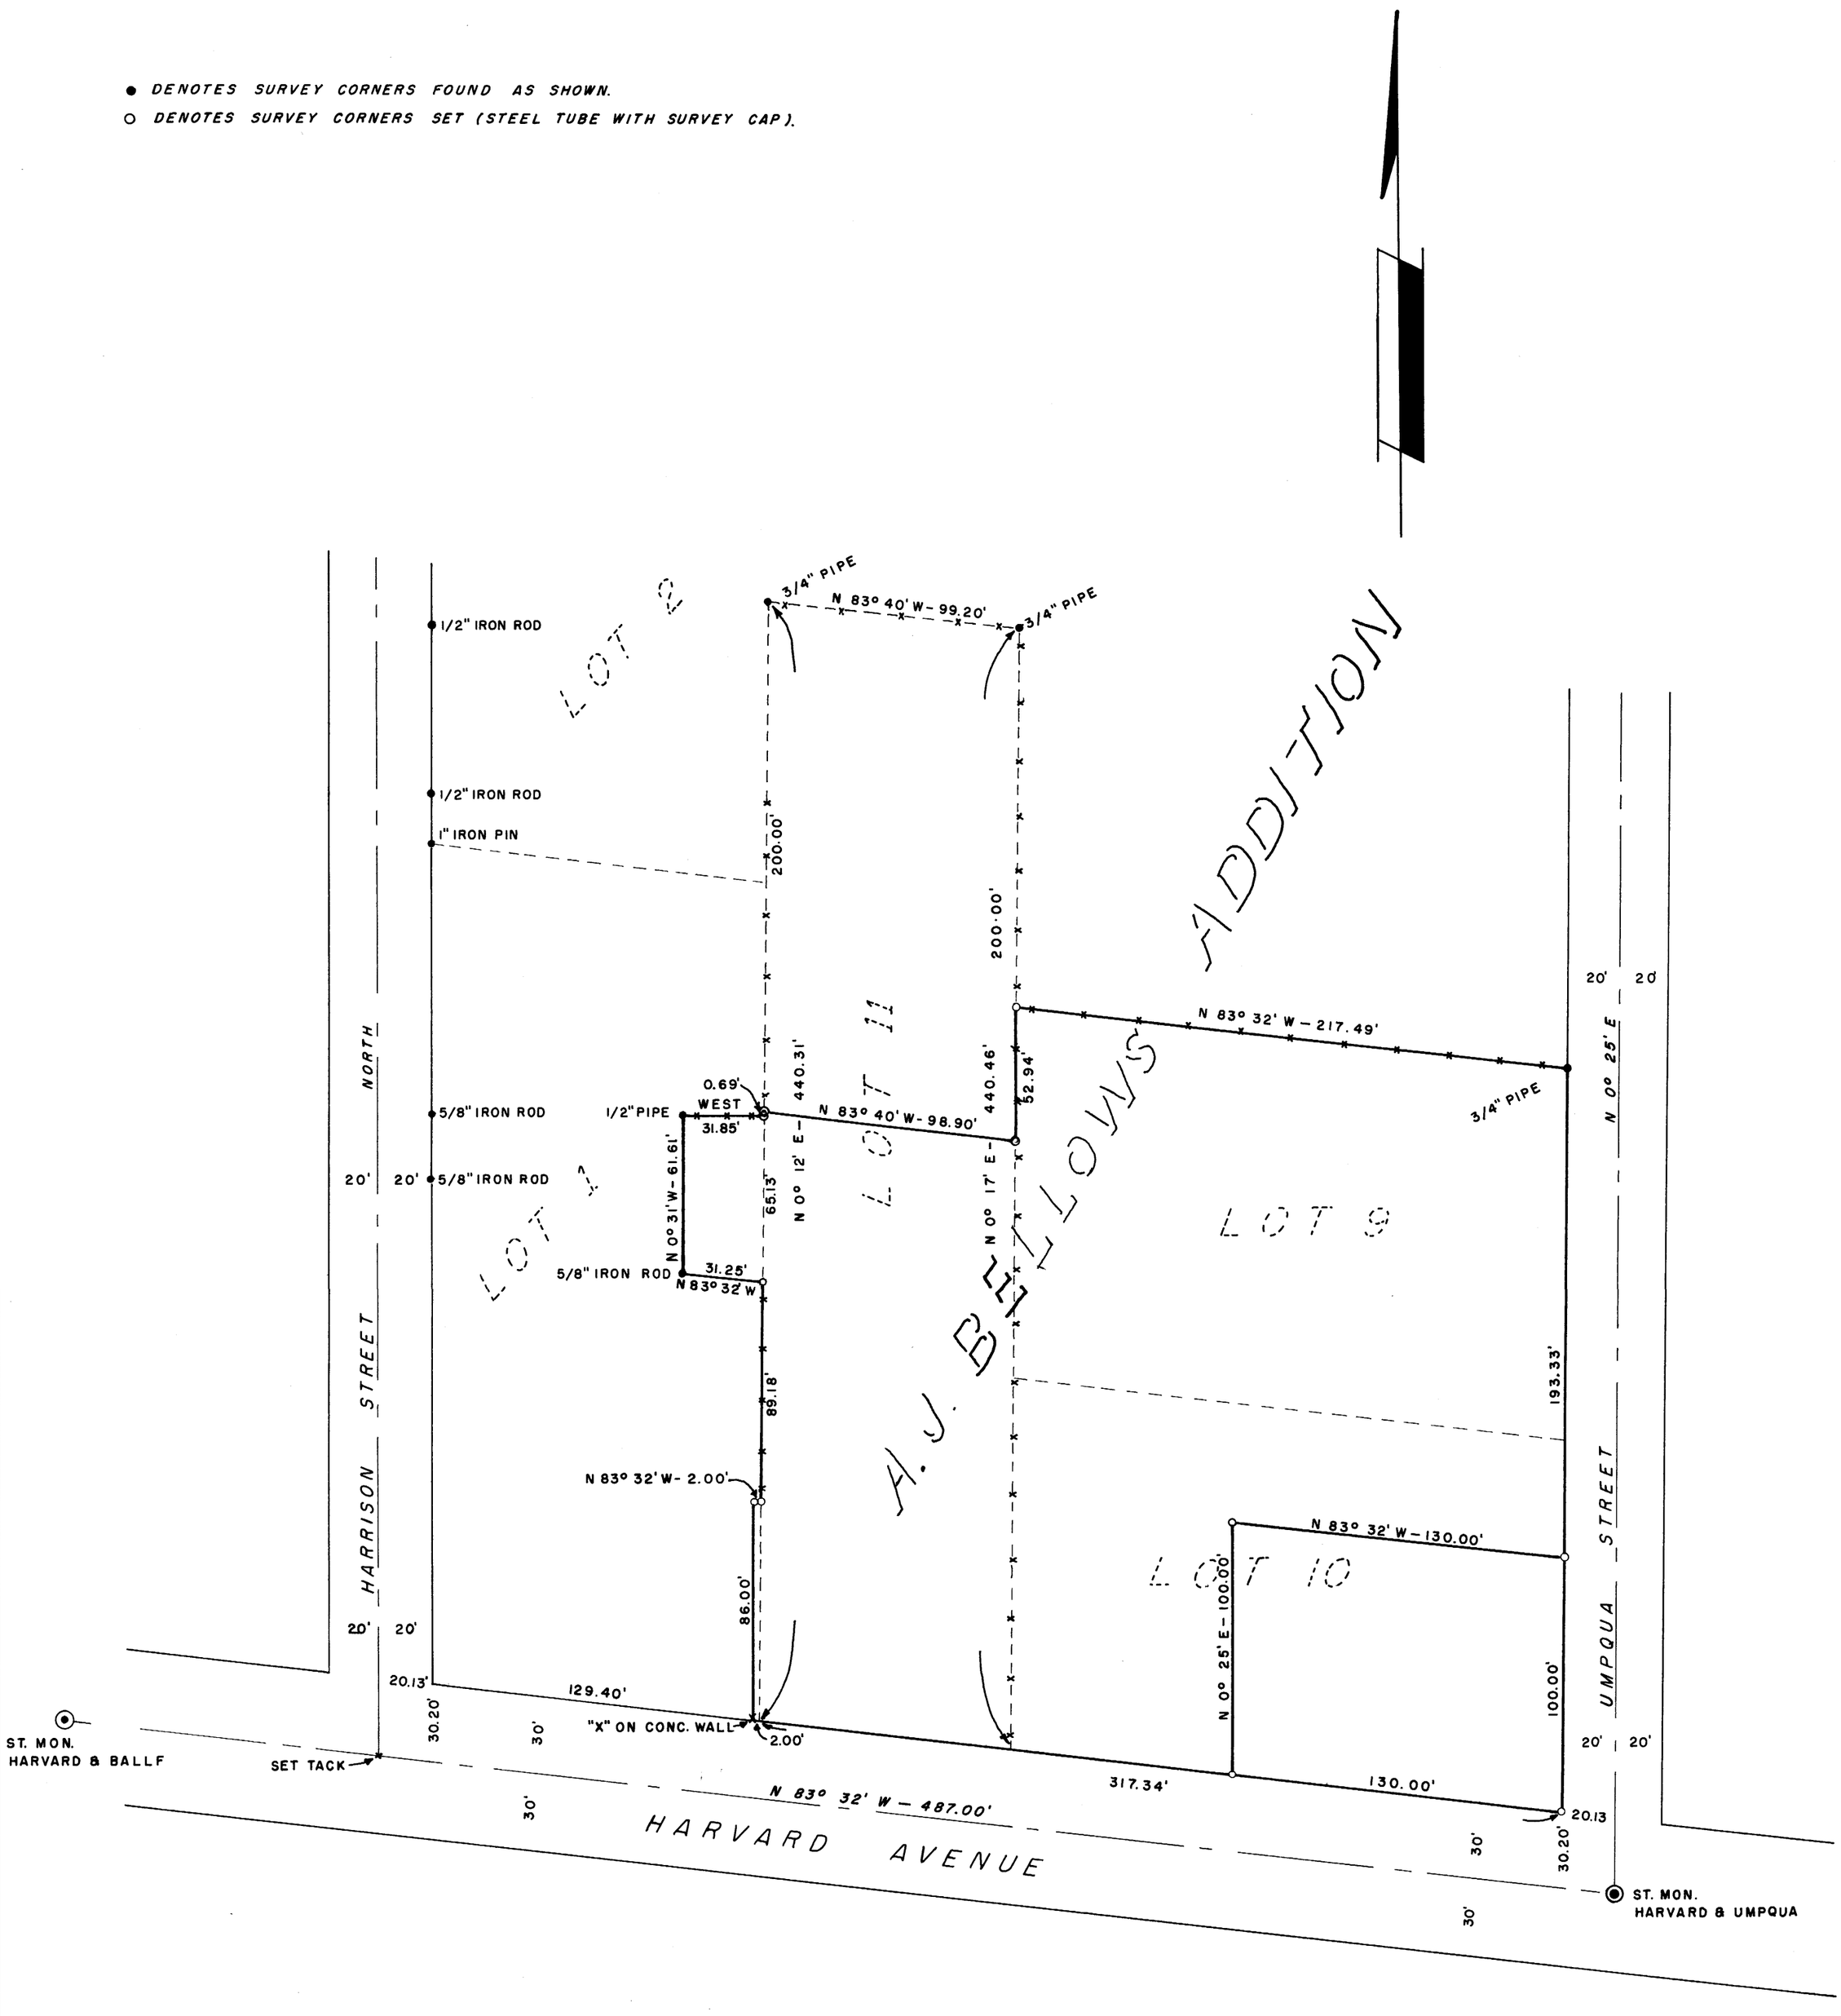

FILED
RECEIVED
JAN 1960
COUNTY SURVEYOR
DOUGLAS COUNTY, ORE.

REGISTERED PROFESSIONAL ENGINEER 4079 OREGON OCT. 15, 1956 ROBERT LECKLIDER

Robert Lecklider

MAP FILE M 17 - 1