MAP FILE M 17 - 11

COUNTY SURVEYORS FILE DATA
DO NOT REMOVE FROM [illegible]

SURVEY TO ESTABLISH PROPERTY CORNERS
J. HUNTLEY D.L.C. NO. 56, SEC. 24, T27S, R6W, W.M.

SURVEYED FOR: H. L. HANDY
SURVEYED BY: G. R. LECKLIDER – ENG'R.

JANUARY, 1960
SCALE: 1" = 60'

● Denotes survey corners found.
○ Denotes steel tube with survey cap set.

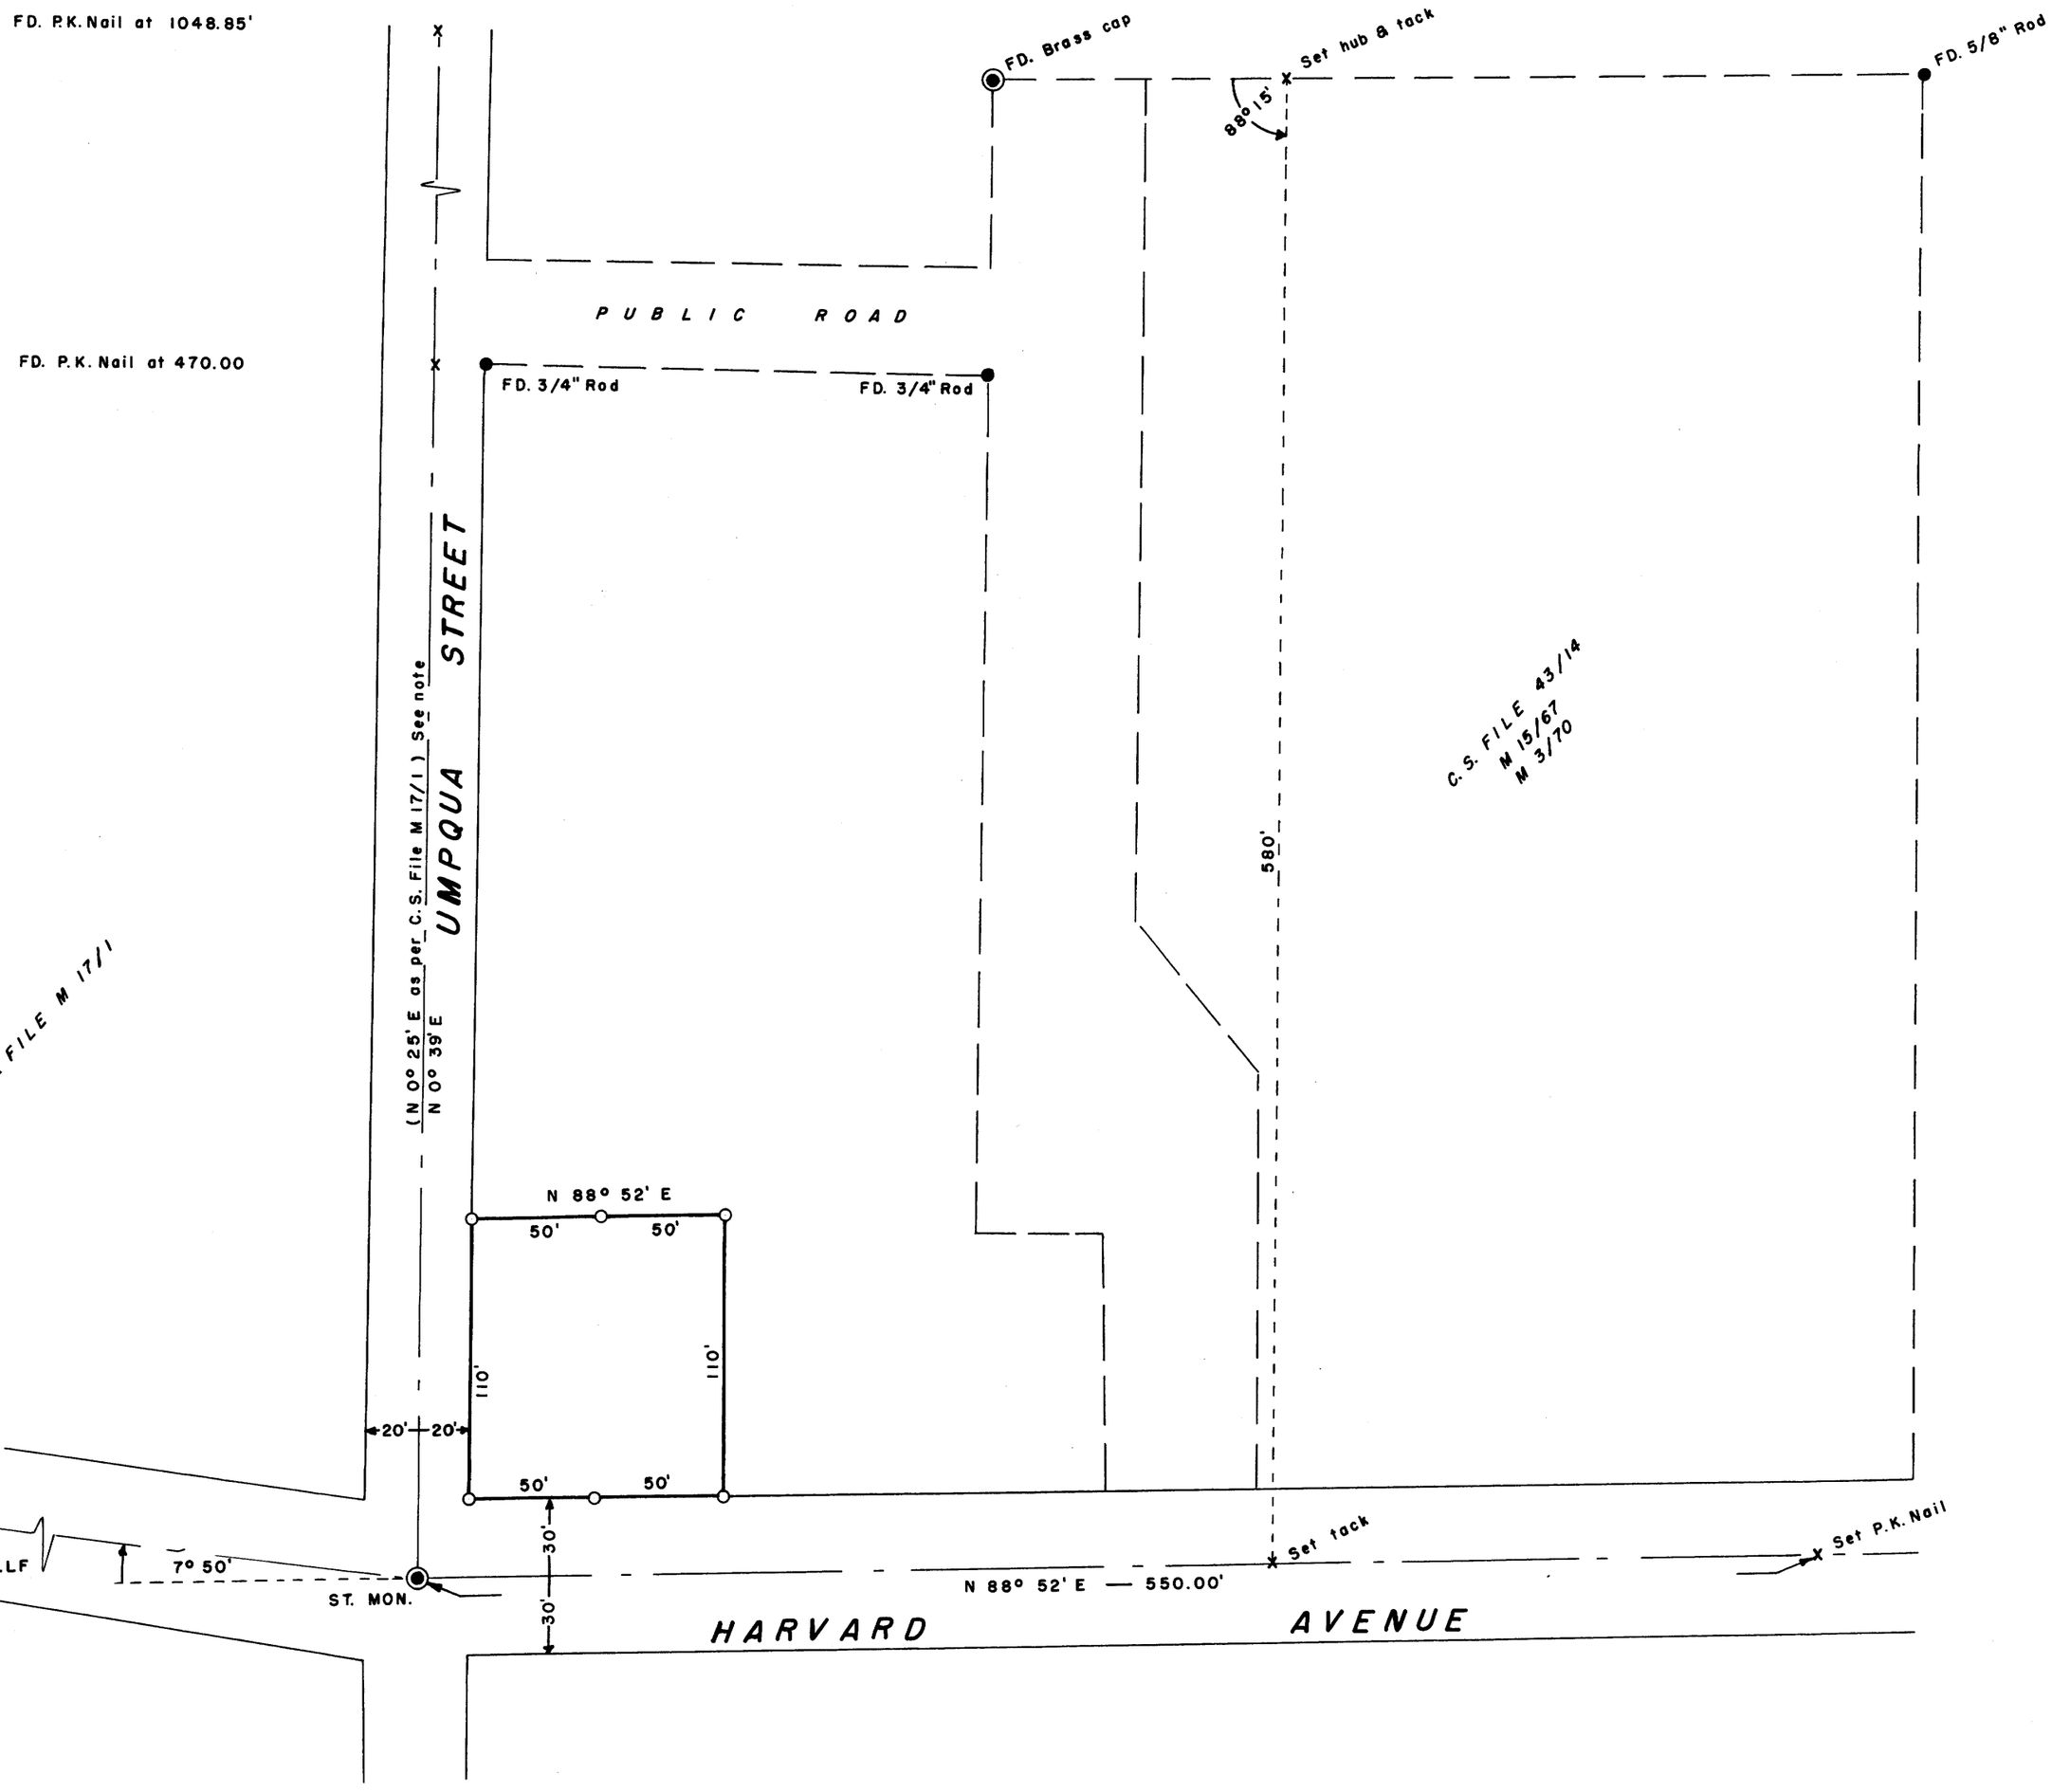

NOTE: Using the centerline of Harvard Avenue westerly (N 83° 32' W) as base of bearings the bearing of Umpqua Street is N 0° 25' E.
" " " " " " easterly (N 88° 52' E) " " " " " " " " " " N 0° 39' E.

REGISTERED PROFESSIONAL ENGINEER
4079
OREGON
OCT. 15, 1956
G. ROBERT LECKLIDER

Robert Lecklider

FILED
RECEIVED
FEB 2 1970
COUNTY SURVEYOR
DOUGLAS COUNTY, ORE.

MAP FILE M 17 - 11