M17-3

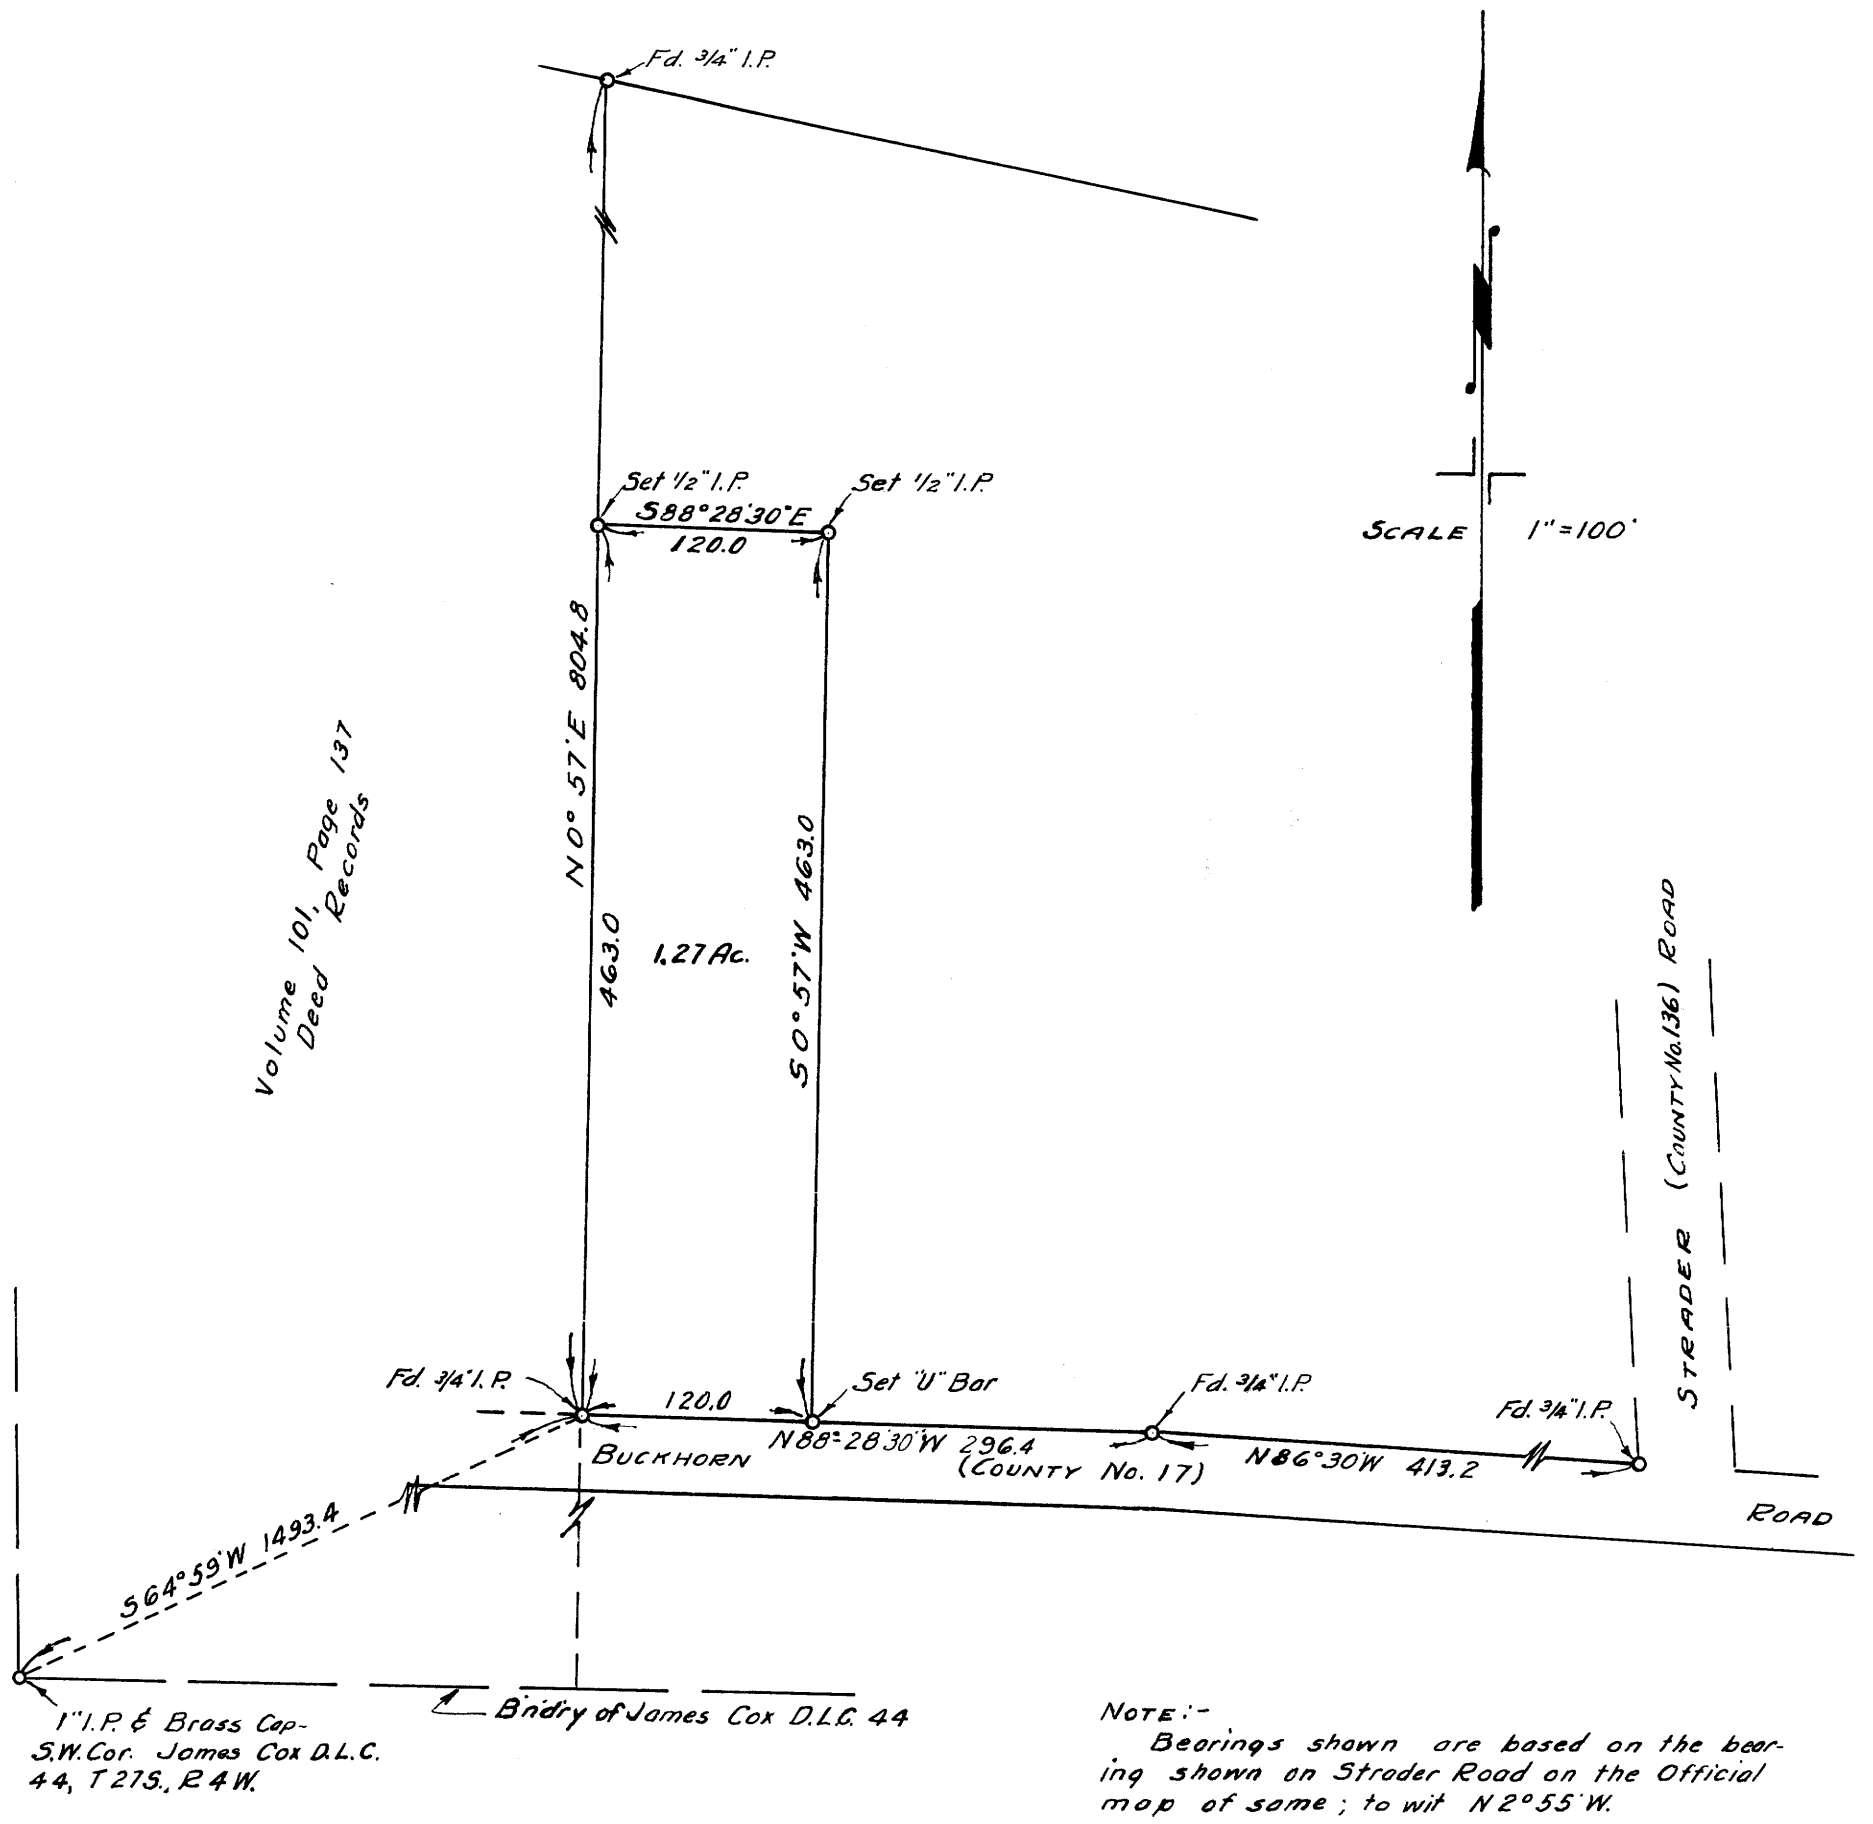

NOTE:-
Bearings shown are based on the bearing shown on Strader Road on the Official map of same; to wit N2°55'W.

COUNTY SURVEYOR'S OFFICE
DOUGLAS COUNTY, OREGON

SURVEY FOR DEED DESCRIPTION,
PORTION OF JAMES COX D.L.C.
44, SECTION 20, T27S., R4W., W.M.

REGISTERED
OREGON
LAND SURVEYOR

N.E. Richardson
JULY 7, 1944
N. E. RICHARDSON
35

BEN. B. IRVING COUNTY SURVEYOR
SURVEYED OCT. 28, 1949 BY
N.E. RICHARDSON DEPUTY

COUNTY SURVEYORS FILE
DO NOT REMOVE FROM OFFICE

M17-3
FILE 53 DRAWER 43