FILED
RECEIVED

MAR 11 1960

COUNTY SURVEYOR
DOUGLAS COUNTY, ORE.

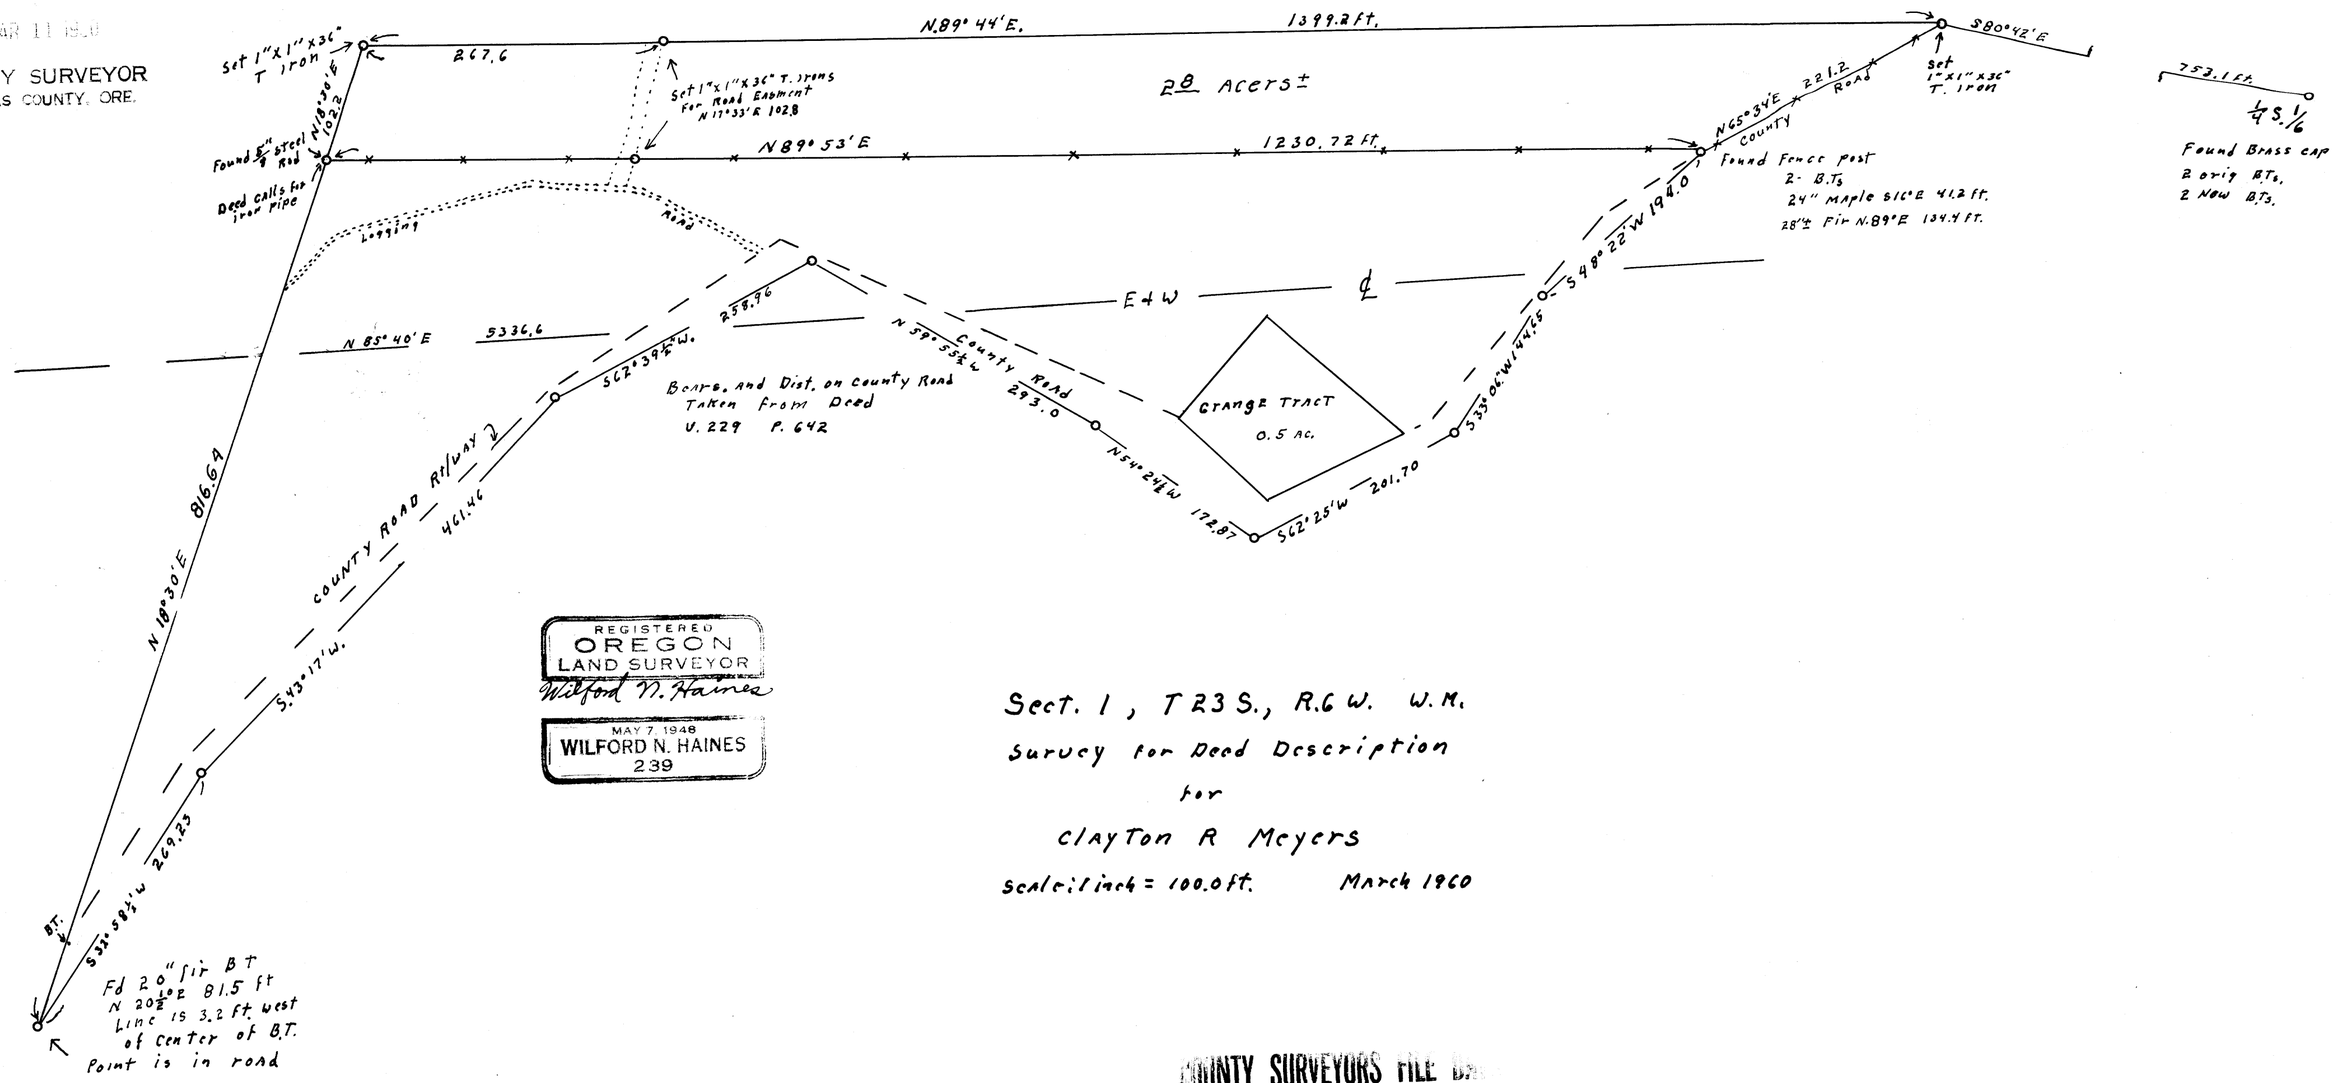

REGISTERED
OREGON
LAND SURVEYOR
Wilford N. Haines
MAY 7, 1948
WILFORD N. HAINES
239

Sect. 1, T 23 S., R.6 W. W.M.
Survey for Deed Description
for
Clayton R Meyers
Scale: 1 inch = 100.0 ft. March 1960

COUNTY SURVEYORS FILE DA
DO NOT REMOVE FROM OFFI

M17-46 P.

MAP FILE M.17-46