MAP FILE M 18 - 1

COUNTY SURVEYORS FILE DATA
DO NOT REMOVE FROM OFFICE

# SURVEY TO SET PROPERTY CORNERS IN BLOCK 25, OF AMENDED PLAT OF THE TOWNSITE OF SUTHERLIN, DOUG. CTY. ORE.

SURVEYED FOR: STANDARD OIL CO. MARCH, 1960

SURVEYED BY: G. R. LECKLIDER - ENGINEER SCALE: 1" = 40'

REGISTERED PROFESSIONAL ENGINEER 4079 OREGON OCT. 15, 1956 ROBERT LECKLIDER

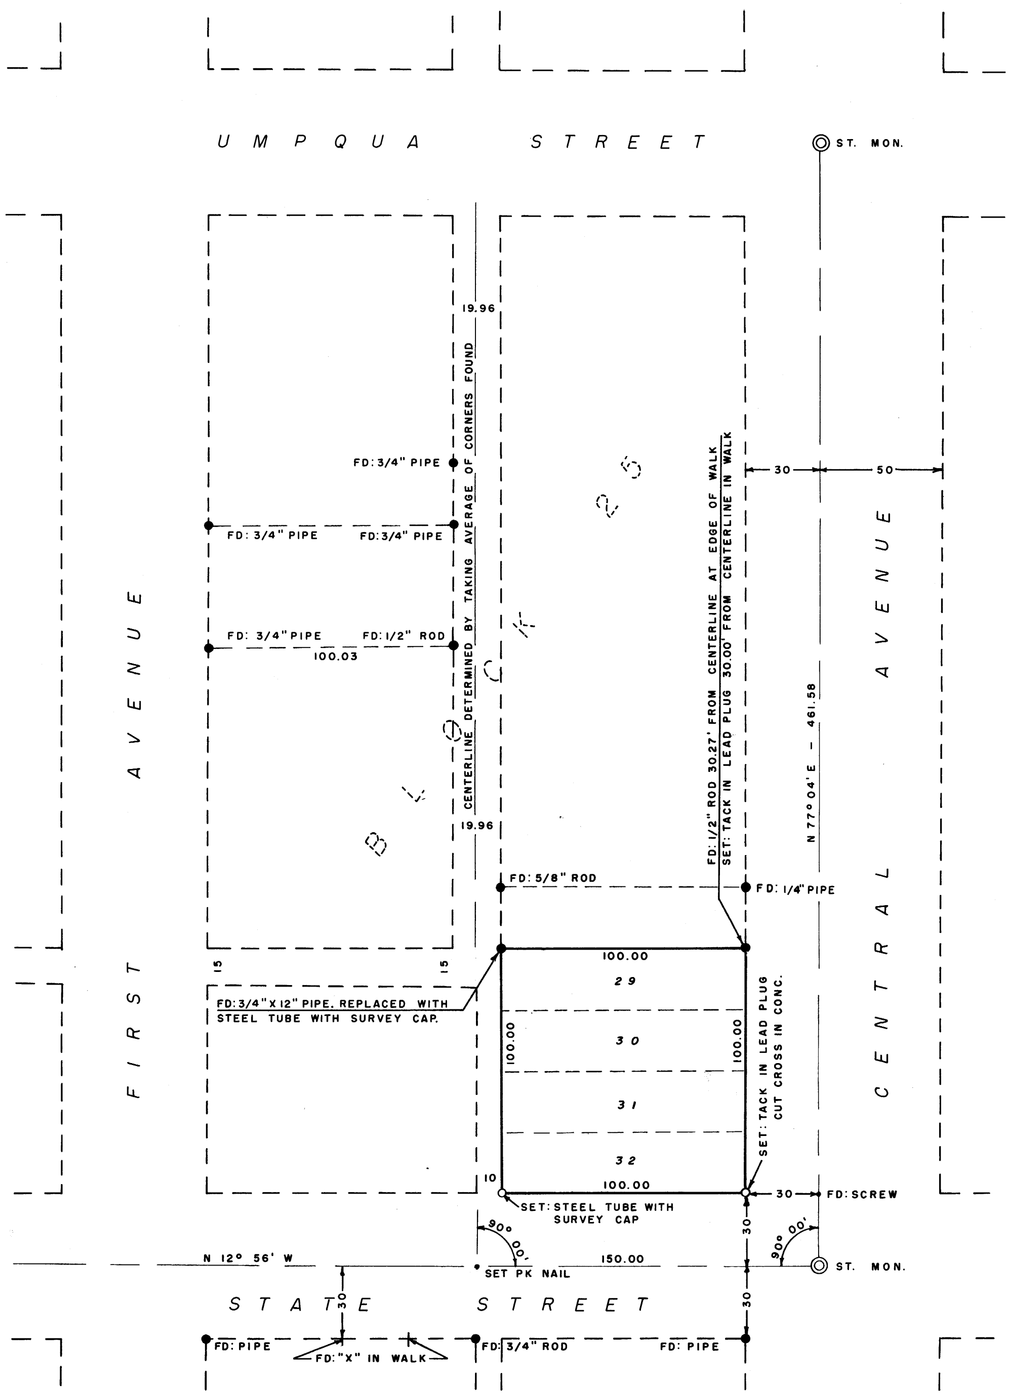


FILED
RECEIVED
MAR 30 1960
COUNTY SURVEYOR
DOUGLAS COUNTY, ORE.

MAP FILE M18 - 1