


FILED  
RECEIVED

APR 11 1958

COUNTY SURVEYOR,  
DOUGLAS COUNTY, ORE.

COUNTY SURVEYORS FILE DATA  
DO NOT REMOVE FROM FILE

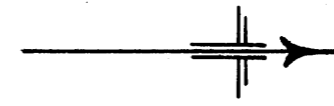

1" IRON ROD

SOUTH

843.76  
N 10°-17'-30"E  
1050.16

UMPQUA RIVER

FLOW →

RIGHT BANK

206.4

SET 1/2" IRON PIPE

N 73°-00'E  
270.0

SET 1" IRON PIPE

EAST  
277.0

S.W. CORNER  
LAZARUS WRIGHT  
D.L.C. No. 45

FOUND →  
2" PIPE & B.T.

WEST ~ 499.1

EAST 600.27

16.98 ACRES

820.6  
3/4" IRON PIPE

N 75°-18'W  
579.5

CALIF. OREGON POWER CO.  
(OVERHANG EASEMENT)

S 14°-42'-30"W  
727.5

CARTEBLAIR SUBDIVISION

INITIAL PT. OF  
THIS SUBDIV.

2" IRON PIPE

N 87°-58'W  
128.2

3/4" IRON BOLT  
190.1

SET 3/4" IRON PIPE

S 15°-02'E  
580.1

390.0

U.S. 99

SET 1/2" IRON BOLT  
IN DAVEWAY

217.0

NORTH  
209.6

SOUTH 586.26

OLD PACIFIC  
HIGHWAY

MRS. NEAL ADAMS  
ROSEBURG, OREGON

SEC. 28 T29S R5W W.M. DOUGLAS COUNTY, OREGON  
JOHN ADAMS D.L.C. No. 41 (MYRTLE CREEK)

SCALE: 1 IN. = 100 FT.

MARTIN ENGINEERING SERVICE - MYRTLE CREEK, OREGON

23 JULY 1958

ADD'NS. MARCH 1960 DR7M FOR ROBERT C. JENKINS

M.P. FILE M 18-13

M 18-13