MAP FILE M18 - 16

COUNTY SURVEYOR'S FILE
DO NOT REMOVE FROM OFFICE

COUNTY SURVEYOR'S OFFICE
DOUGLAS COUNTY OREGON

DEED DESCRIPTIONS
LOTS 9 & 10 AMENDED PLAT DIXON'S ADD'N. TO FRUITVALE

BEN. B. IRVING COUNTY SURVEYOR.
Surveyed Feb. 1946

SCALE 1" = 100'

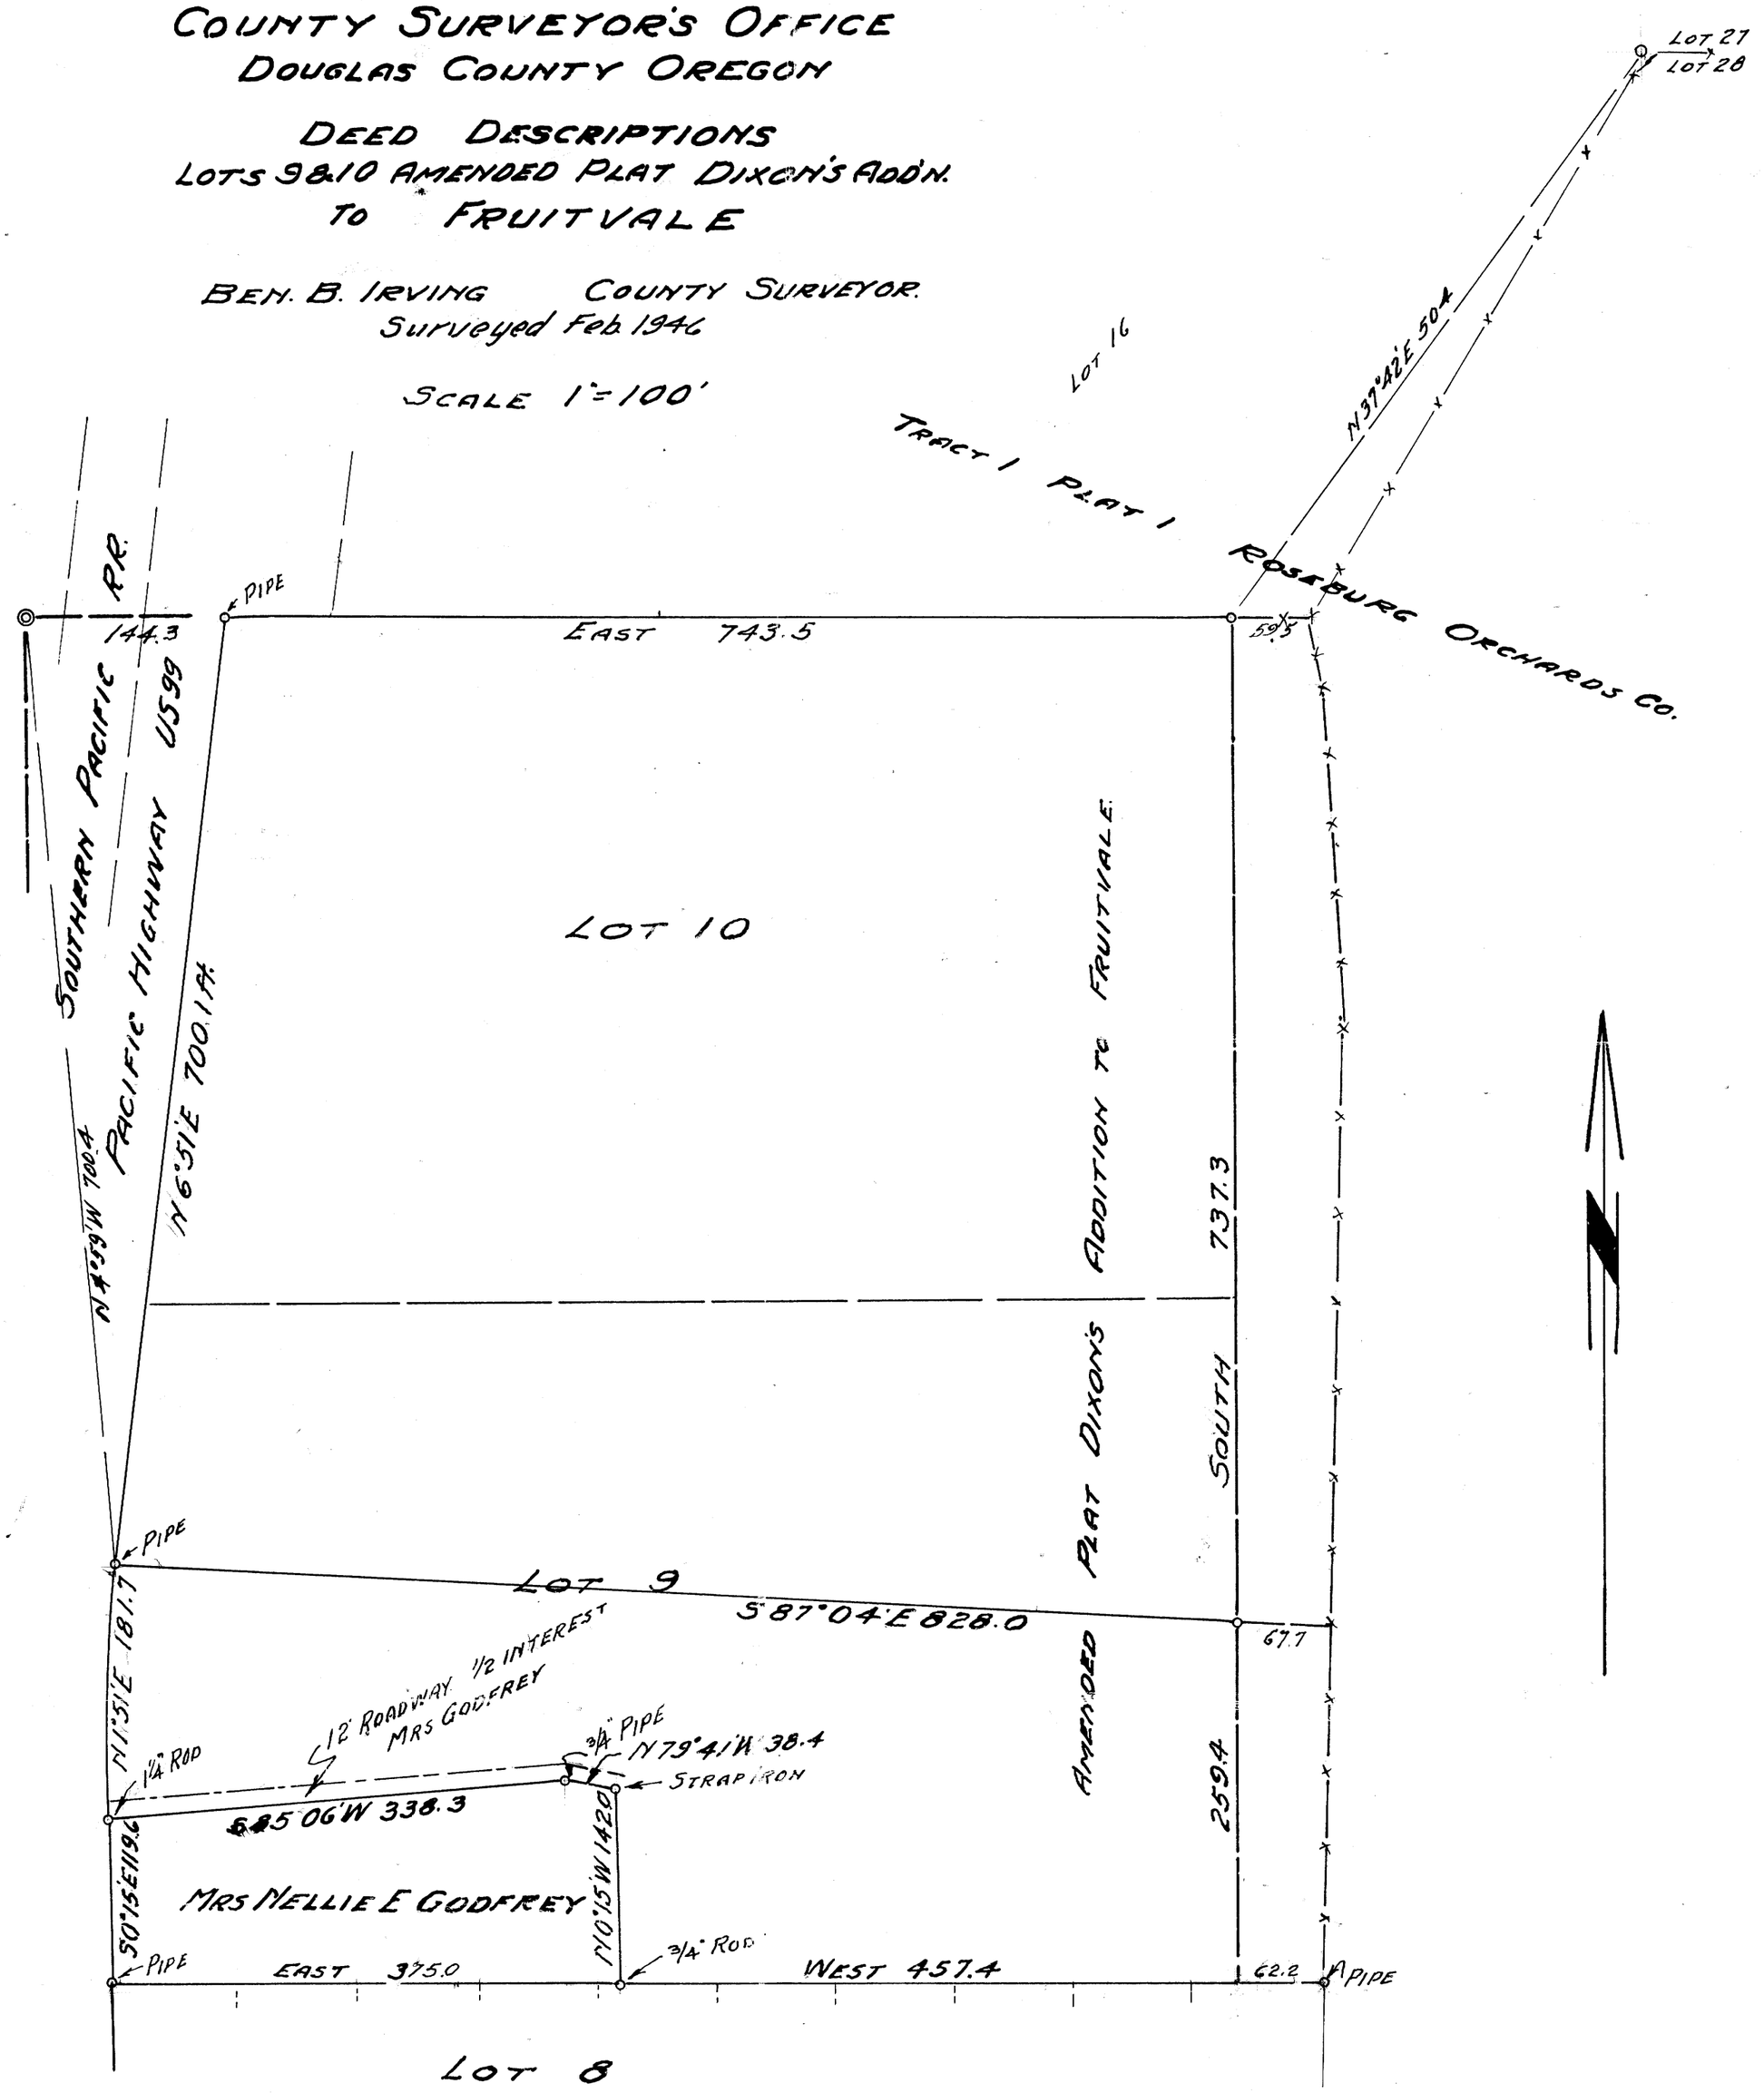

MAP FILE M18-16

FILE 13 DRAWER 39