C.S. FILE 43/65
M18-19

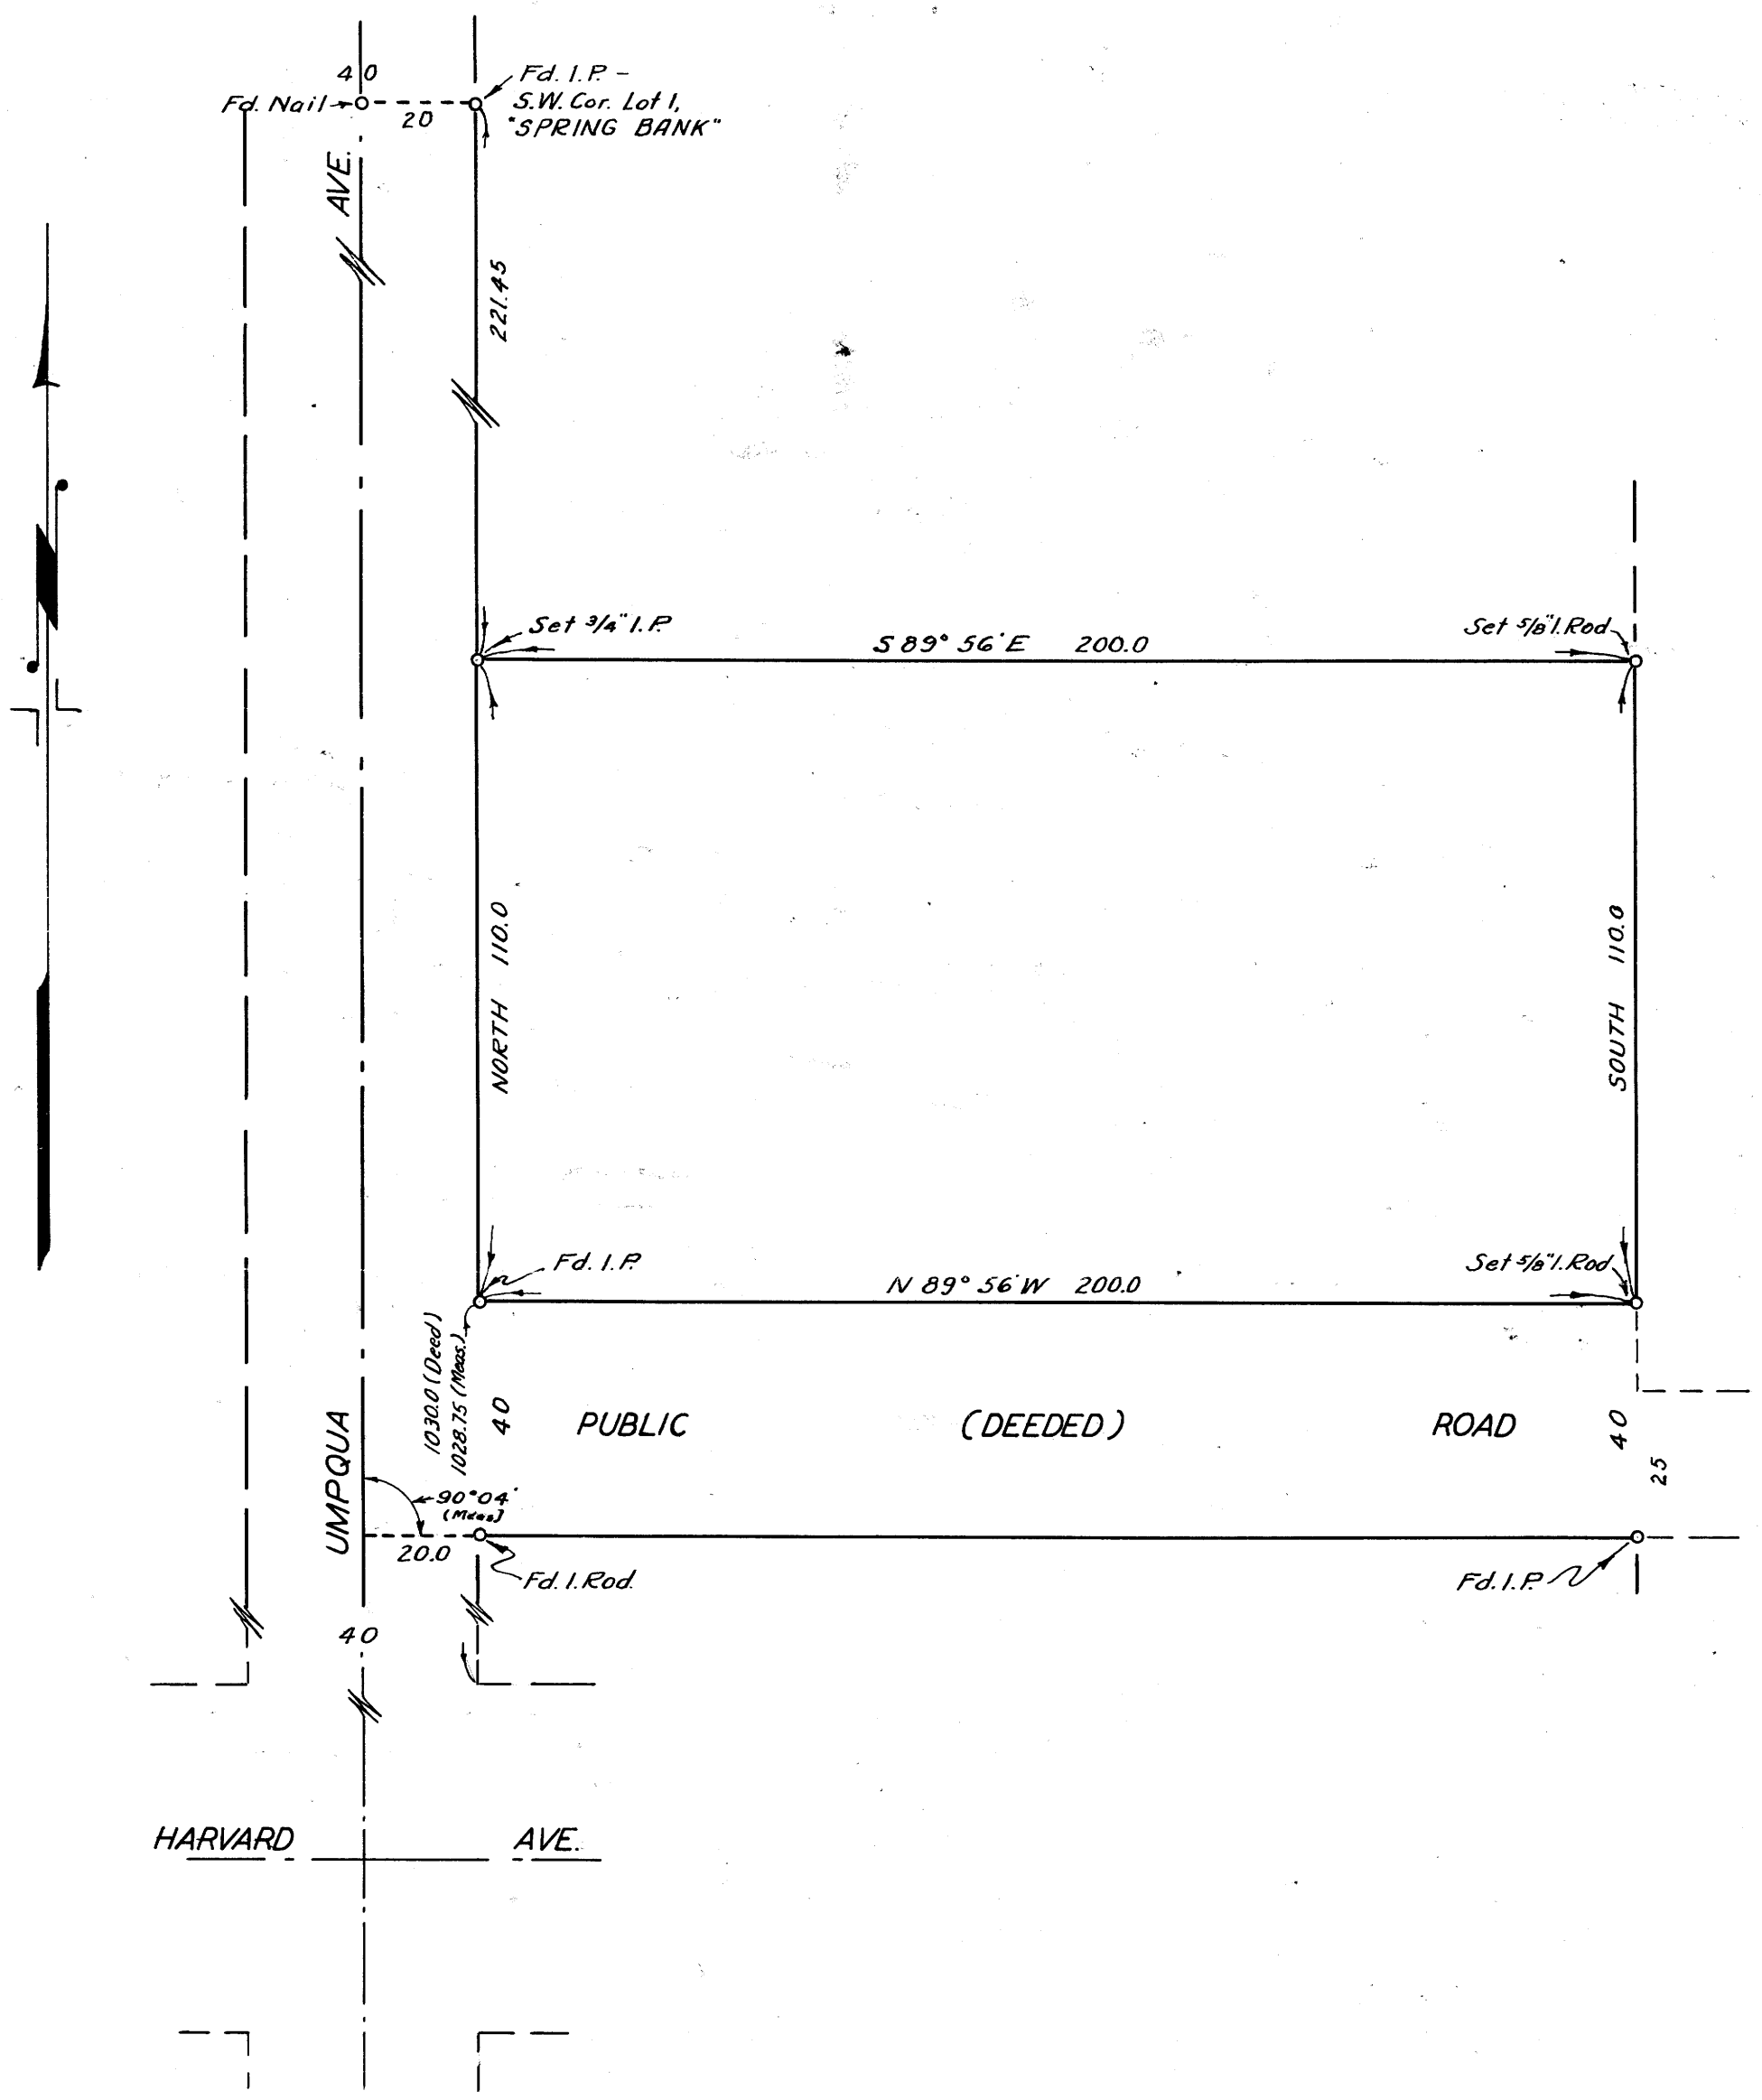

COUNTY SURVEYOR'S OFFICE
DOUGLAS COUNTY, OREGON.

SURVEY TO SET CORNERS
OF PROPERTY

BEN. B. IRVING COUNTY SURVEYOR
SURVEYED JANUARY 25, 1949 BY
N.E. RICHARDSON DEPUTY

N E Richardson

SCALE 1" = 30'

COUNTY SURVEYORS FILE
DO NOT REMOVE FROM OFF

M18-19
FILE 65 DRAWER 43