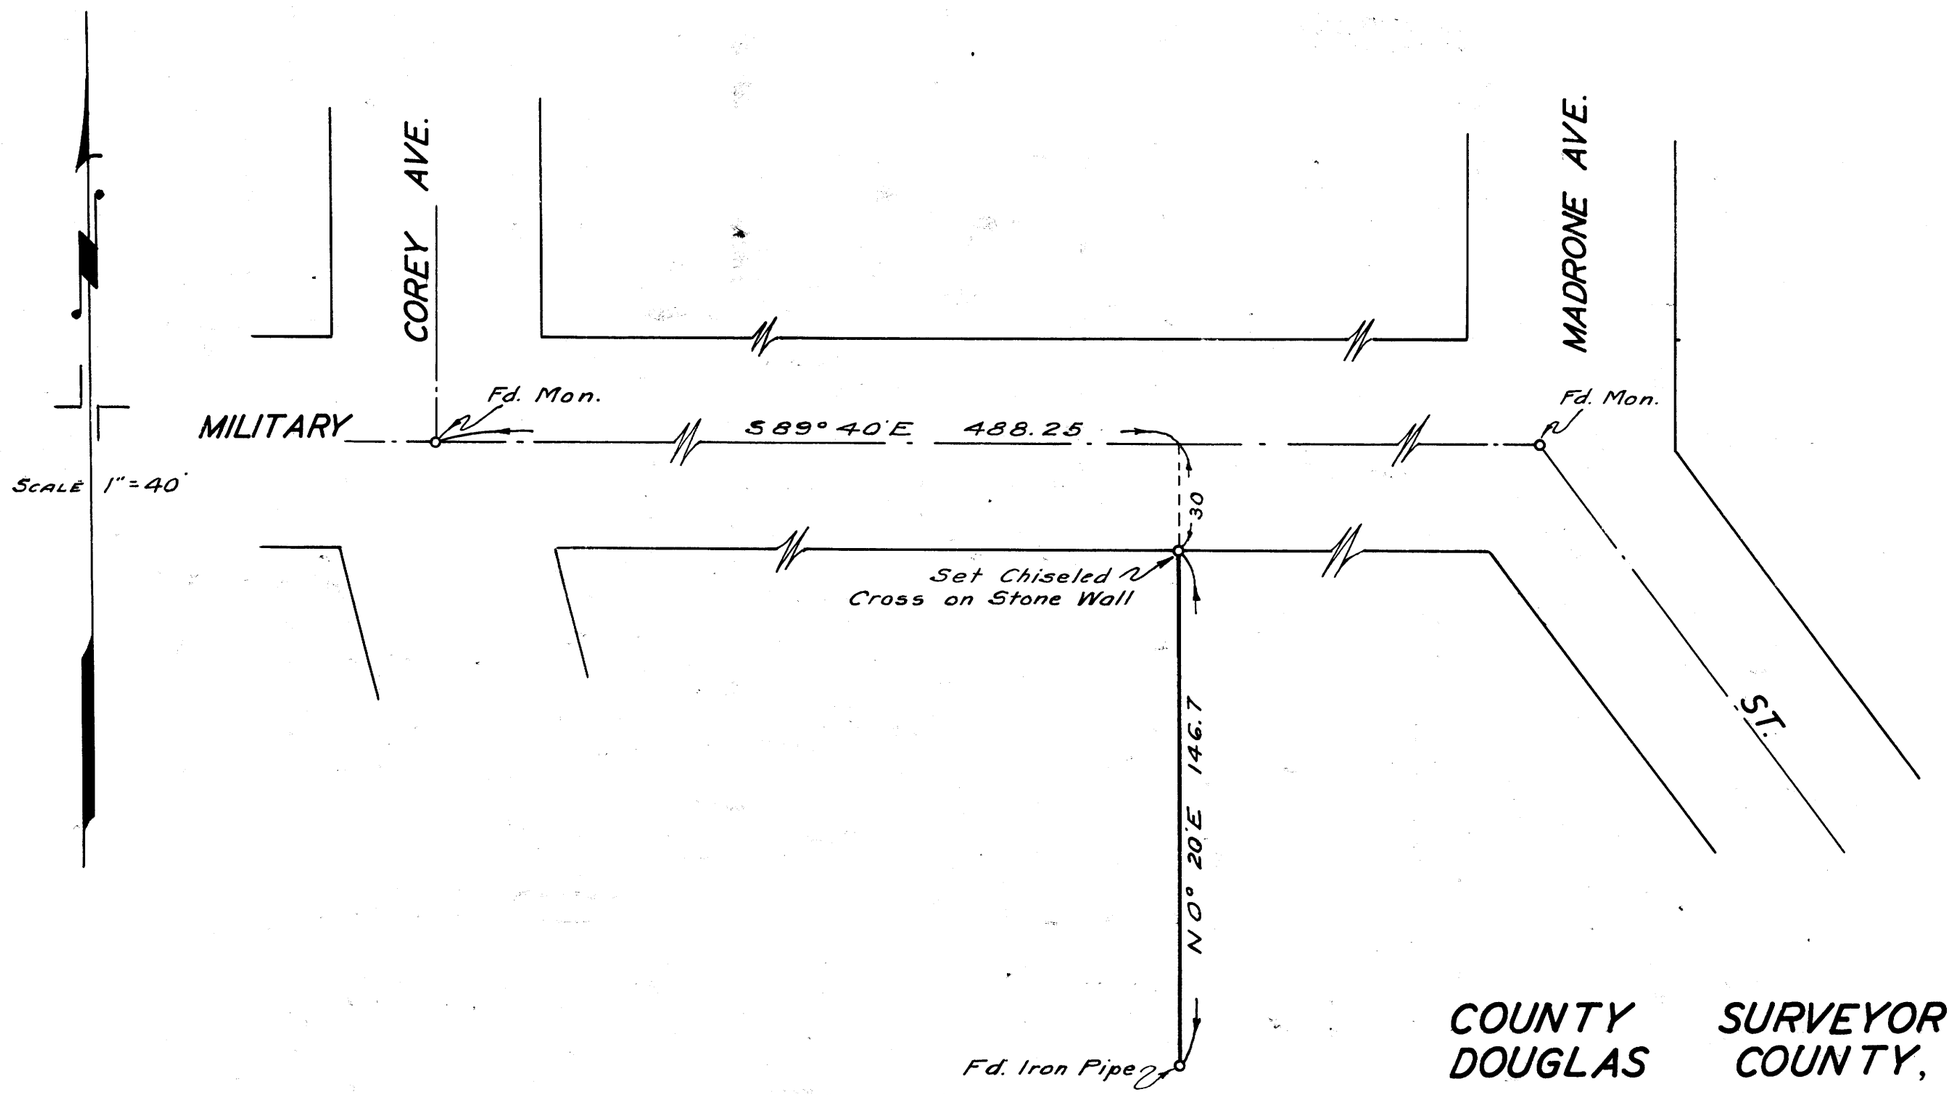

C.S. FILE 39/174
M18-28

COUNTY SURVEYOR'S OFFICE
DOUGLAS COUNTY, OREGON

SURVEY TO ESTABLISH LINE
OF PROPERTY, PER DEED.

BEN. B. IRVING COUNTY SURVEYOR
SURVEYED JUNE 23. 1948 BY N.E. RICHARDSON,
DEPUTY

COUNTY SURVEYORS FILE
DO NOT REMOVE FROM OFFICE

OREGON
LAND SURVEYOR
N.E. Richardson
N.E. RICHARDSON

C.S. FILE 39/174
M18-28