C.S. 39/154
MAP FILE M18 - 46

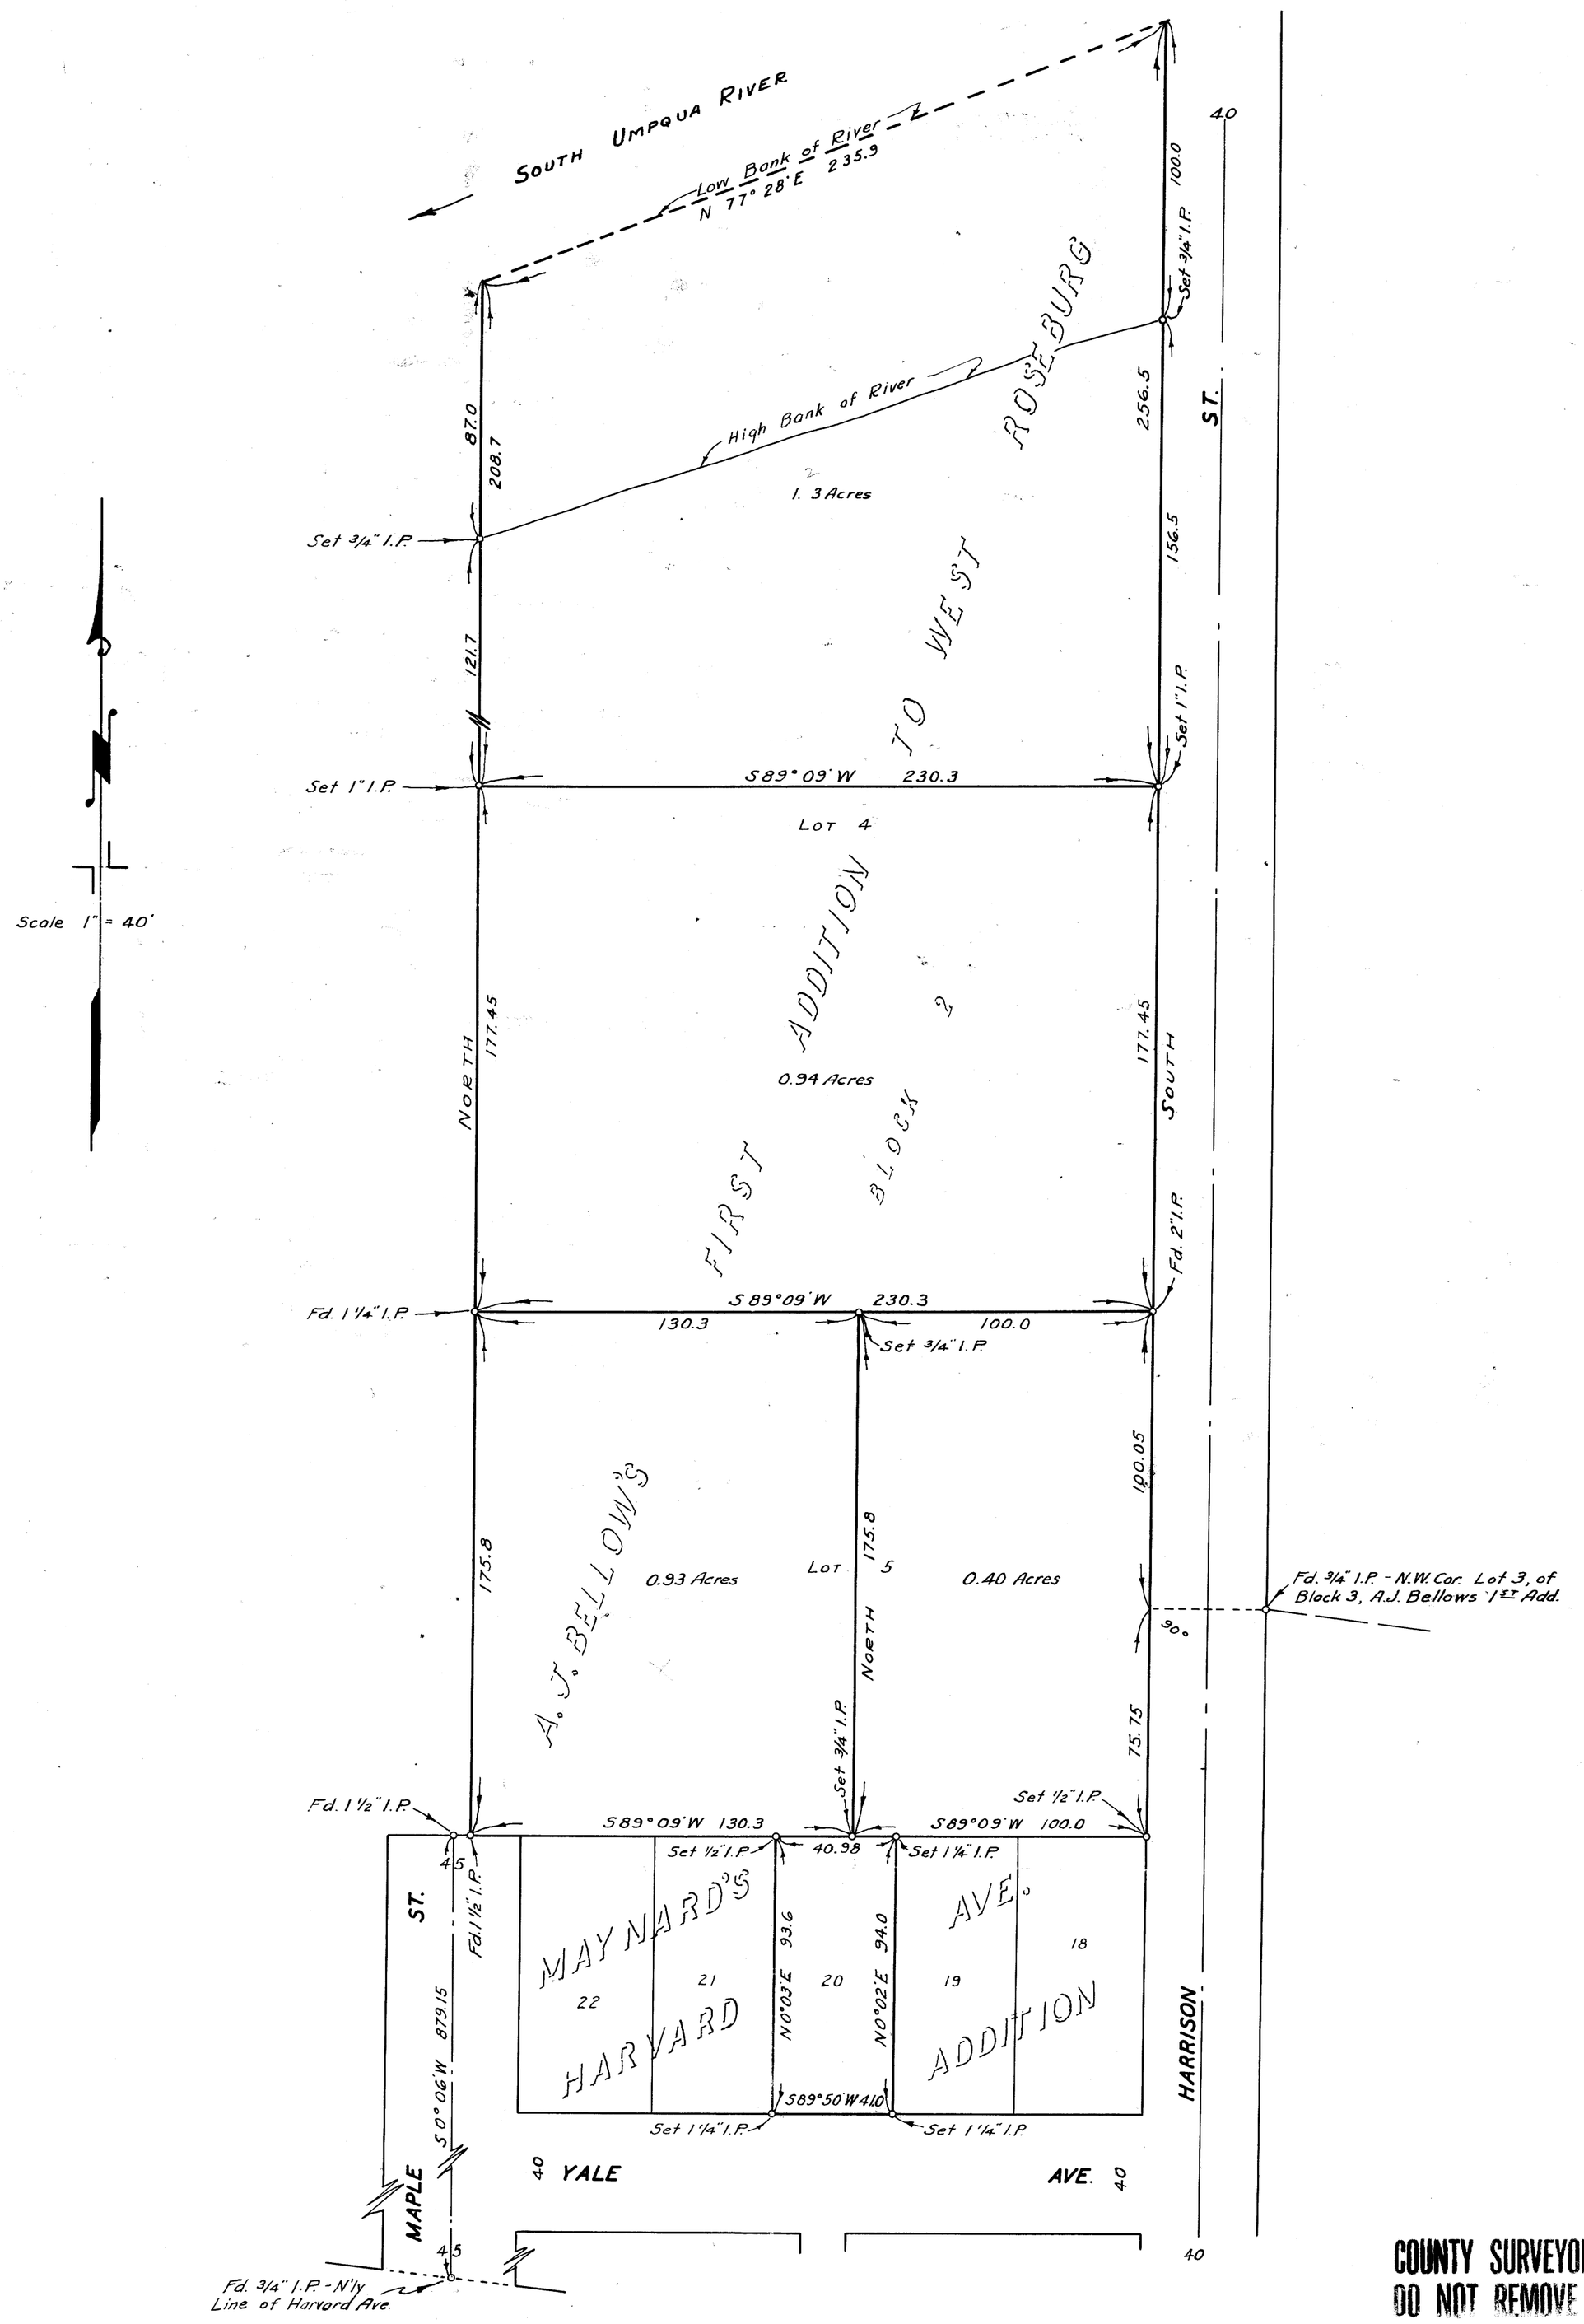

COUNTY SURVEYORS FILE DATA
DO NOT REMOVE FROM OFFICE

REGISTERED PROFESSIONAL ENGINEER 2741 OREGON NOV. 7, 1947 ARTHUR R. EVANS

COUNTY SURVEYOR'S OFFICE
DOUGLAS COUNTY, OREGON

SURVEY FOR DEED DESCRIPTIONS
LOTS 4, 5, BLOCK 2, A. J. BELLOW'S FIRST ADDITION TO WEST ROSEBURG

BEN. B. IRVING COUNTY SURVEYOR
SURVEYED FEBRUARY 1948 BY A.R. EVANS

MAP FILE M 18 - 46