


COUNTY SURVEYOR'S OFFICE  
DOUGLAS COUNTY, OREGON.

SURVEY FOR DEED DESCRIPTION,  
SECTION 9, T27S, R6W.

BEN. B. IRVING COUNTY SURVEYOR  
SURVEYED OCT. 11, 12, 1949 BY  
A.R. EVANS DEPUTY

SCALE 1" = 60'

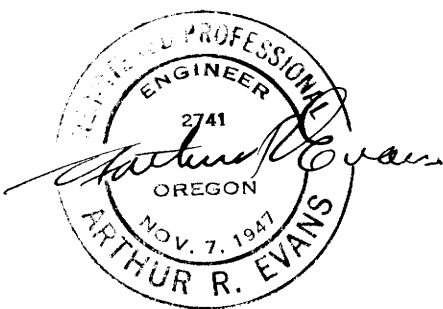

COUNTY SURVEYORS FILE DATA  
DO NOT REMOVE FROM OFFICE


**MAP**  
 SHOWING LOCATION OF  
 RESIDENCE ON & BOUNDARIES OF  
**M. & B. PARCEL, SECTION 9, T 27S., R 6W.**  
 IN THE  
**COUNTY OF DOUGLAS**  
 AND  
**STATE OF OREGON**

**COUNTY SURVEYORS FILE DATA**  
**DO NOT REMOVE FROM OFFICE**

SURVEYED 8-12-49

SCALE 1"=60'

I hereby certify that I have surveyed the above described property and that the improvements shown and described hereon are within the property lines.

  
 Arthur R. Evans  
 Deputy County Surveyor.

