C.S. FILE 52/20
M 18-6

NOTE: BEARINGS BASED ON
N89°01'W, TRUE AS
PER C.S. FILE 30/144

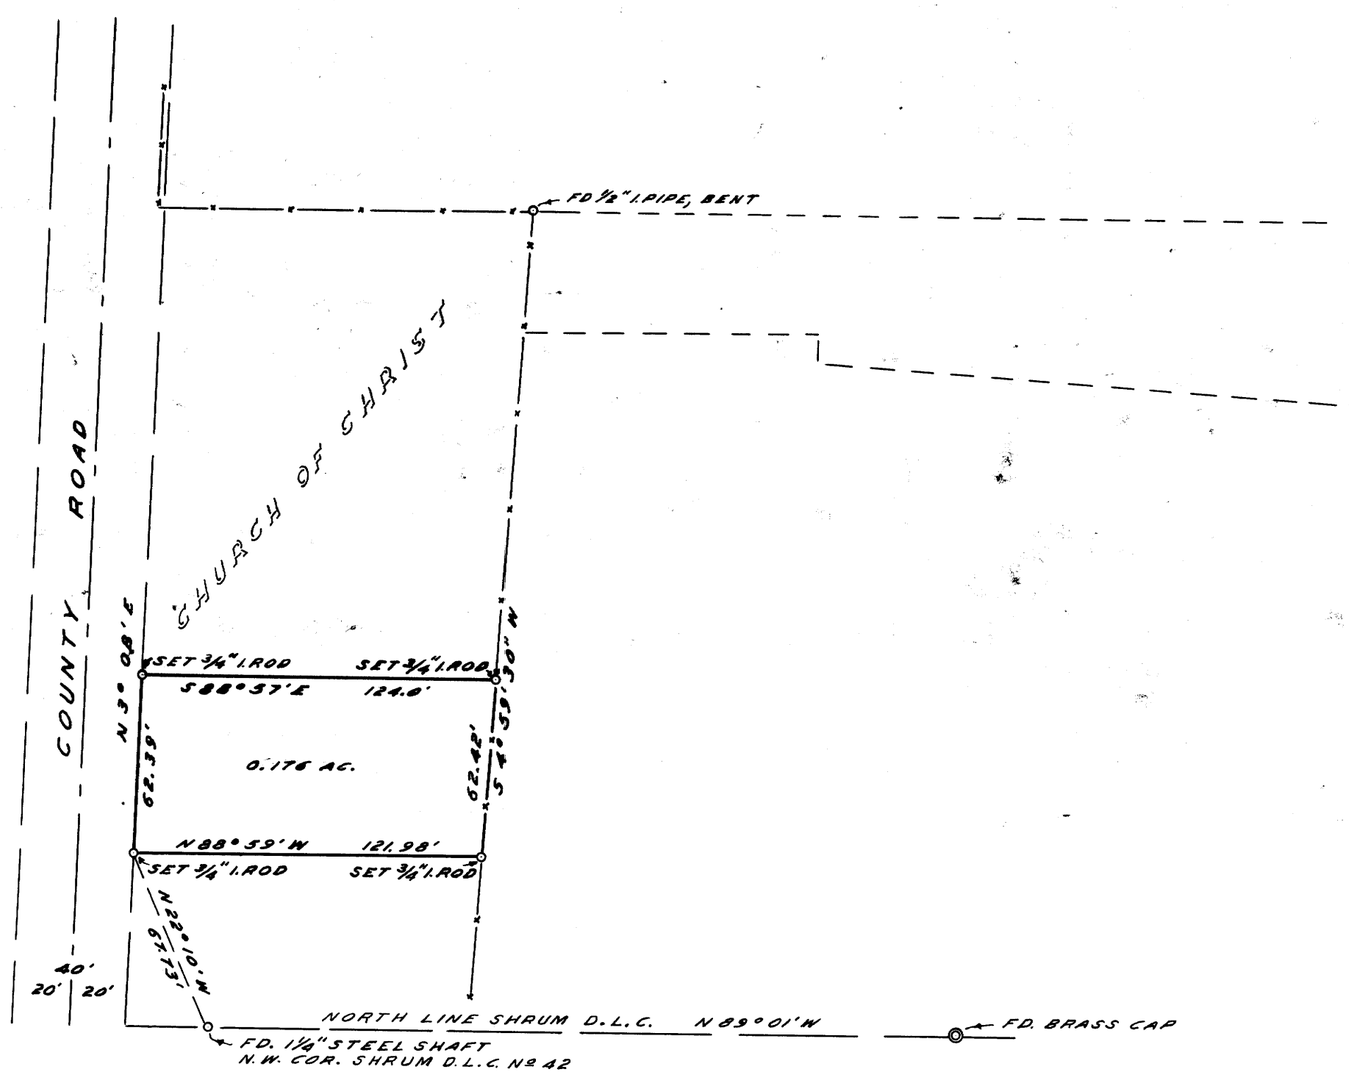

COUNTY SURVEYOR'S OFFICE
DOUGLAS COUNTY, OREGON

SURVEY FOR DEED DESCRIPTION,
SECTION 18, T26S., R3W, W.M.

FRED M. DARBY — COUNTY SURVEYOR
SURVEYED APRIL 5, 1960 — BY
JAMES W. BYRON - DEPUTY — SCALE 1" = 50'
SURVEYED FOR R. H. HOLMES

REGISTERED
OREGON
LAND SURVEYOR
James W. Byron
NOV. 6, 1953
JAMES W. BYRON
303

COUNTY SURVEYORS FILE DATA
DO NOT REMOVE FROM OFFICE

C.S. FILE 52/20
M 18-6