C.S. FILE NO. 46/145
M 18-64

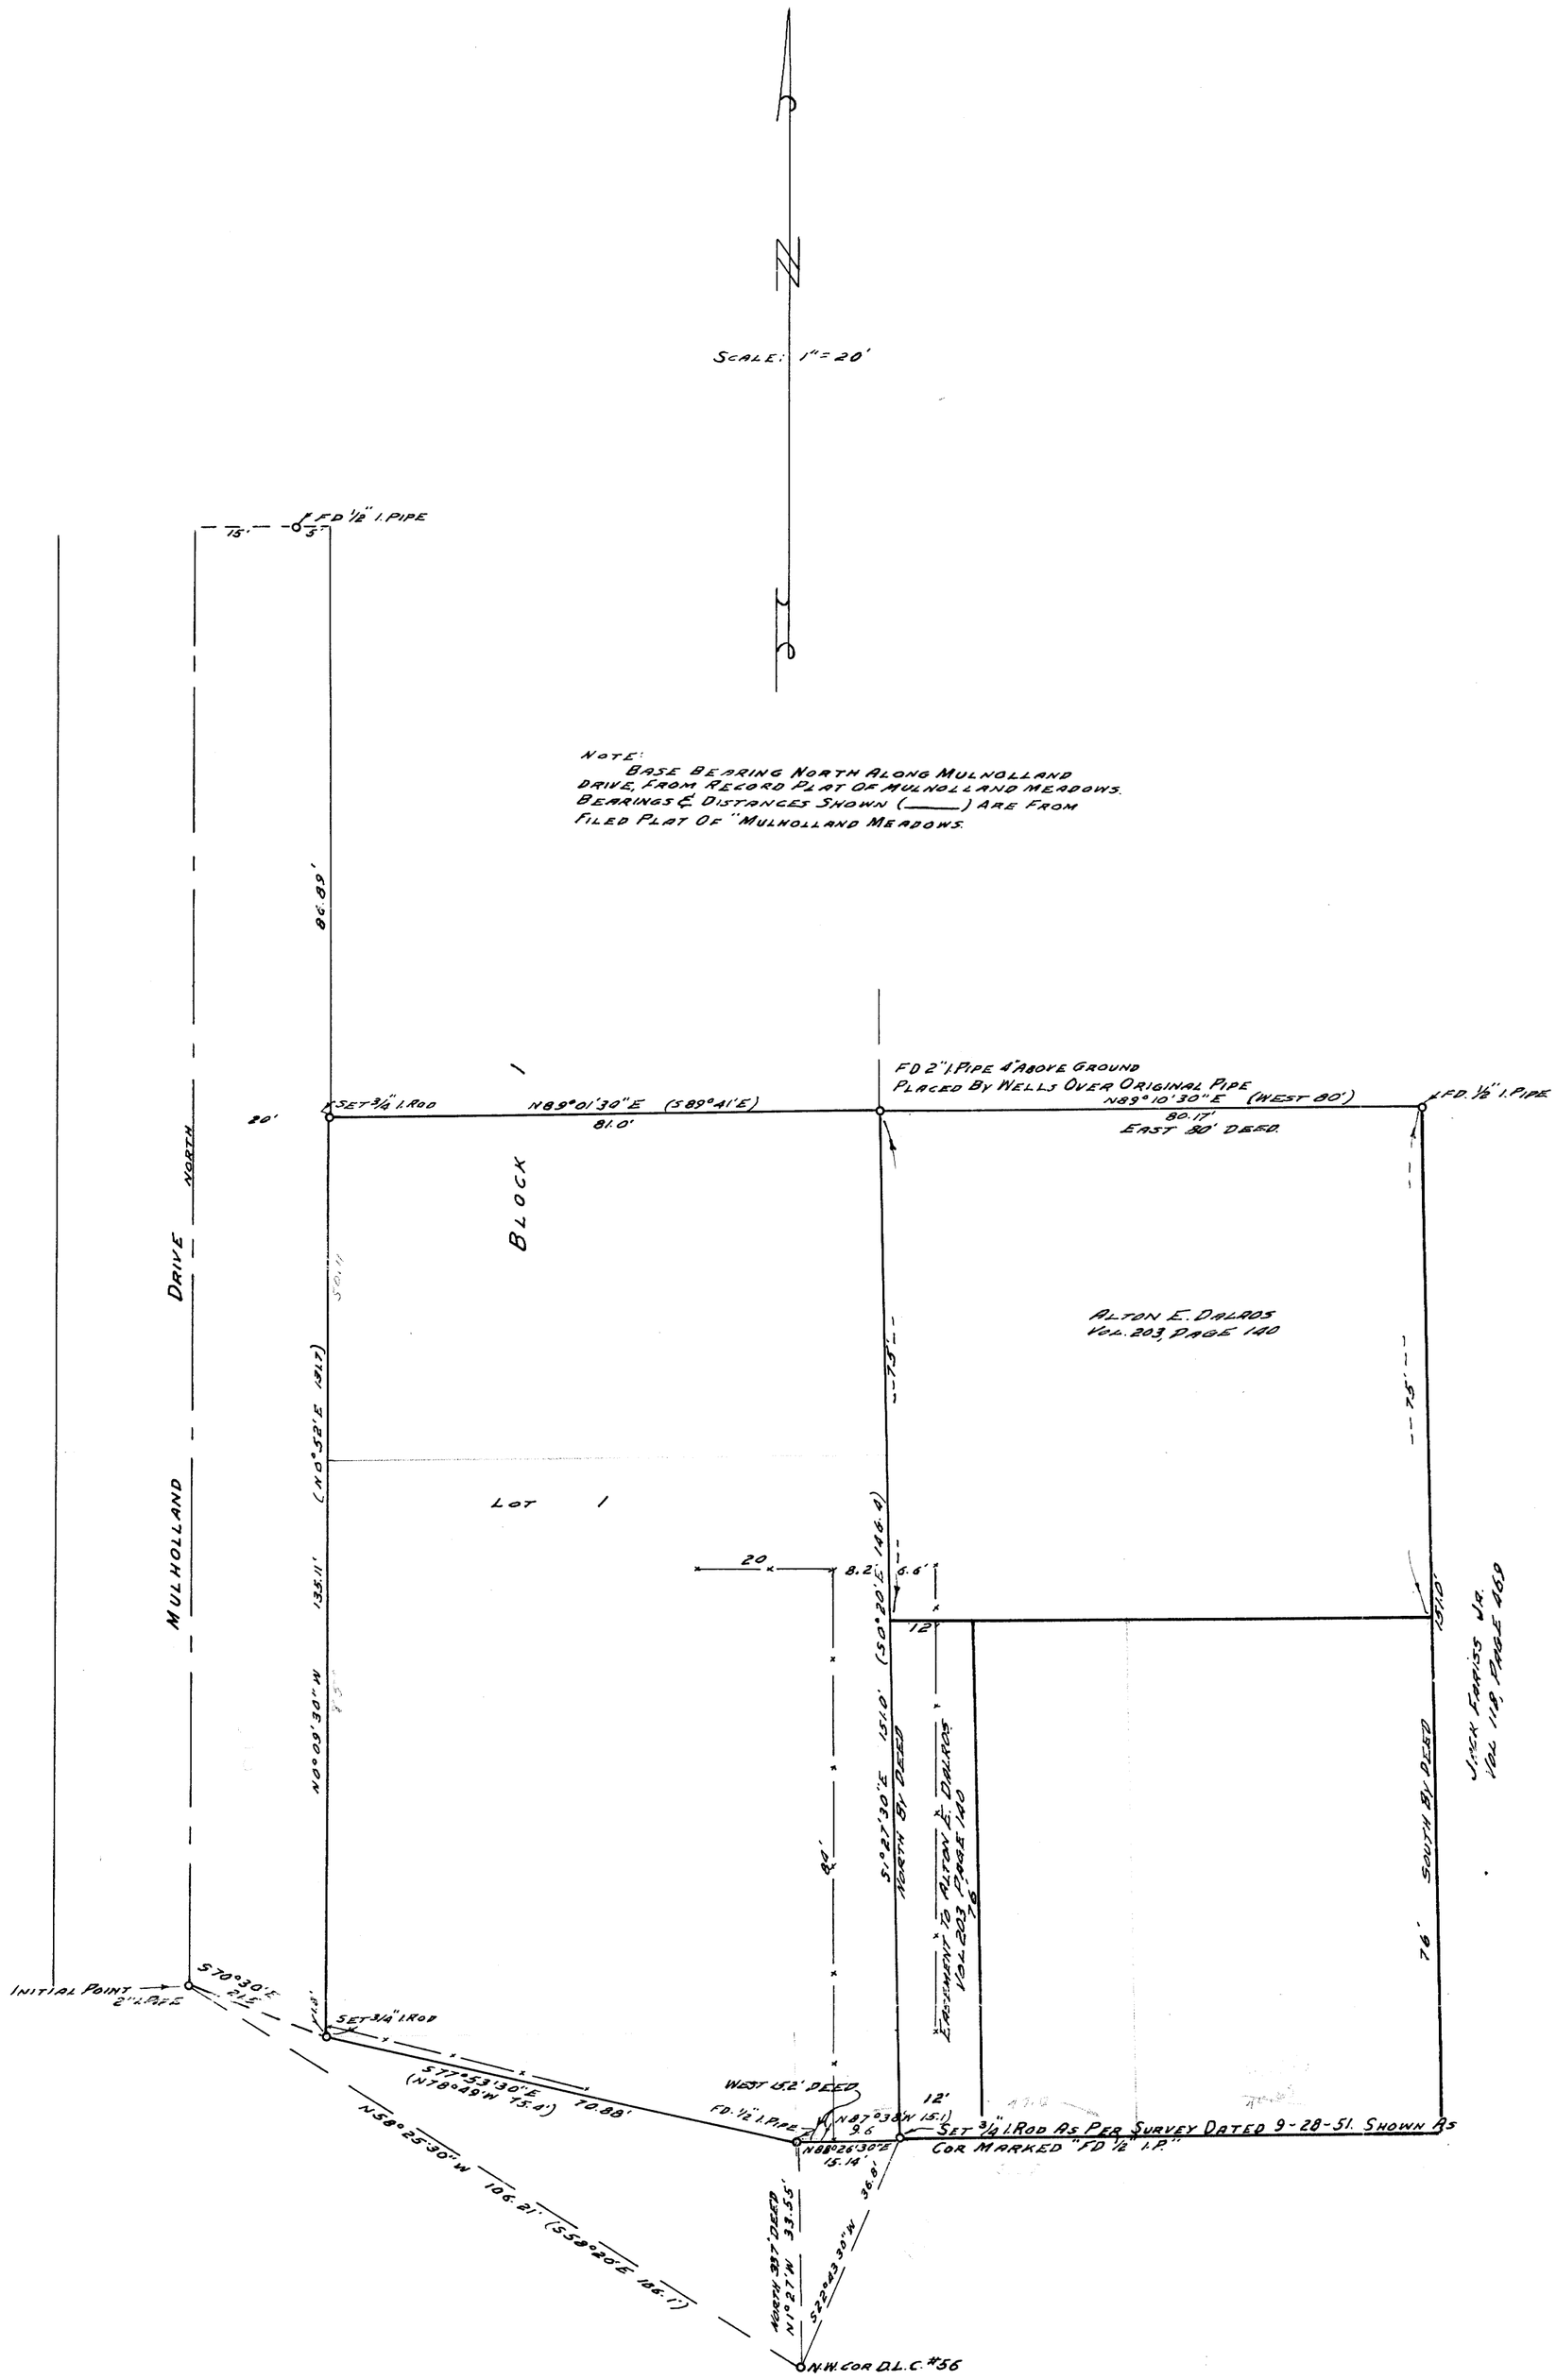

COUNTY SURVEYOR'S OFFICE
DOUGLAS COUNTY OREGON

PLAT OF SURVEY & DEEDS, SEC. 13 T. 27 S., R. 6 W
SEE SURVEYOR'S FILE 45-32 FOR SURVEY

BEN B. IRVING COUNTY SURVEYOR
DRAWN JUNE 23, 1955

COUNTY SURVEYORS FILE DATA
DO NOT REMOVE FROM OFFICE

C.S. FILE 46/145
M 18-64