79-81 W

COUNTY SURVEYOR FILE COPY
DO NOT REMOVE FROM OFFICE

RESURVEY

SECTIONS 19 & 30 T31S R6W W.M.

scale - 1 in. = 500 ft. May 1960

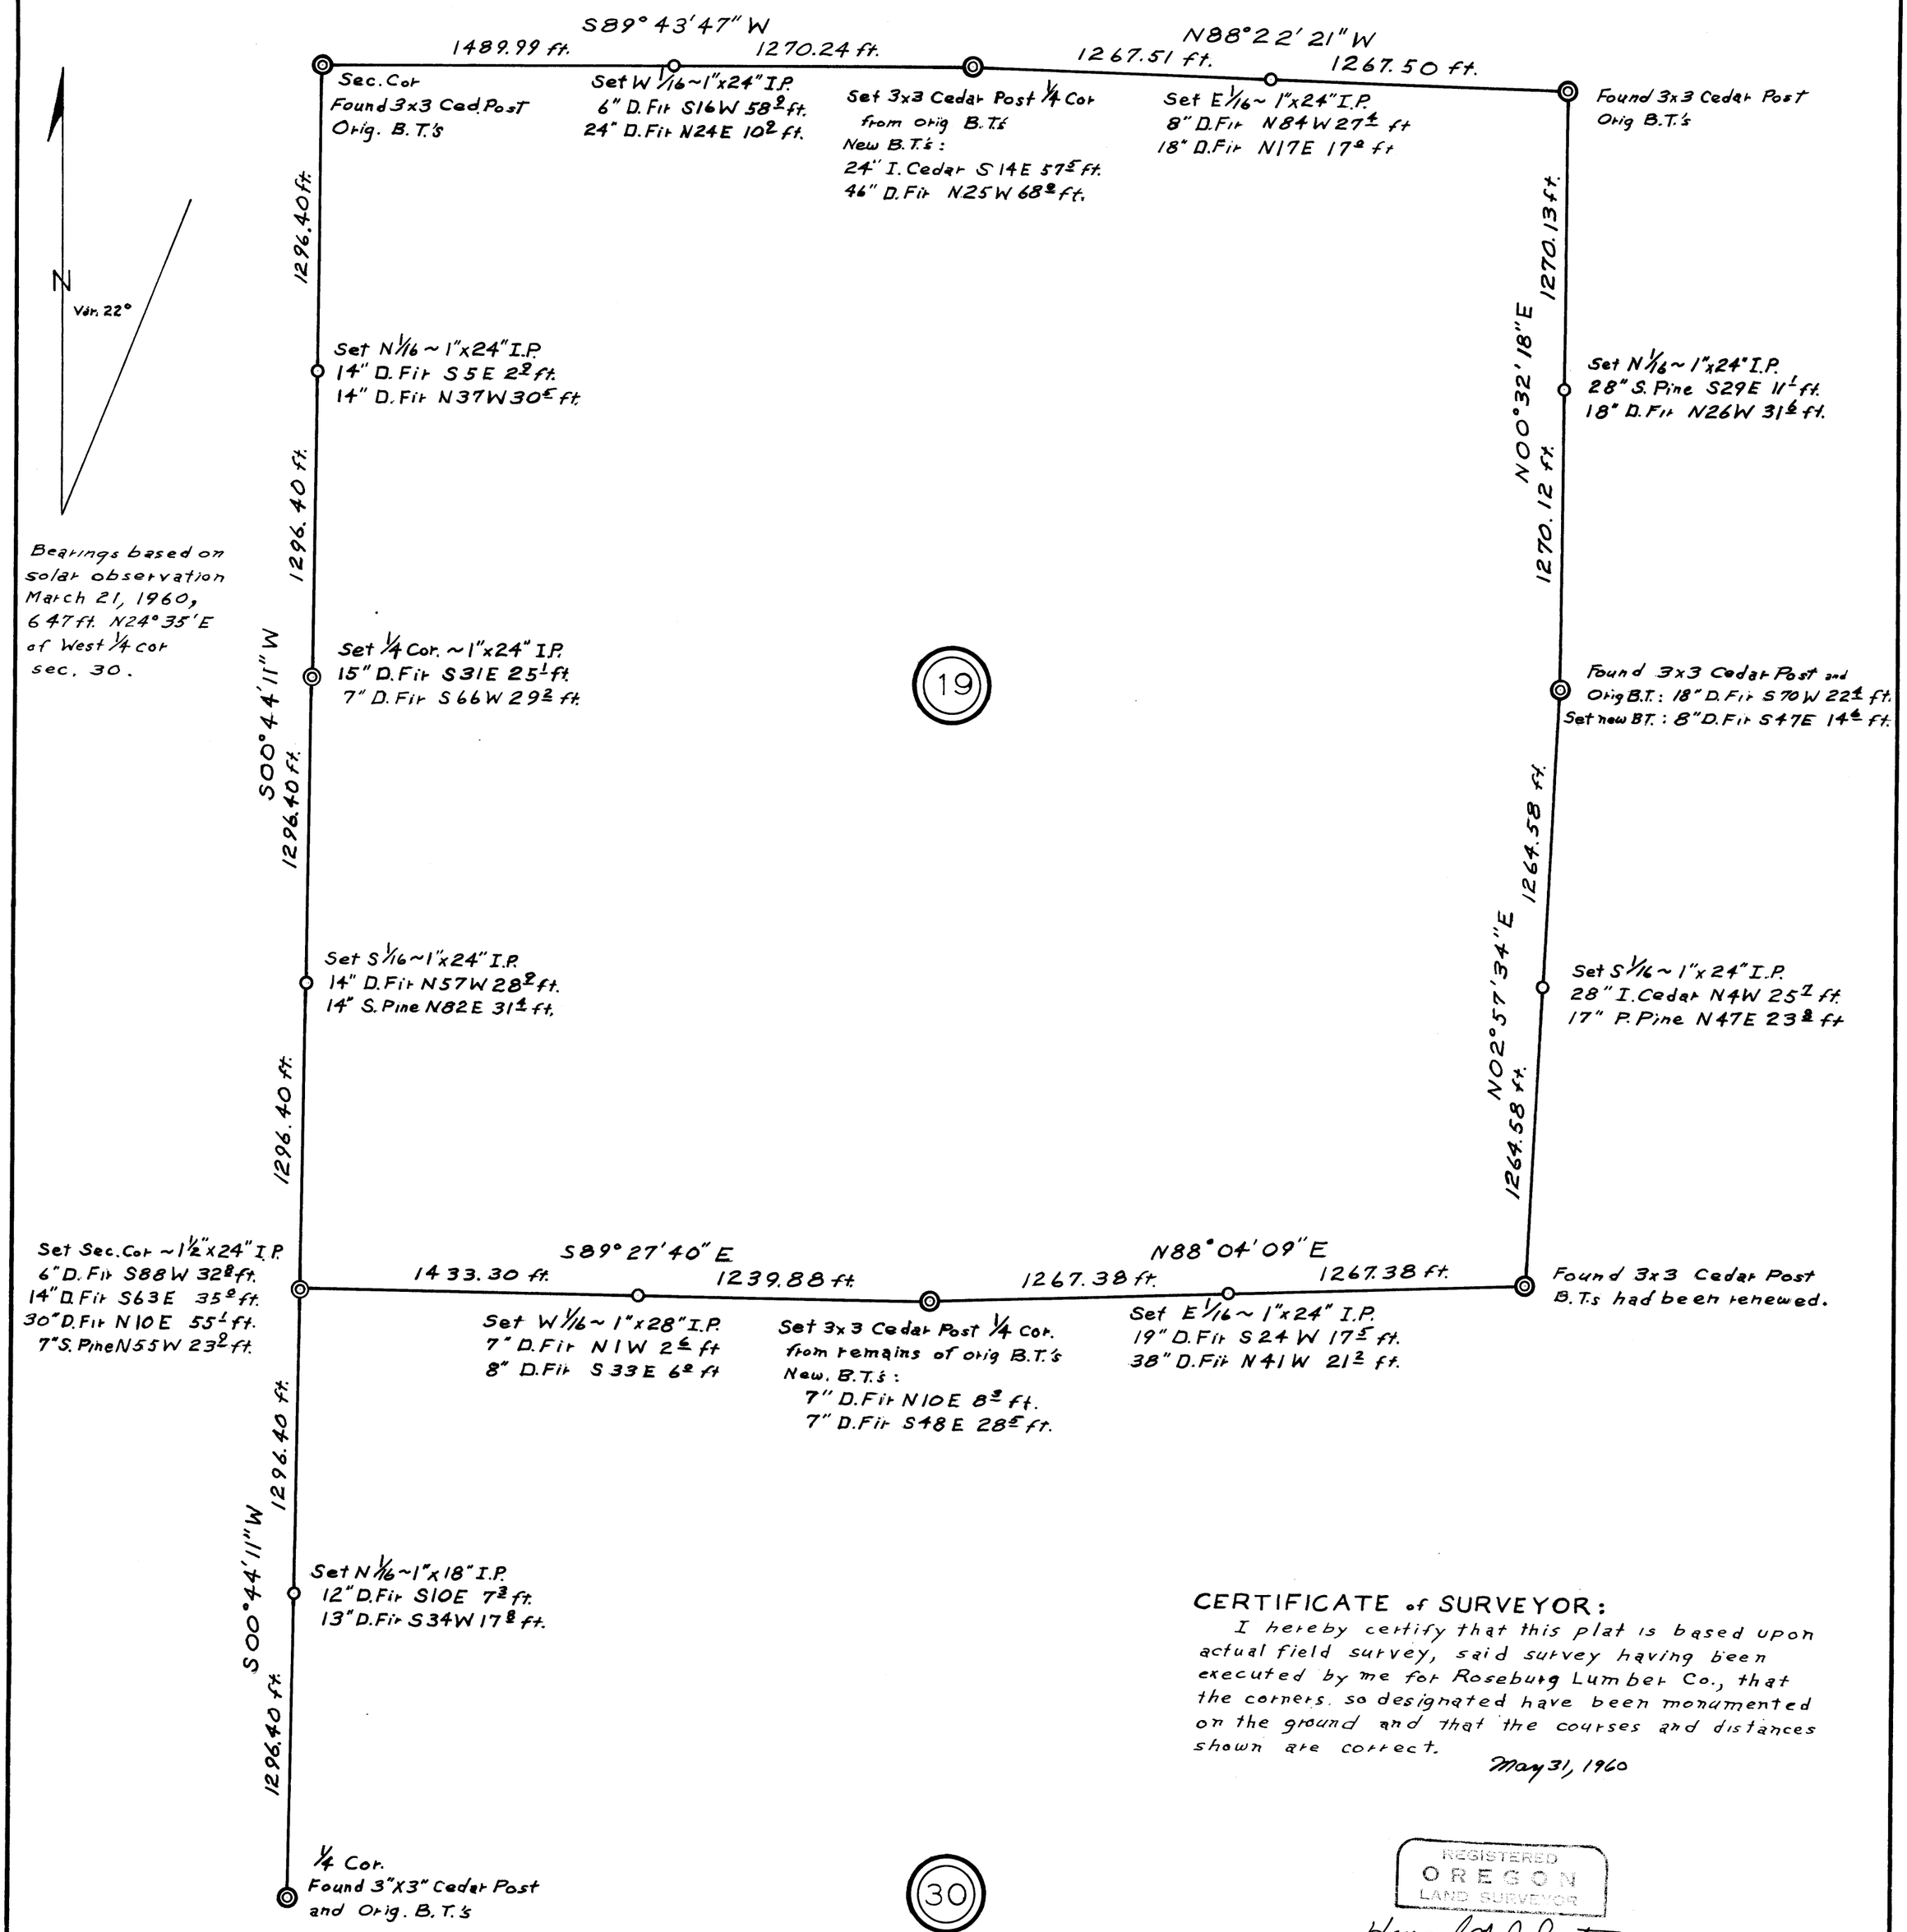

CERTIFICATE of SURVEYOR:

I hereby certify that this plat is based upon actual field survey, said survey having been executed by me for Roseburg Lumber Co., that the corners so designated have been monumented on the ground and that the courses and distances shown are correct.

May 31, 1960

REGISTERED
OREGON
LAND SURVEYOR

Howard W. Johnstone

MAY 13, 1940
HOWARD W. JOHNSTONE
498

FILED L.L.
RECEIVED
JUN 1 1960
COUNTY SURVEYOR
DOUGLAS COUNTY, ORE.

MAP FILE M 18-66