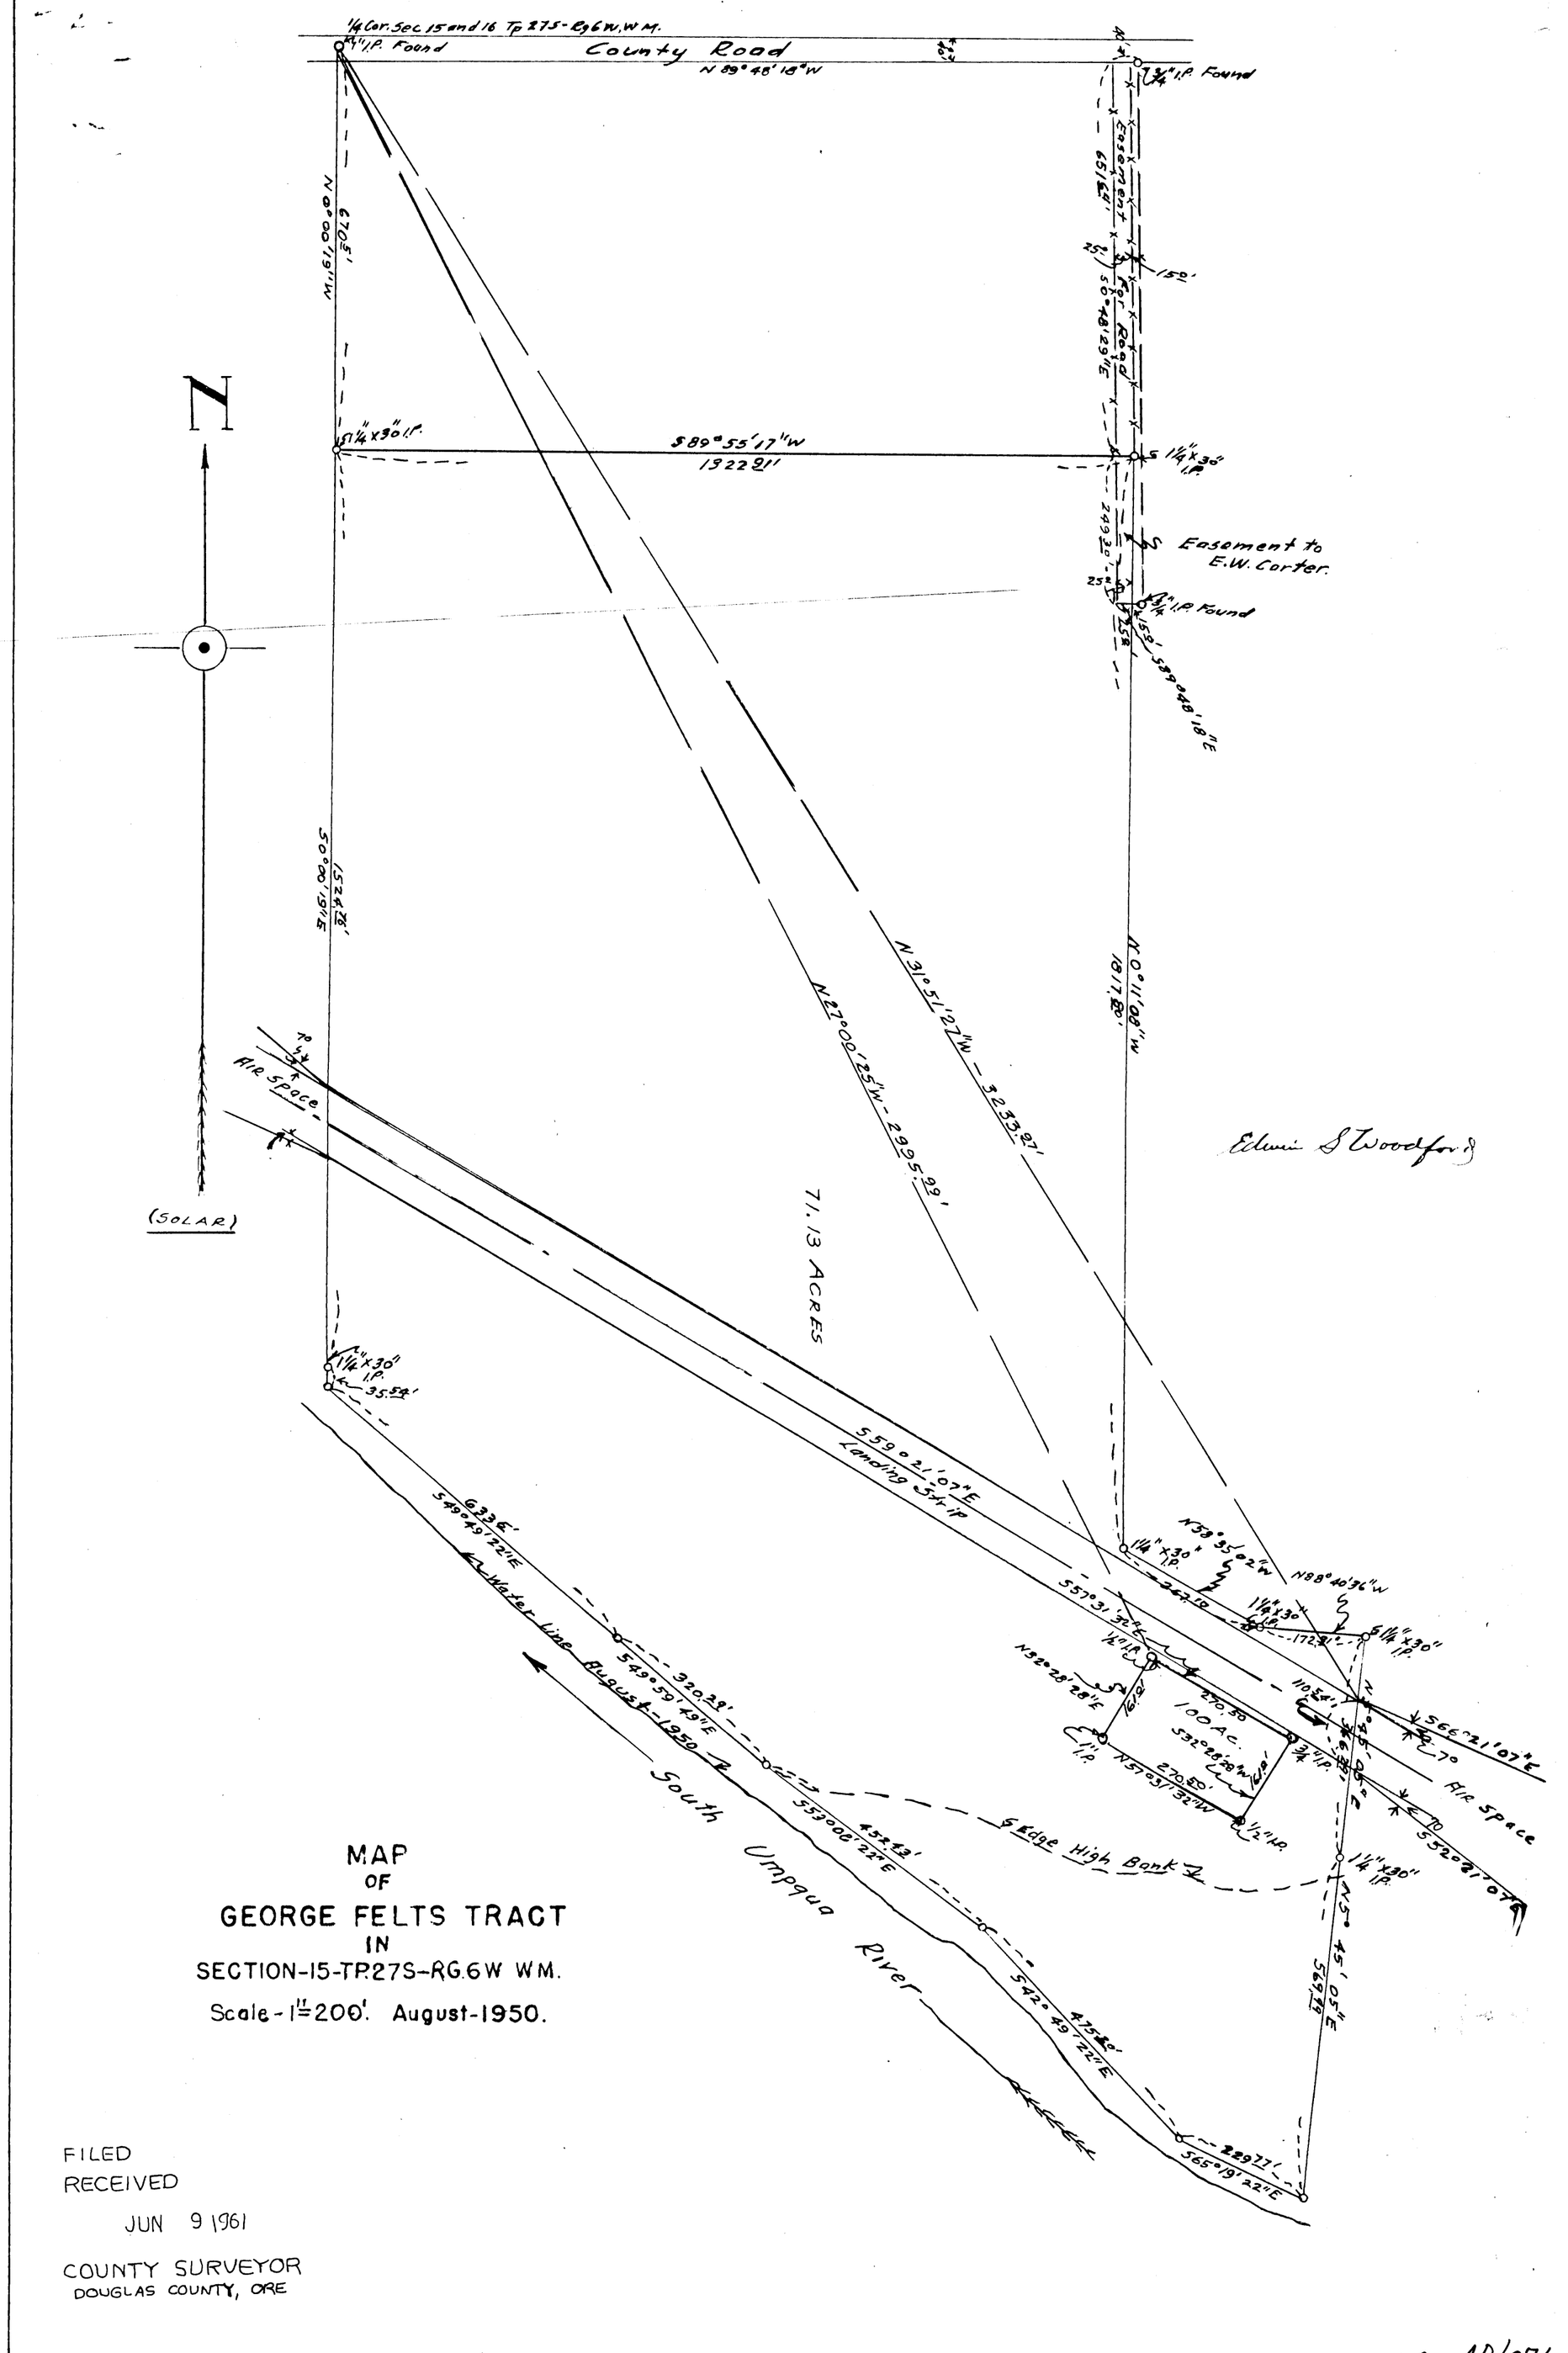

MAP
OF
GEORGE FELTS TRACT
IN
SECTION-15-TP.27S-RG.6W W.M.
Scale-1"=200'. August-1950.

FILED
RECEIVED
JUN 9 1961
COUNTY SURVEYOR
DOUGLAS COUNTY, ORE

C.S. 40/276
M 18-68A

C.S. 40/276
M 18-68A

THIS COPY MADE FROM
A XEROX 2510
DATE July 12, 1989

COUNTY SURVEYORS FILE DATA
DO NOT REMOVE FROM OFFICE

C.S. 40/276
M 18-68A