MAP FILE M 19 -18

FILED
RECEIVED
JUL 18 1960
COUNTY SURVEYOR
DOUGLAS COUNTY, ORE.

REGISTERED
OREGON
LAND SURVEYOR
Wilford N. Haines
MAY 7, 1948
WILFORD N. HAINES
239

COUNTY SURVEYORS FILE DATA
DO NOT REMOVE FROM OFFICE

BLOCK 5 PLAT OF DRAIN

Blanch Merrill Drain Oreg.

July 14 1960 scale 1" = 5 FT.

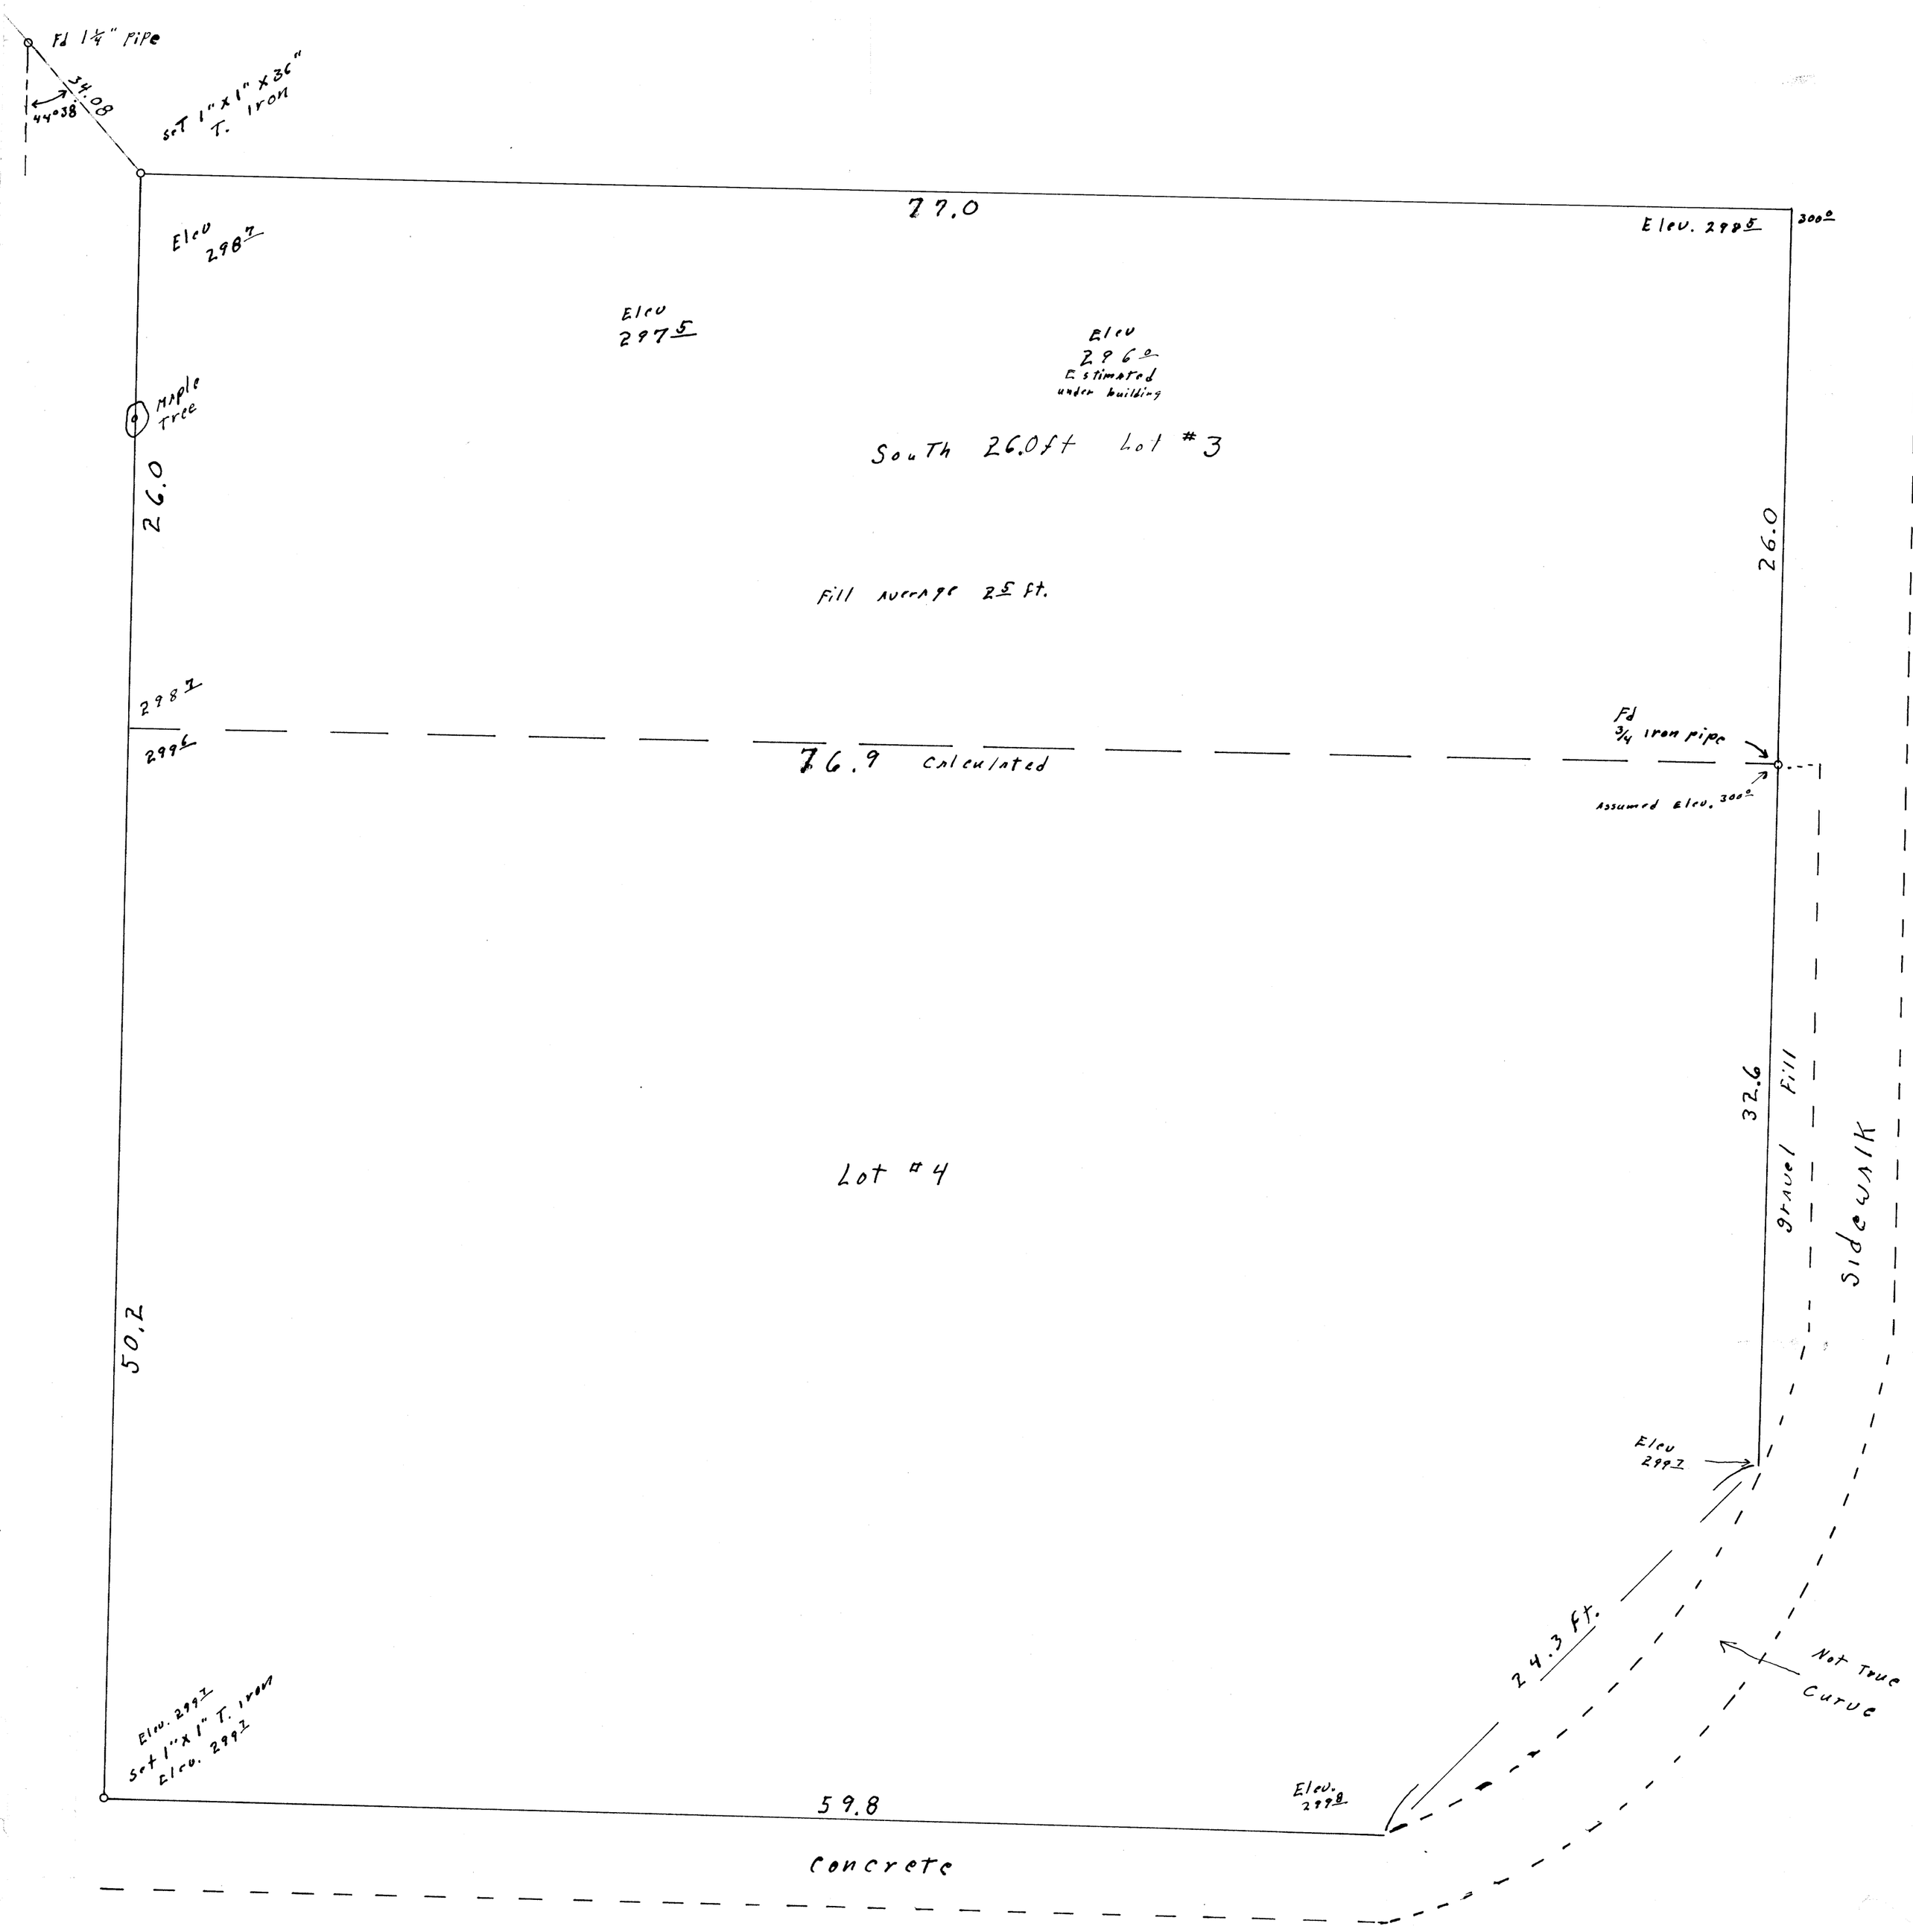

T. 22-5 NW NE ¼ Sec. 17

MAP FILE M 19 + 18