C.S. FILE 89/71
M19-28

COUNTY SURVEYORS OFFICE
DOUGLAS COUNTY OREGON

DEED DESCRIPTION FOR VICTOR SMITH ROSEBURG OREGON

REGISTERED OREGON LAND SURVEYOR
N E Richardson
JULY 7, 1944
N. E. RICHARDSON
35

BEN B IRVING COUNTY SURVEYOR
SURVEYED MAR 4 1947 BY
N E RICHARDSON DEPUTY
SCALE 1" = 30'

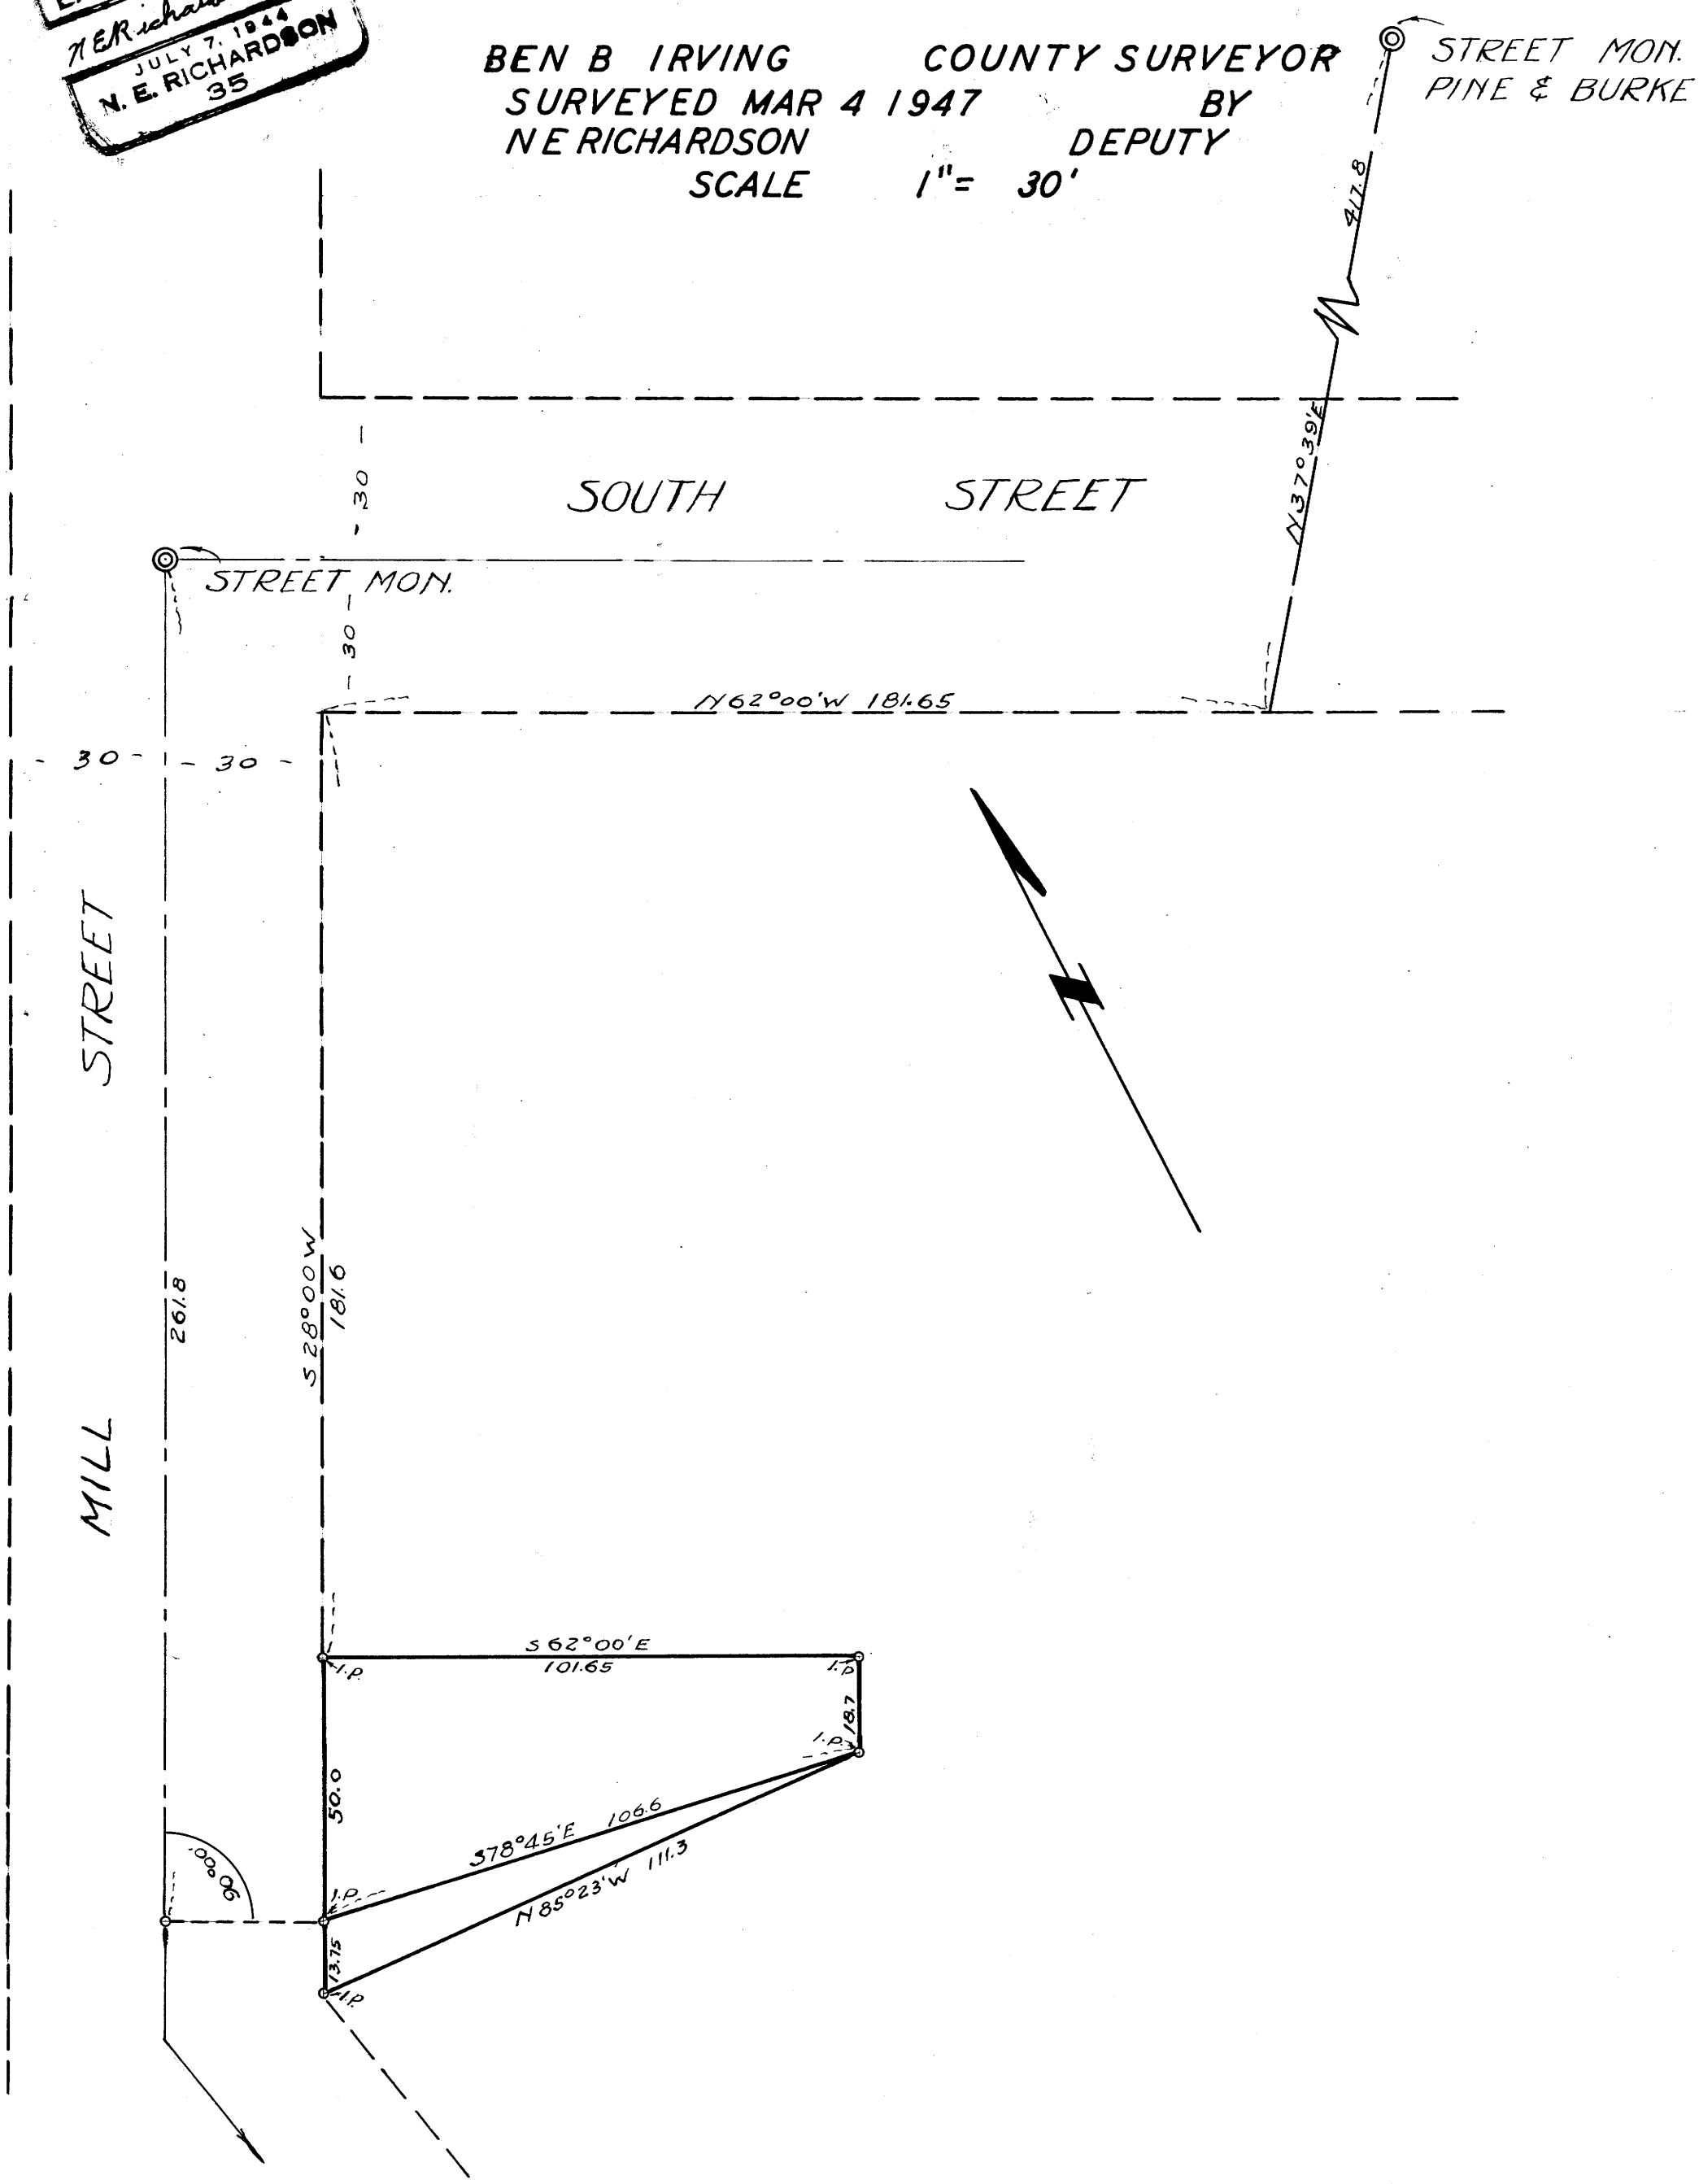

COUNTY SURVEYORS FILE DATA
DO NOT REMOVE FROM OFFICE

M19-28
FILE 71 DRAWER 30