C.S. 39/99
M 19-29

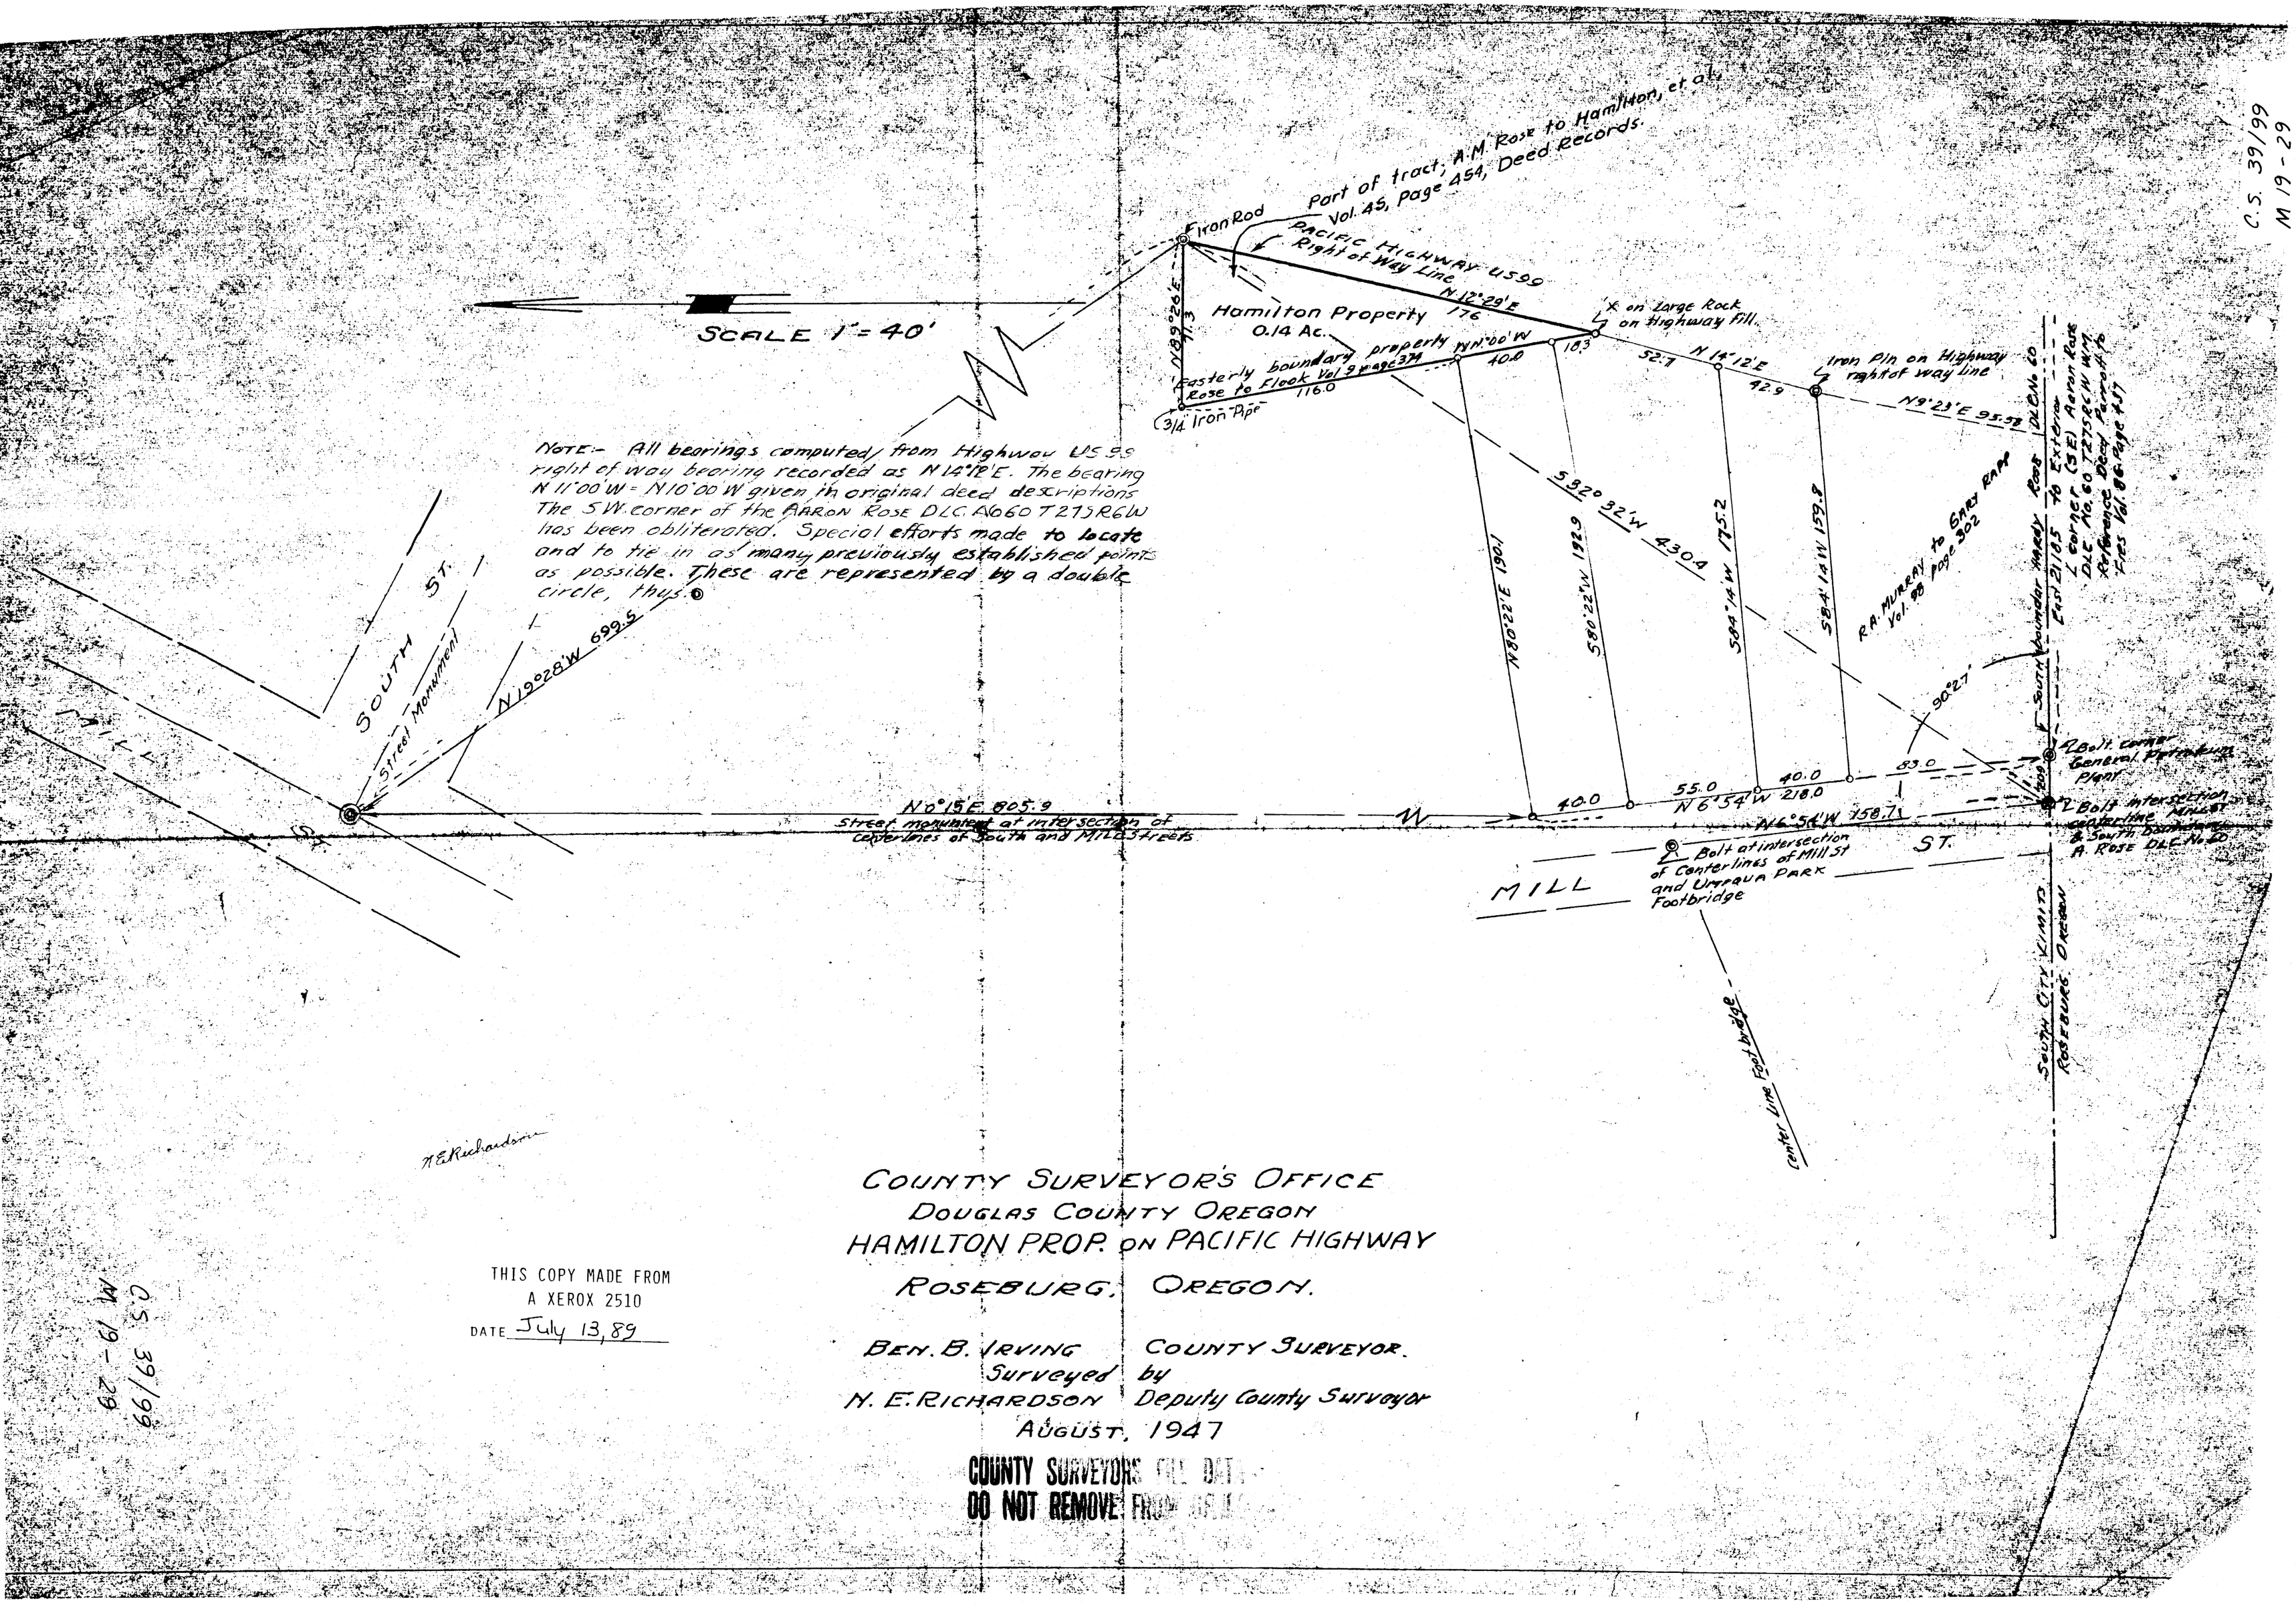

NOTE:- All bearings computed from Highway US 99 right of way bearing recorded as N 14°12'E. The bearing N 11°00'W = N 10°00'W given in original deed descriptions. The S.W. corner of the AARON ROSE D.L.C. A060 T27S R6W has been obliterated. Special efforts made to locate and to tie in as many previously established points as possible. These are represented by a double circle, thus.

N.E. Richardson

COUNTY SURVEYOR'S OFFICE
DOUGLAS COUNTY OREGON
HAMILTON PROP. ON PACIFIC HIGHWAY
ROSEBURG, OREGON.

BEN. B. IRVING COUNTY SURVEYOR.
Surveyed by
N. E. RICHARDSON Deputy County Surveyor
AUGUST, 1947

COUNTY SURVEYOR'S FILE DATA
DO NOT REMOVE FROM FILE

THIS COPY MADE FROM
A XEROX 2510
DATE July 13, 89

C.S. 39/99
M 19-29