COUNTY SURVEYORS FILE DATA
DO NOT REMOVE FROM OFFICE

SURVEY FOR DEED DESCRIPTIONS
METES AND BOUNDS PARCEL
CITY OF ROSEBURG OREGON

GRANT AND EVANS, ENGINEERS
ROSEBURG, OREGON
MARCH 1953, SCALE 1" = 50'

REGISTERED PROFESSIONAL ENGINEER 2741 OREGON NOV. 7, 1947 ARTHUR R. EVANS

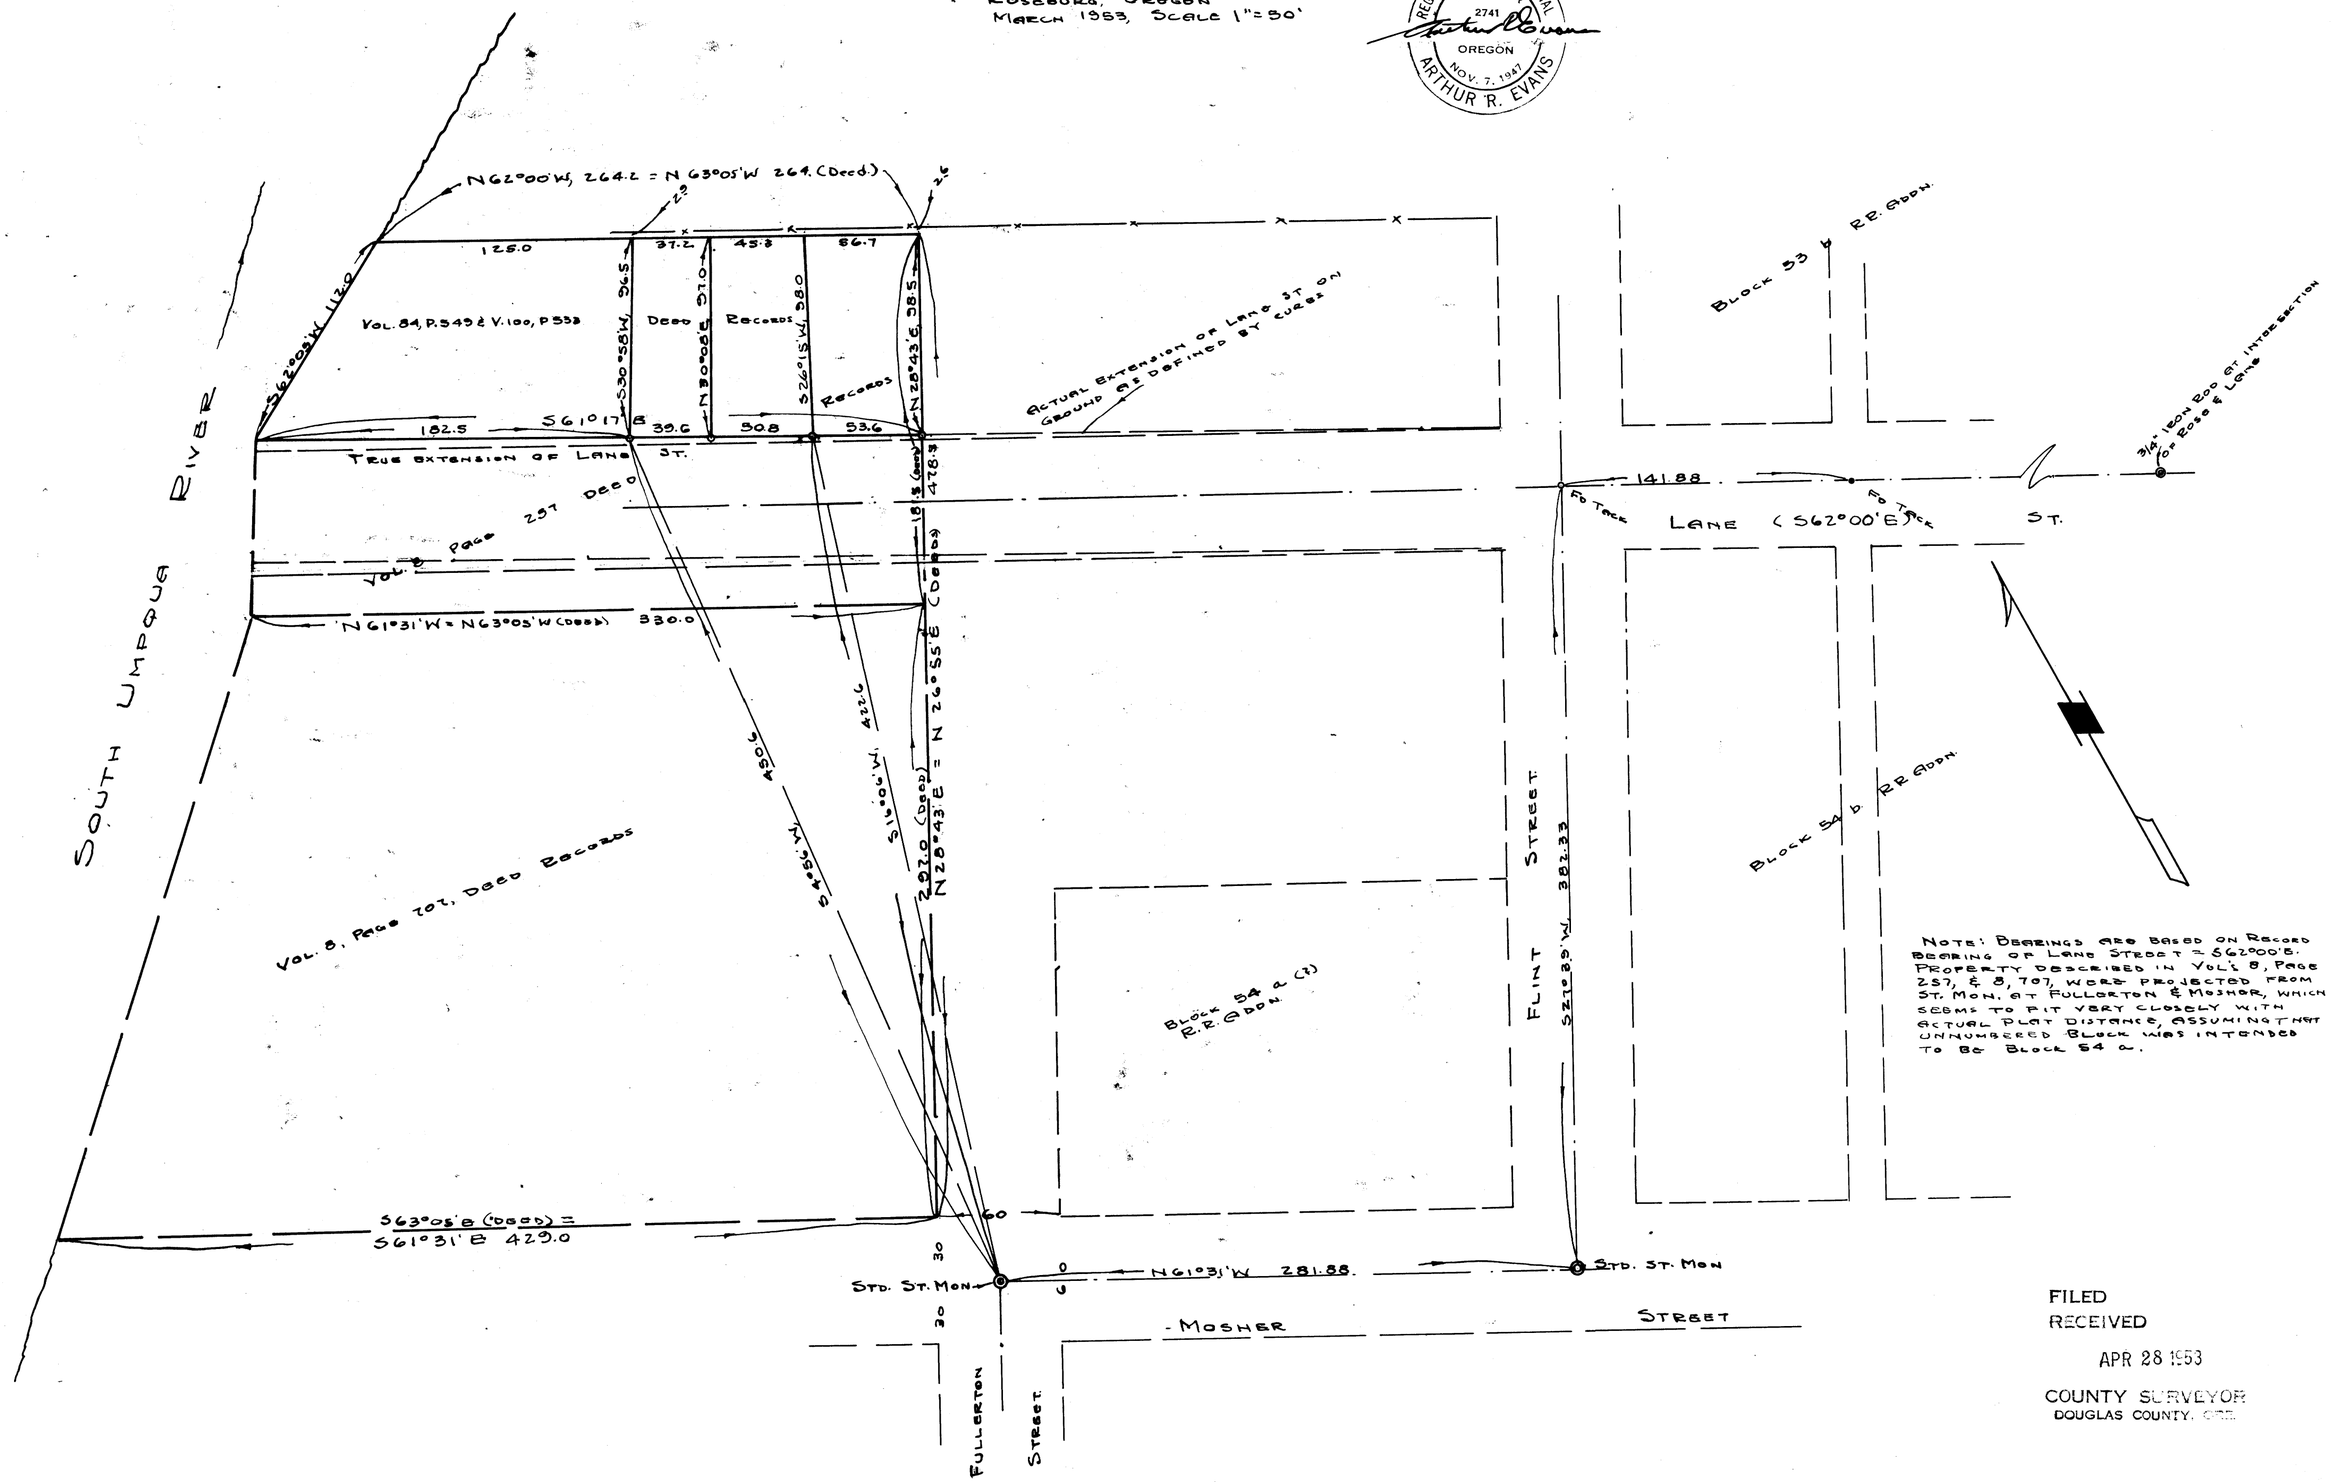

NOTE: BEARINGS ARE BASED ON RECORD BEARING OF LANE STREET = S62°00'E. PROPERTY DESCRIBED IN VOL'S 8, PAGE 257, & 8, 707, WERE PROJECTED FROM ST. MON. AT FULLERTON & MOSHER, WHICH SEEMS TO FIT VERY CLOSELY WITH ACTUAL PLOT DISTANCE, ASSUMING THAT UNNUMBERED BLOCK WAS INTENDED TO BE BLOCK 54 a.

FILED
RECEIVED
APR 28 1953
COUNTY SURVEYOR
DOUGLAS COUNTY, ORE.

C.S. FILE 4/1/48
M19-30