C.S. File 39/68
#19-35

SCALE 1" = 40'

NOTE:- All bearings computed from Highway US 99 right of way bearing recorded as N14°12'E. The bearing N 11°00'W = N10°00'W given in original deed descriptions. The S.W. corner of the Aaron Rose D.L.C. No 60 T27S R6W has been obliterated. Special efforts made to locate and tie in as many previously established points as possible. These are represented by a double circle, thus. ◎

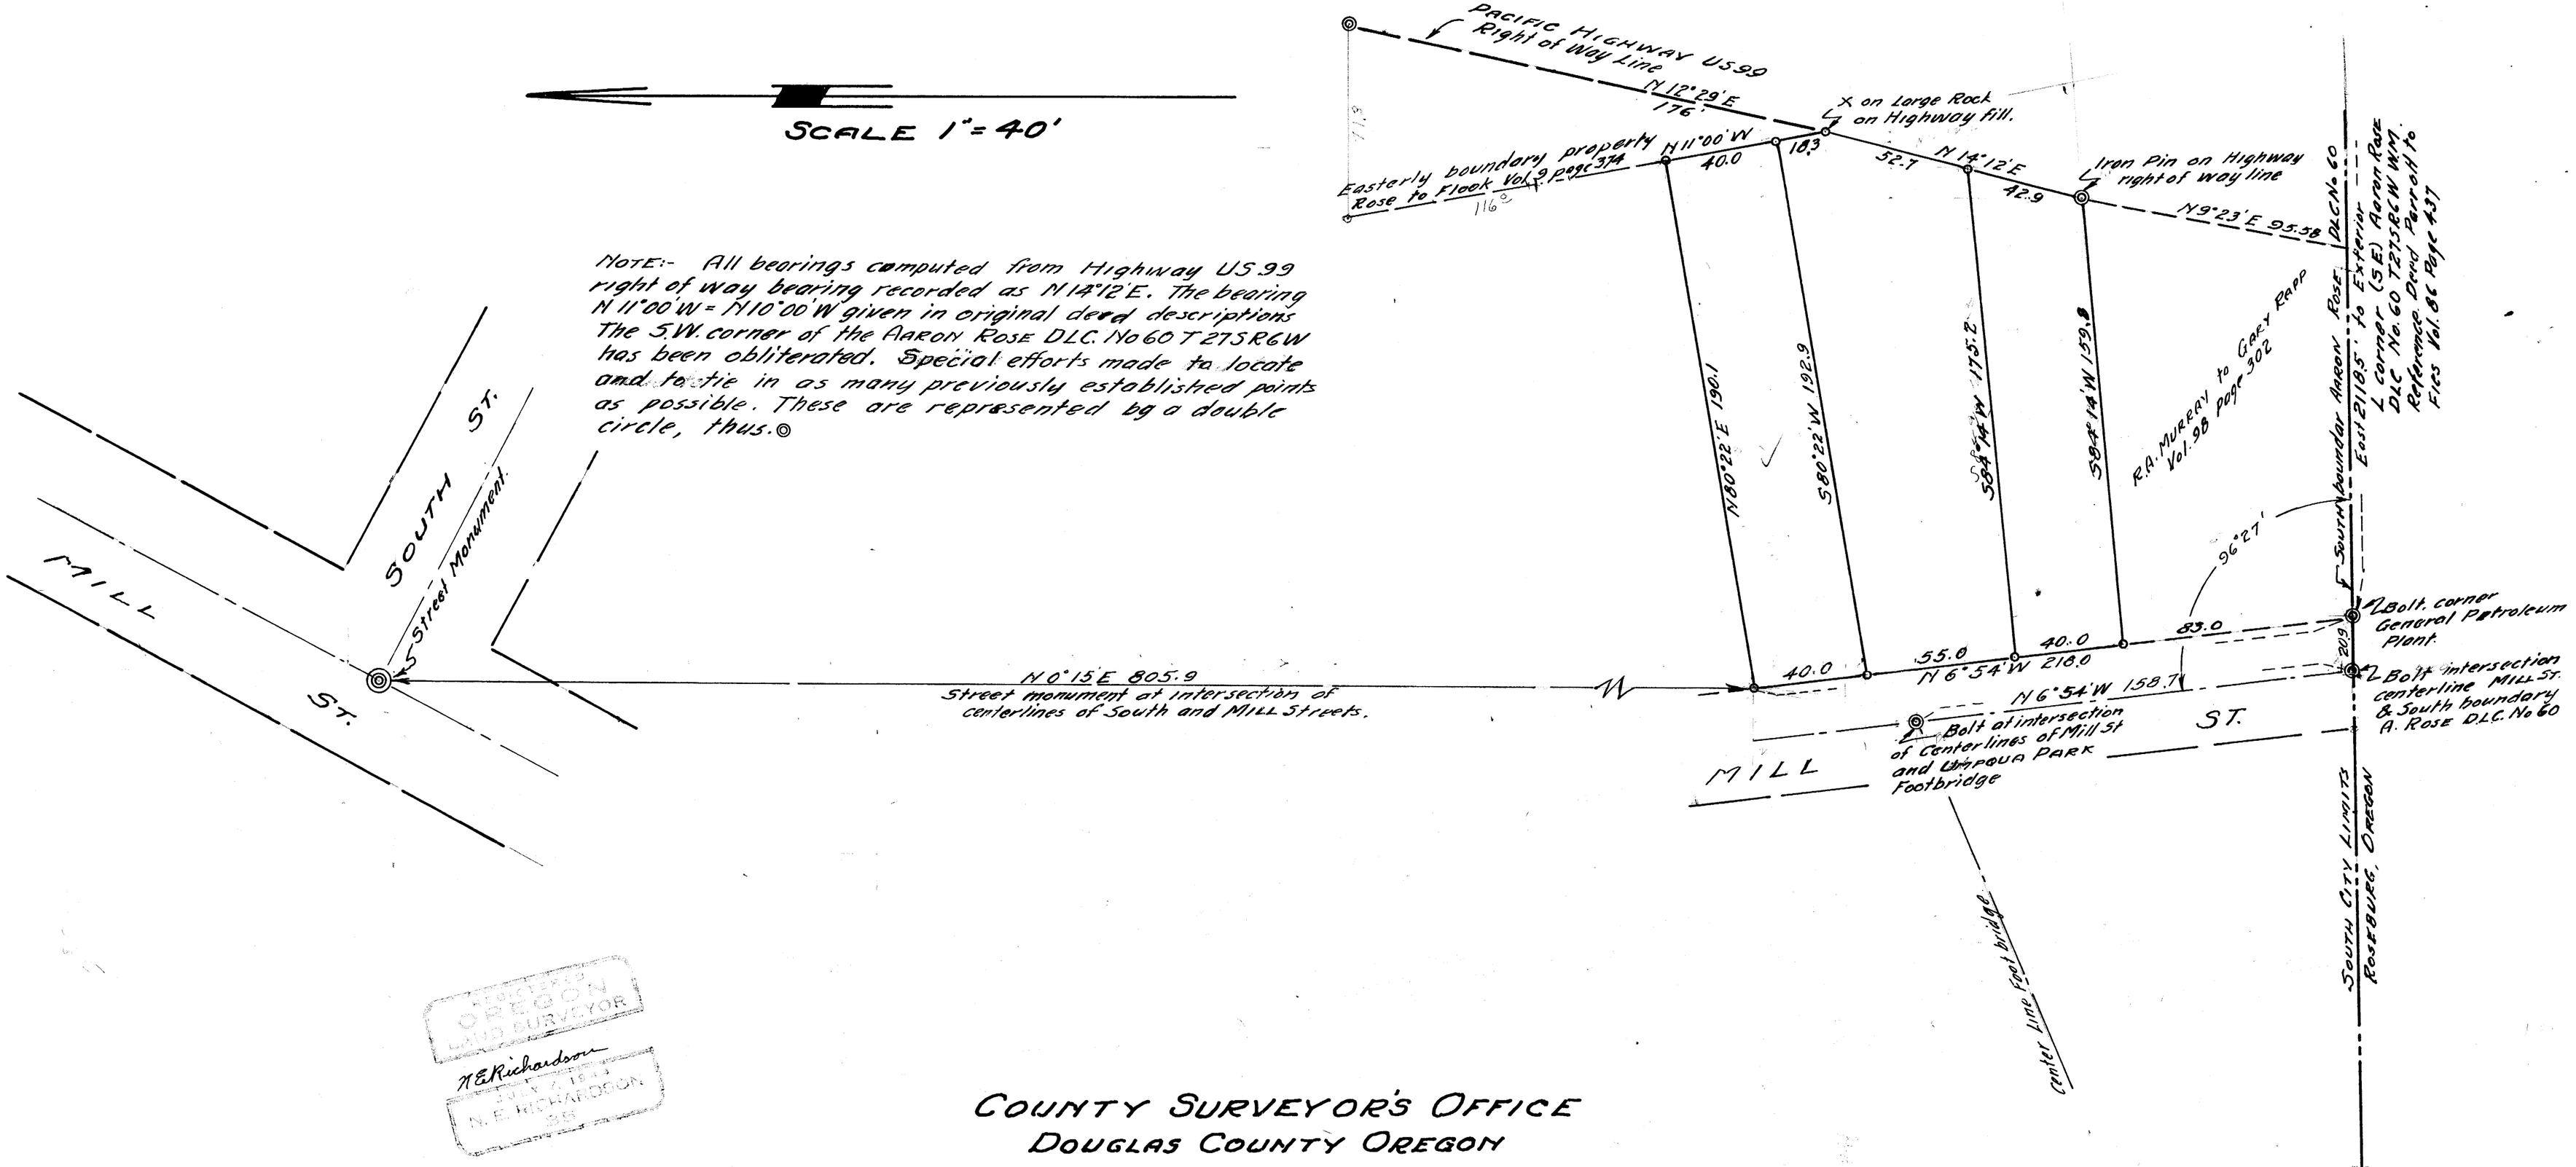

REGISTERED OREGON LAND SURVEYOR
N.E. Richardson
JAN. 7, 1964
N. E. RICHARDSON
25

COUNTY SURVEYOR'S OFFICE
DOUGLAS COUNTY OREGON

G.E. WOODRUFF PROPERTY
ROSEBURG, OREGON.

BEN. B. IRVING COUNTY SURVEYOR.
Surveyed by
N. E. RICHARDSON Deputy County Surveyor
February 1947

COUNTY SURVEYORS FILE DATA
DO NOT REMOVE FROM OFFICE

C.S. File 39/68
#19-35