C.S. FILE 32/37
M19-39

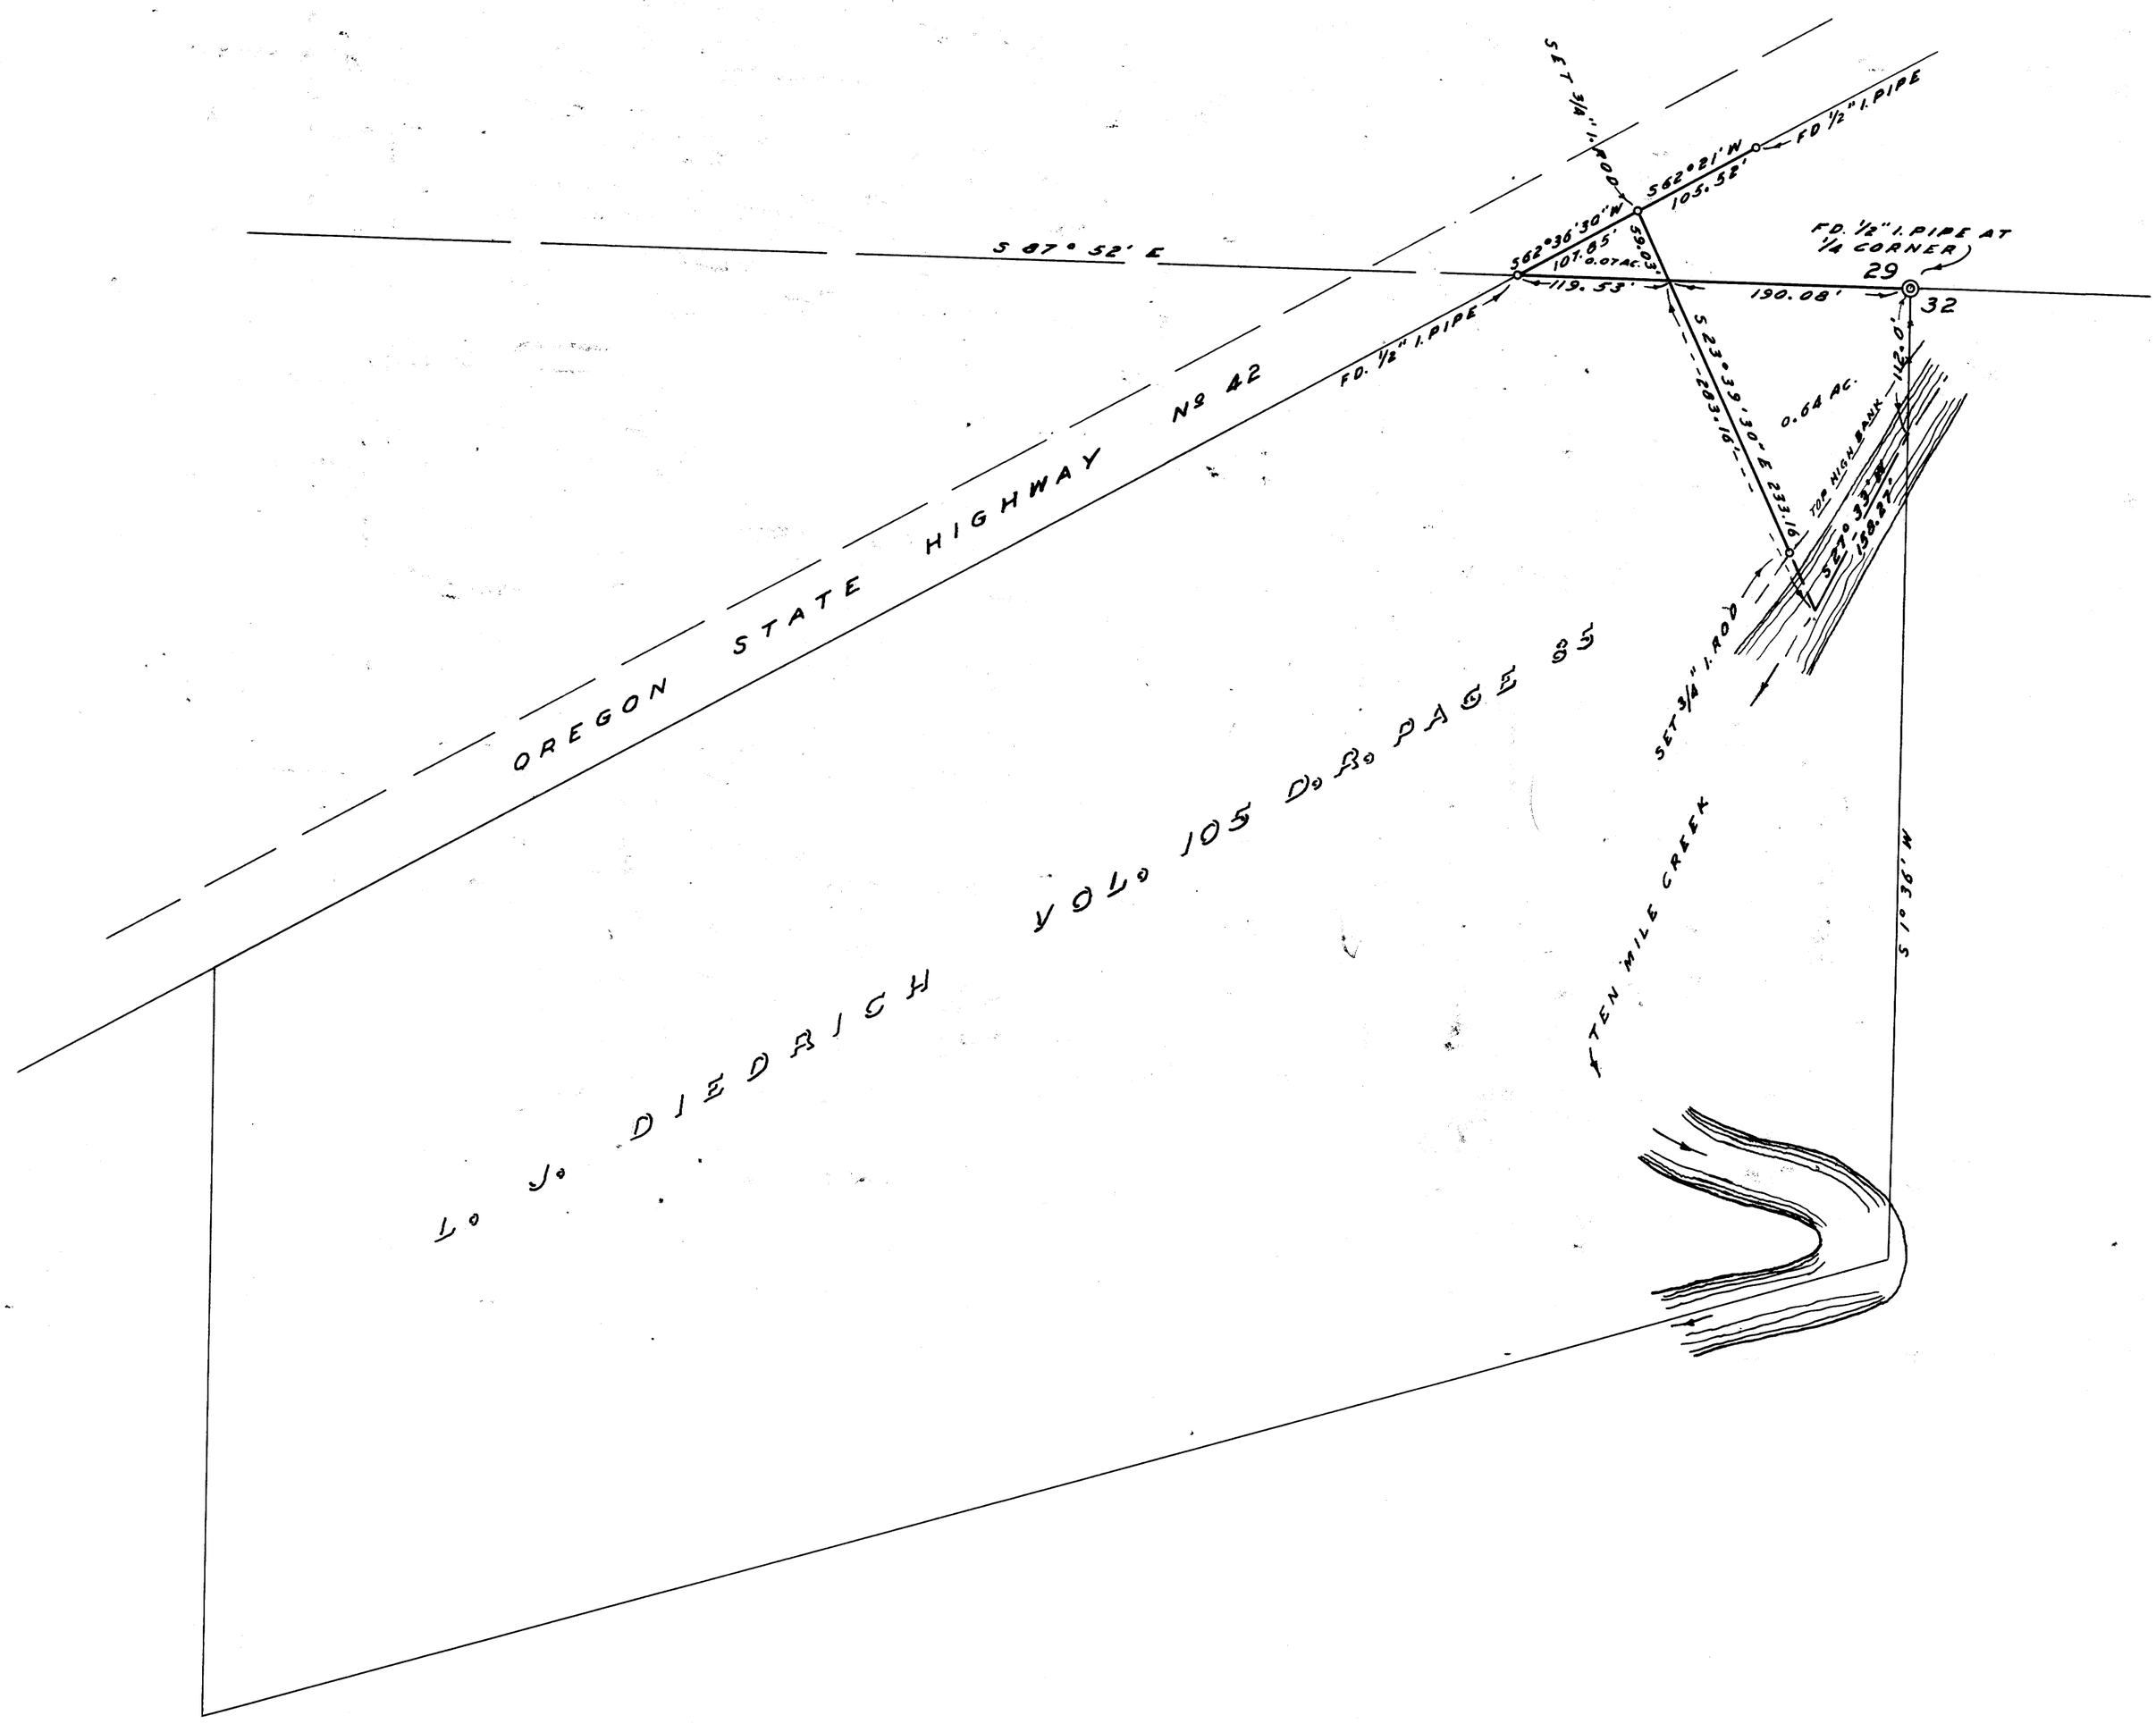


NOTE: BEARINGS BASED ON DEED REC. VOL. 105, PAGE 85.

N

COUNTY SURVEYORS FILE DATA
DO NOT REMOVE FROM OFFICE

COUNTY SURVEYOR'S OFFICE
DOUGLAS COUNTY, OREGON

SURVEY FOR DEED DESCRIPTION
SECTION 29 & 32 T.28 S., R.7 W. W.M.

FRED M. DARBY — COUNTY SURVEYOR
SURVEYED AUG. 9, 1960 — BY
JAMES W. BYRON - DEPUTY — SCALE 1" = 100'
SURVEYED FOR L. J. DIEDRICH

REGISTERED
OREGON
LAND SURVEYOR

James W. Byron

NOV. 8, 1983
JAMES W. BYRON
303

C.S. FILE 32/37
M19-39