4 prints

M 19-67

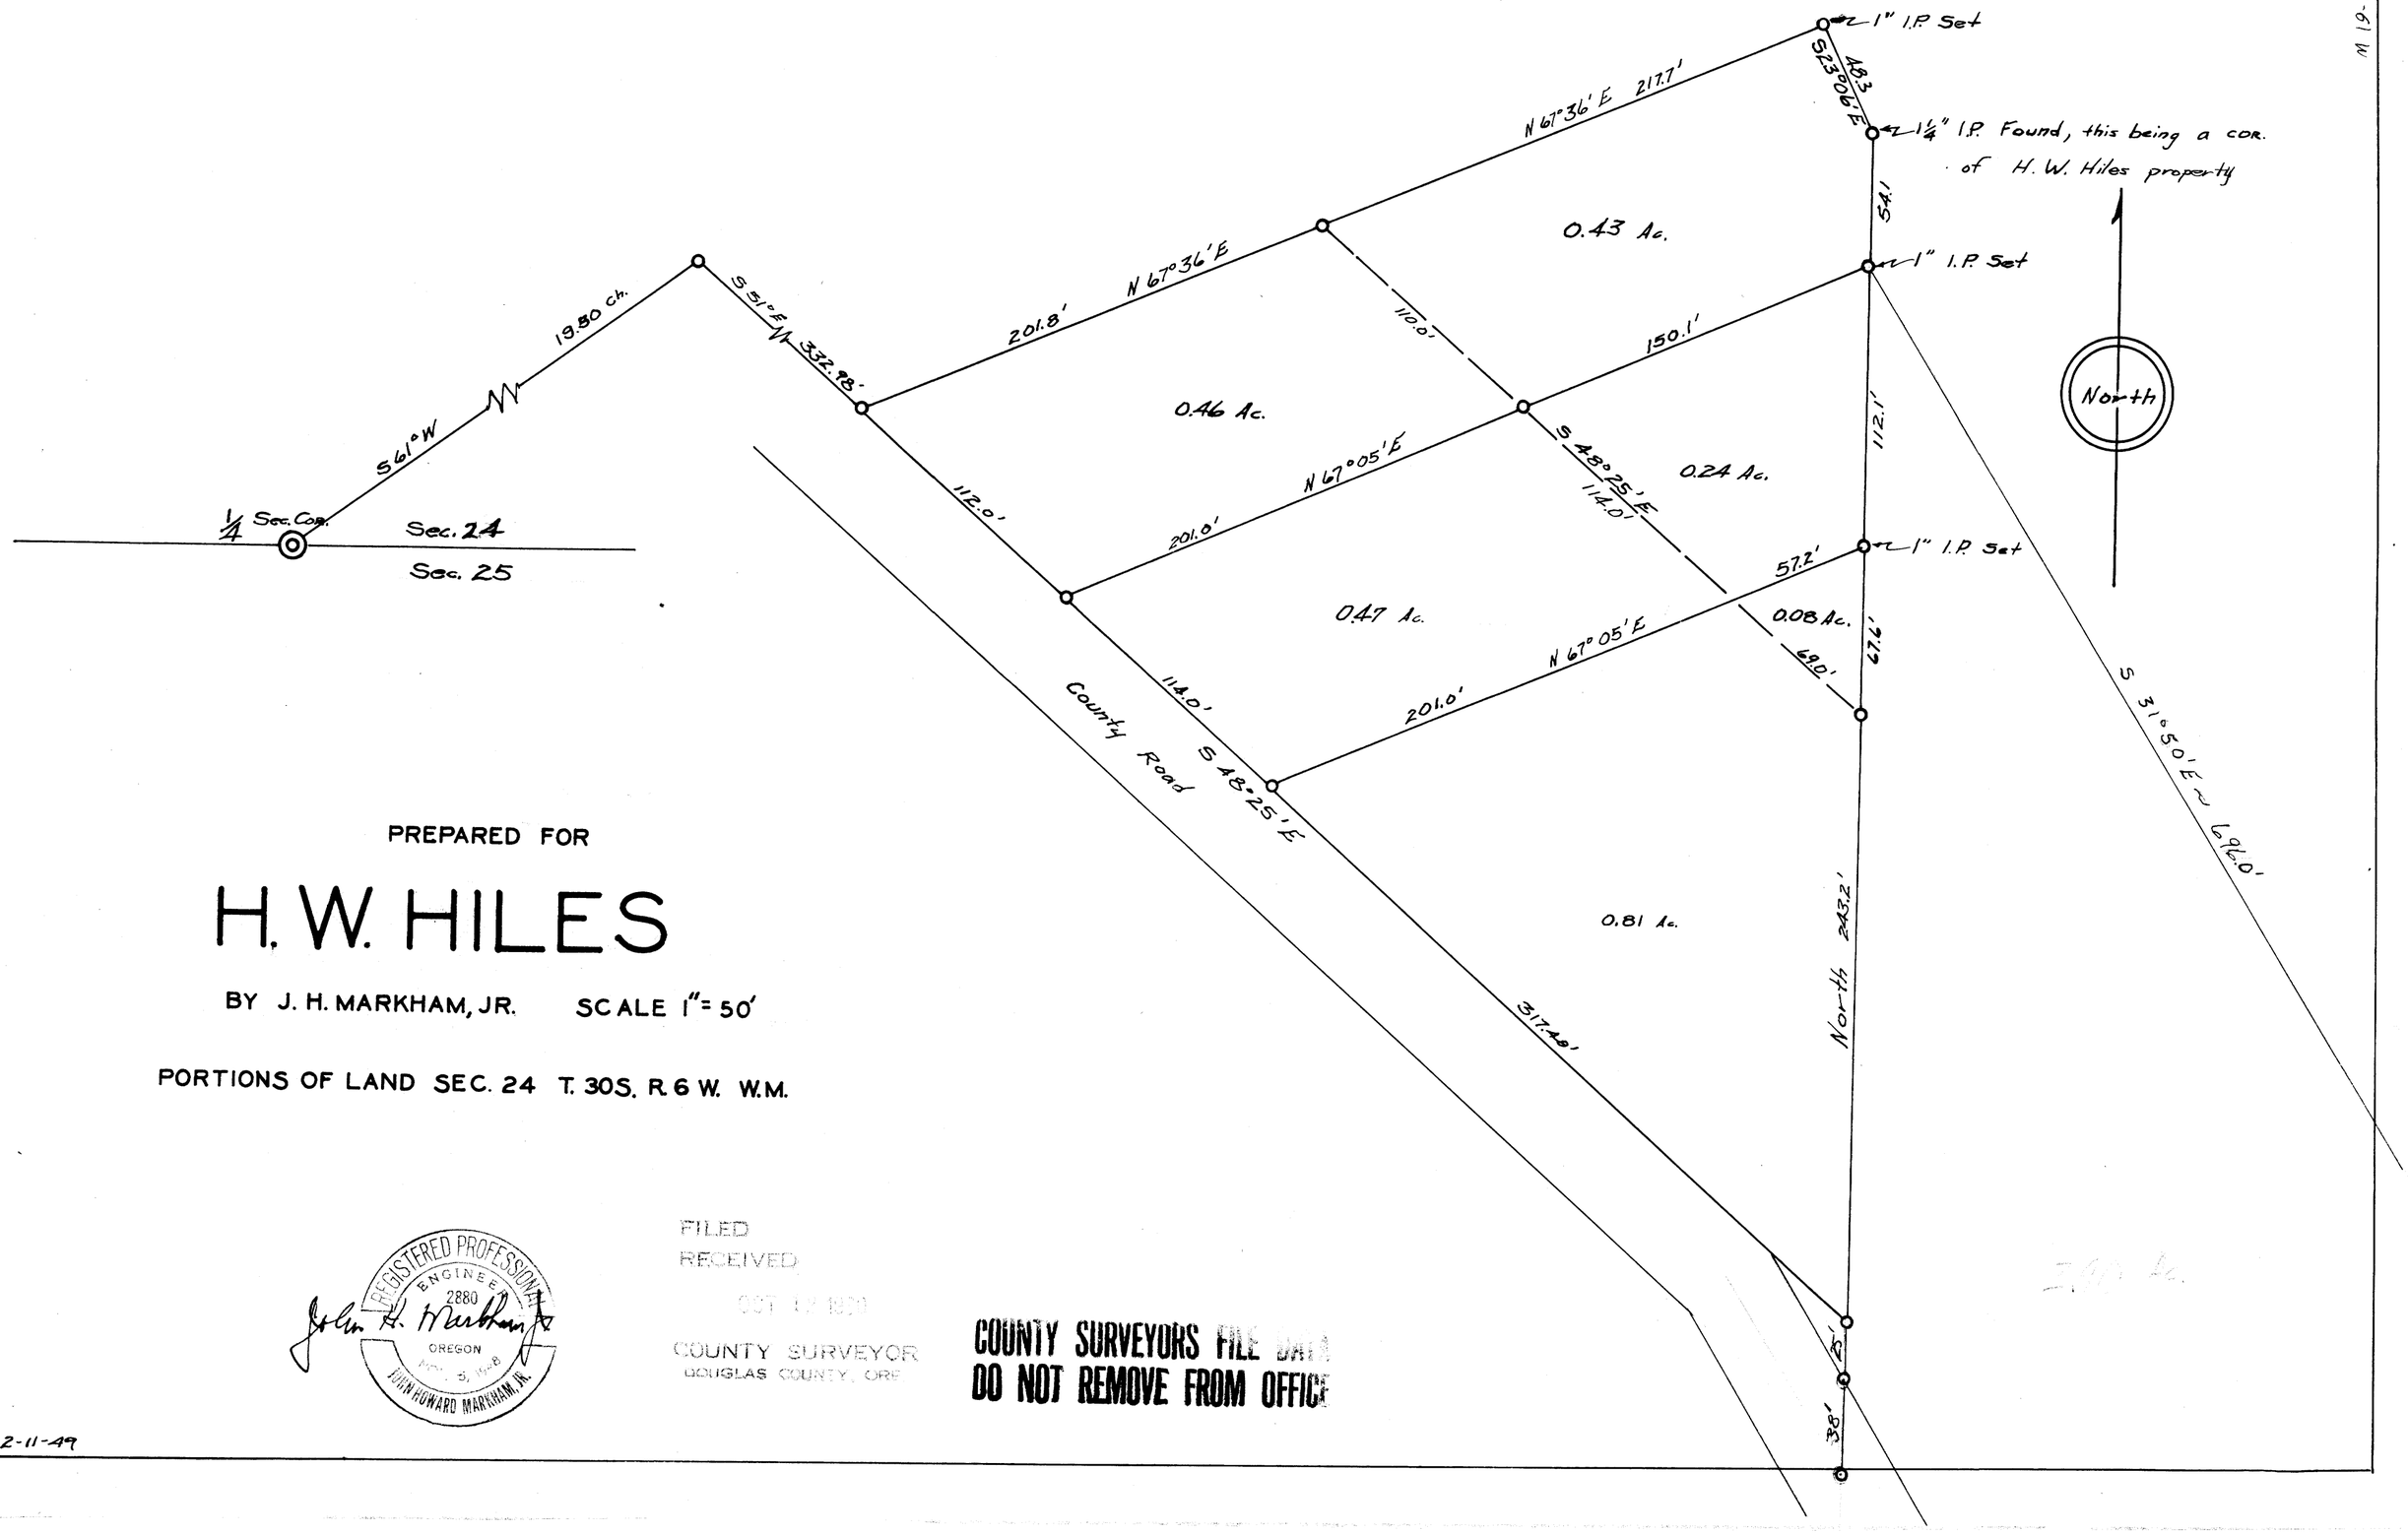

PREPARED FOR

H. W. HILES

BY J. H. MARKHAM, JR. SCALE 1" = 50'

PORTIONS OF LAND SEC. 24 T. 30S. R. 6 W. W.M.

REGISTERED PROFESSIONAL ENGINEER 2880 OREGON JOHN HOWARD MARKHAM, JR.

John H. Markham Jr.

FILED
RECEIVED
OCT 12 1970
COUNTY SURVEYOR
DOUGLAS COUNTY, ORE

COUNTY SURVEYORS FILE DATA
DO NOT REMOVE FROM OFFICE

2-11-49

MAP FILE M 19-67