FILED
RECEIVED
OCT 2 1960
COUNTY SURVEYOR
DOUGLAS COUNTY, ORE.

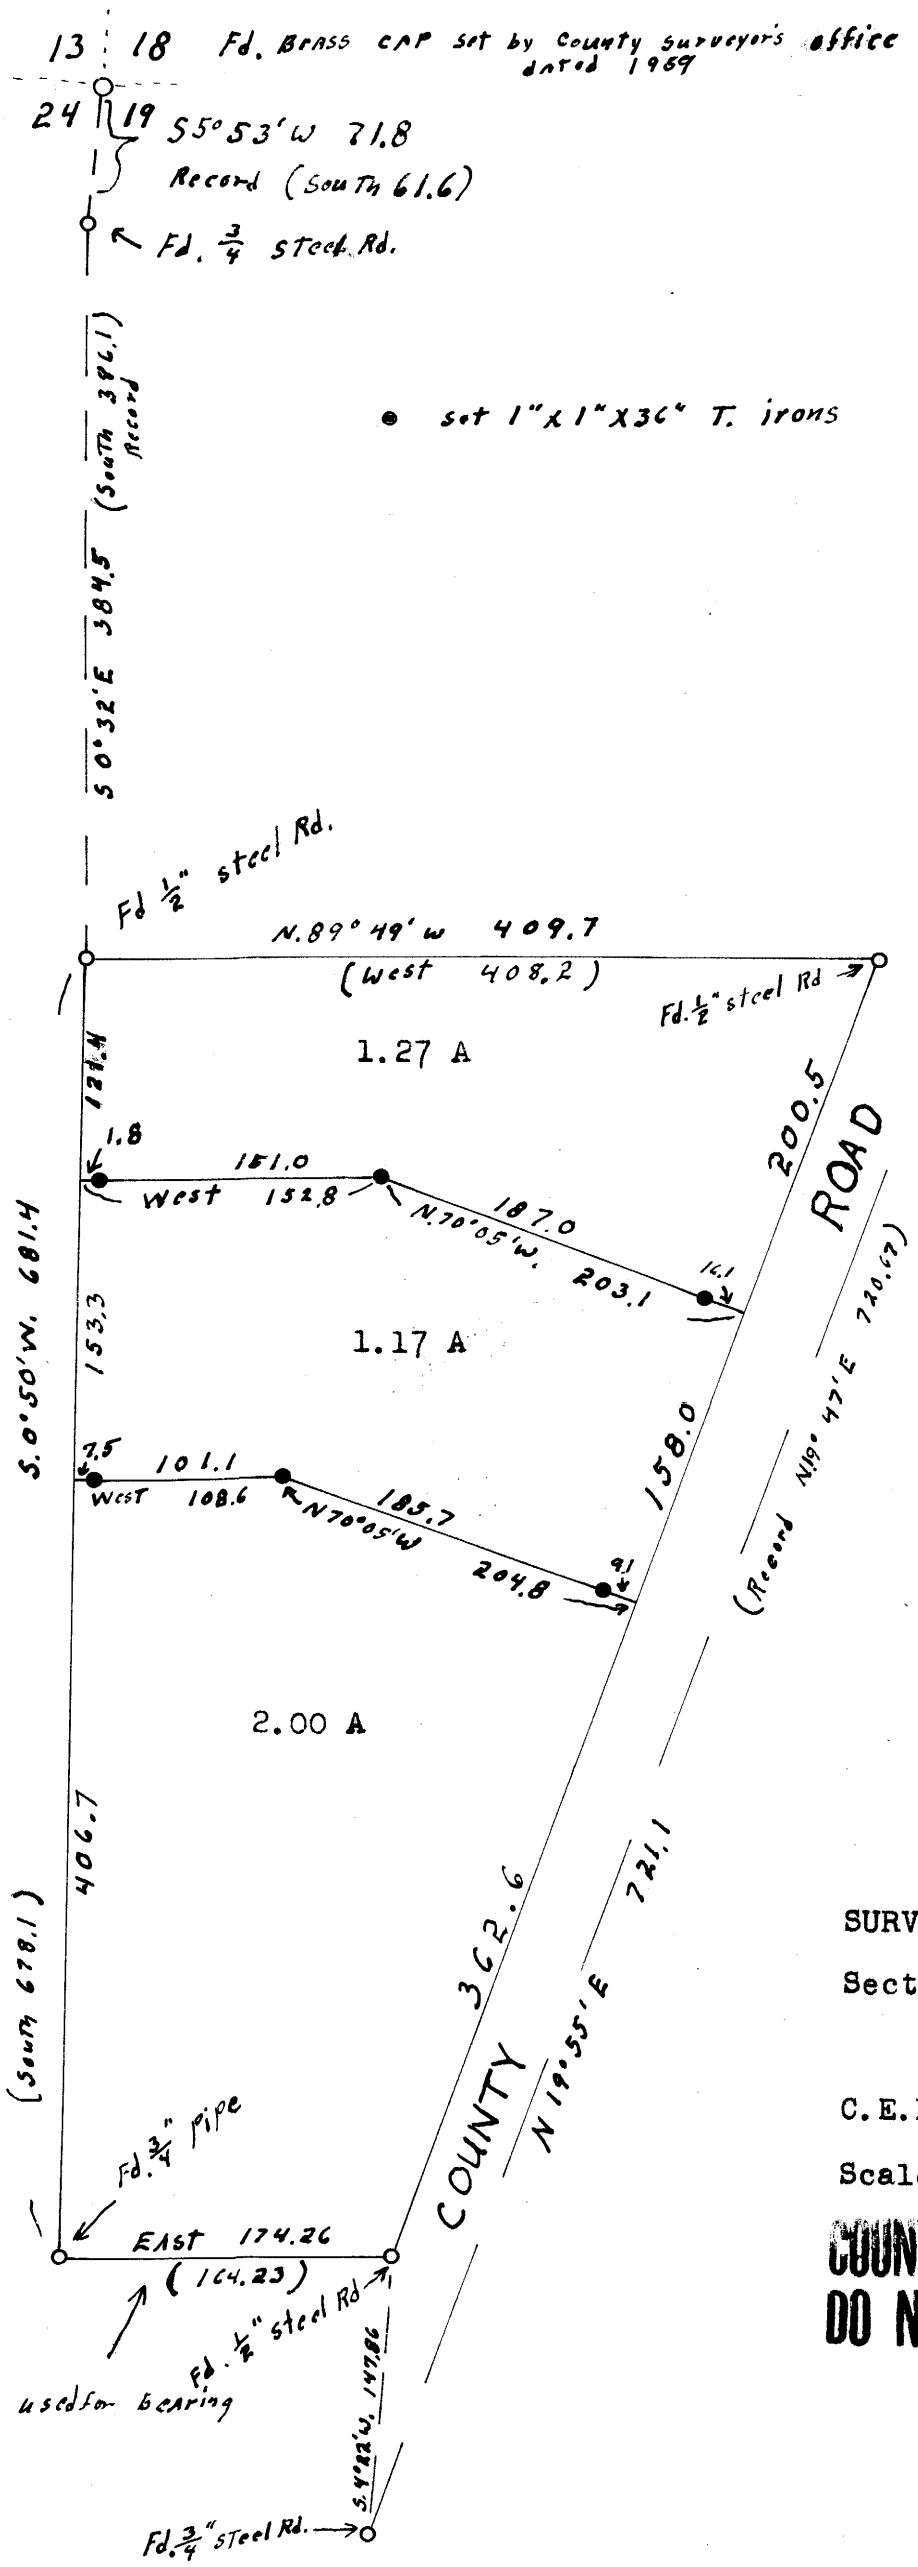


REGISTERED
OREGON
LAND SURVEYOR
Wilford N. Haines
MAY 7, 1948
WILFORD N. HAINES
239

SURVEY FOR DEED DESCRIPTION

Sect.19, T.22 S., R.5 W. W.M.

for

C.E.Lounsbury, Lyons, Oregon.

Scale: 1"= 100' Oct. 1960.

COUNTY SURVEYORS FILE DATA
DO NOT REMOVE FROM OFFICE

REFER TO C.S. FILE 40/357
DON SURVEY

MAP FILE M19-71