C.S. FILE 52/69
M20-18

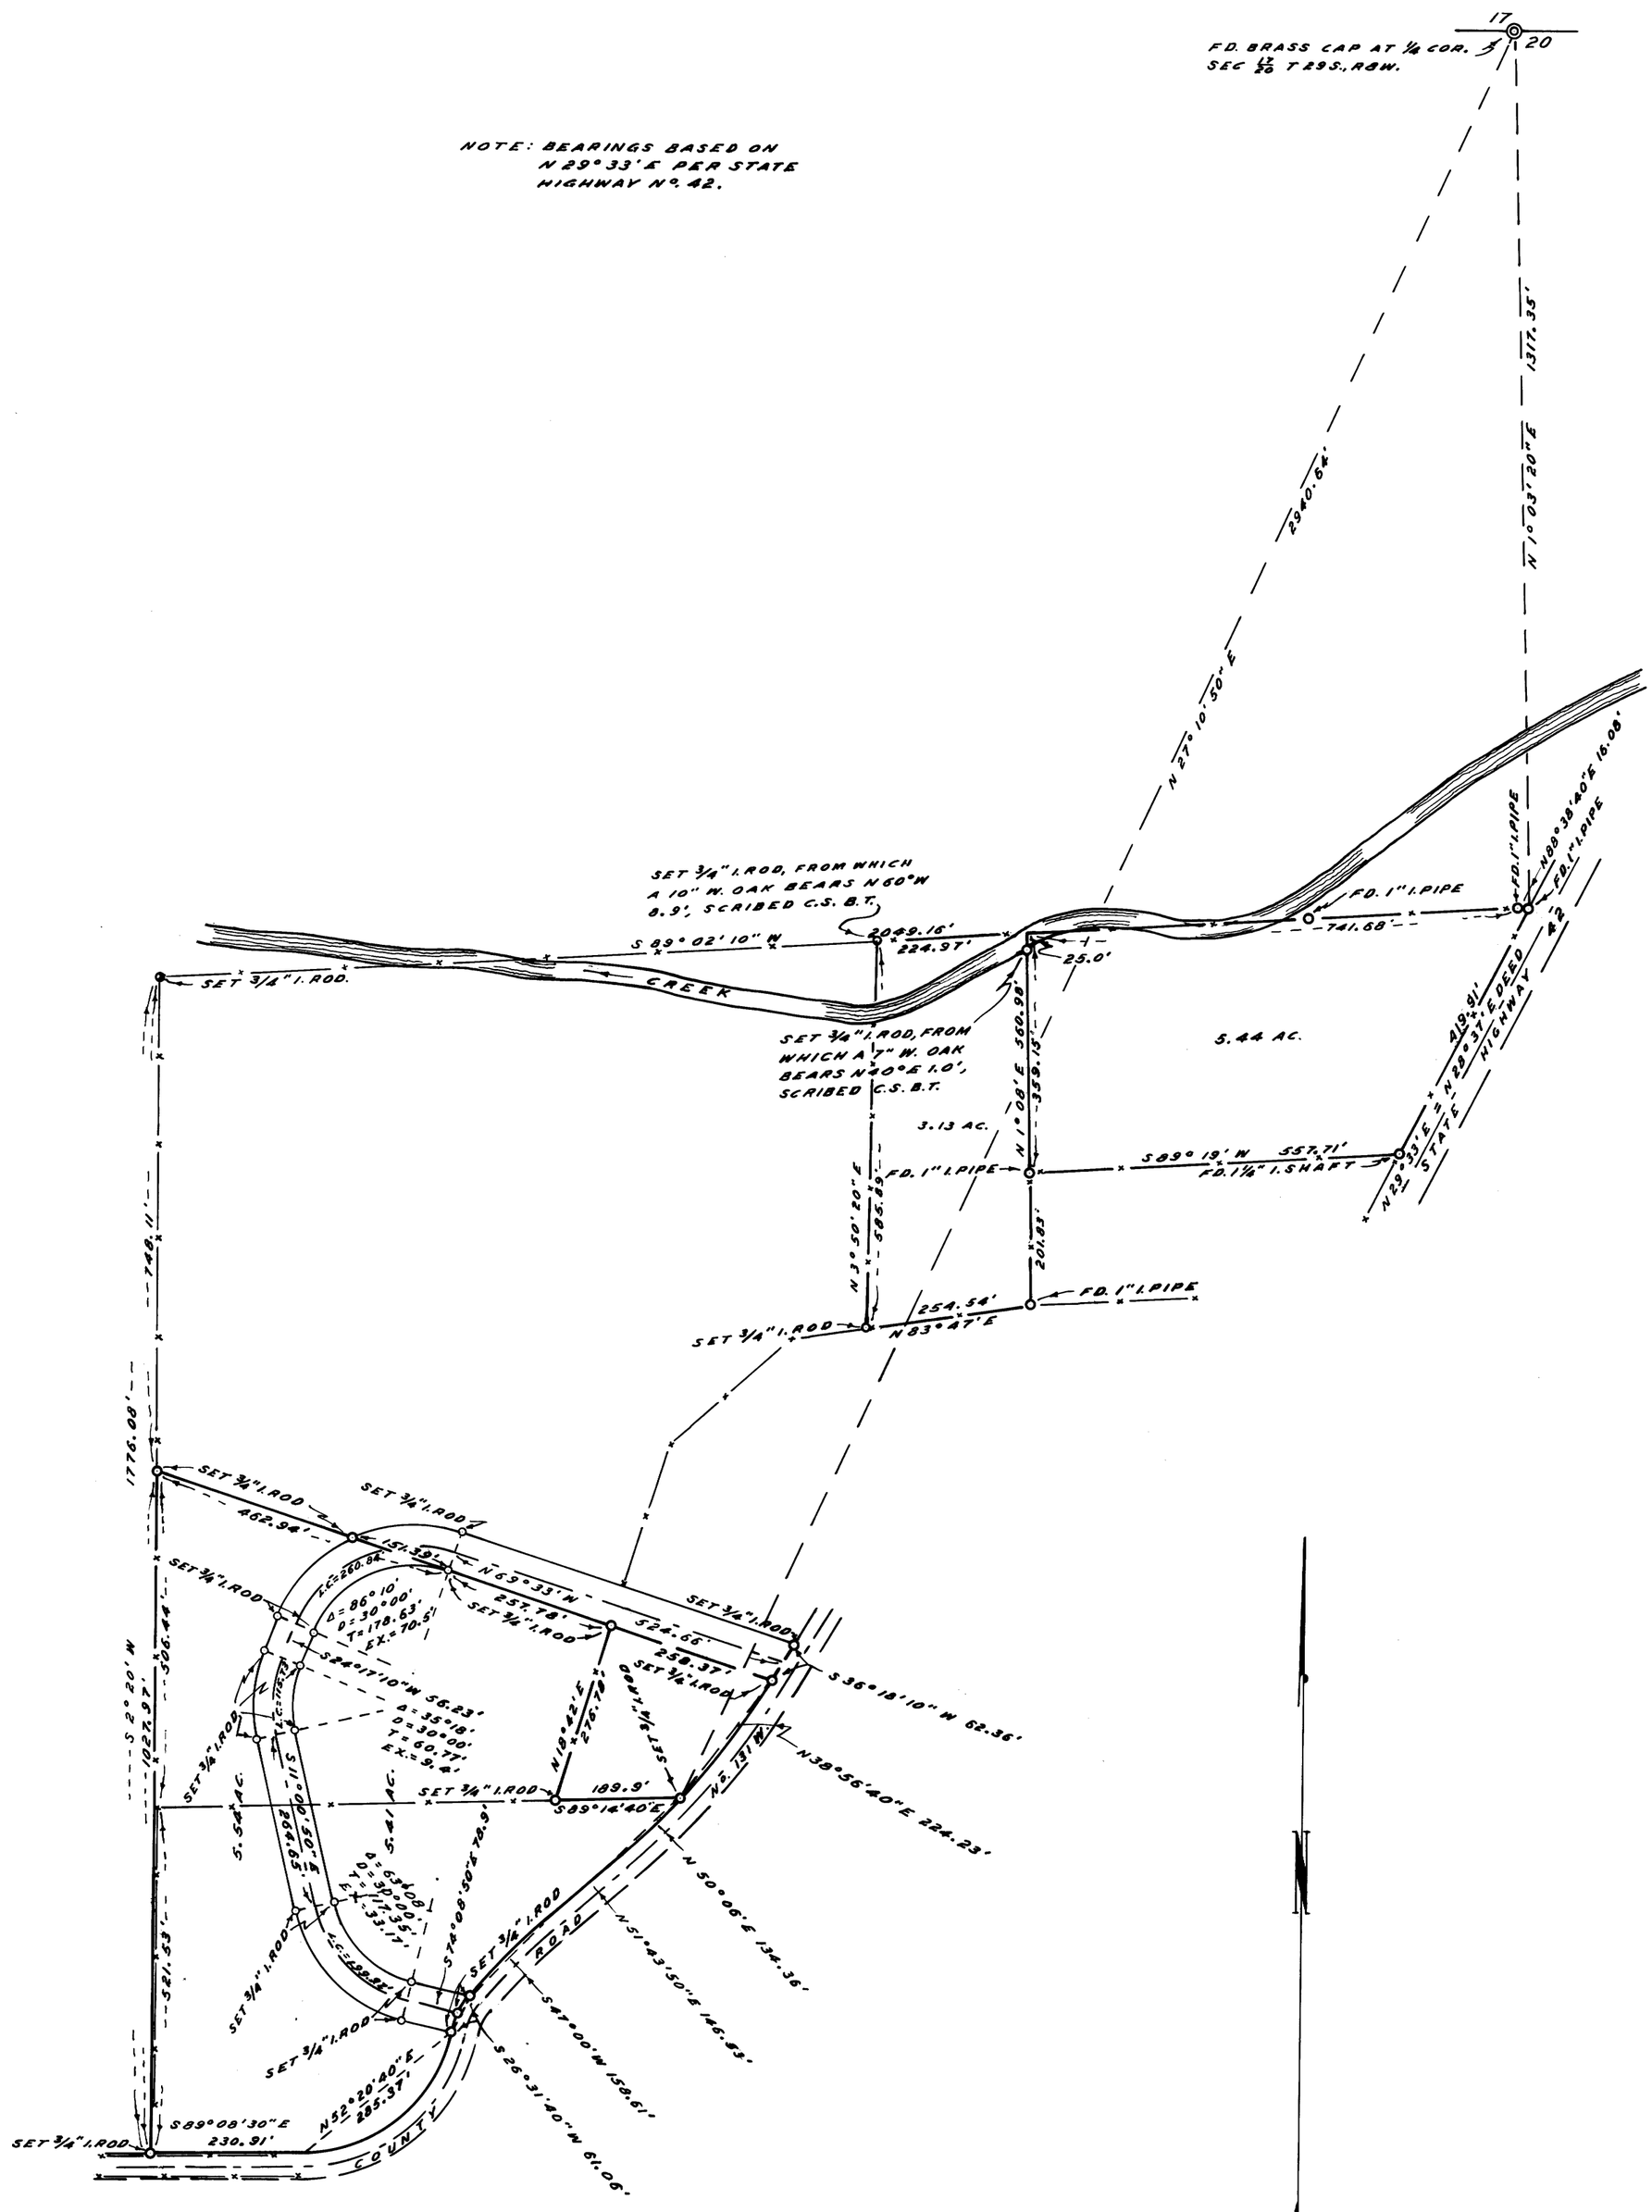

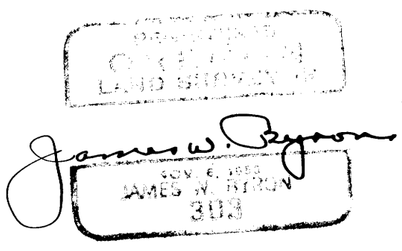

COUNTY SURVEYOR'S OFFICE
DOUGLAS COUNTY, OREGON

SURVEY FOR DEED DESCRIPTION
SECTION 20, T.29S., R.8 W., W.M.

FRED M. DARBY — COUNTY SURVEYOR
SURVEYED FEB. 21, 1961 — BY
JAMES W. BYRON - DEPUTY — SCALE 1" = 200'
SURVEYED FOR SCHOOL DIST. No 21

NOTE:
THE 3.13 ACRE PARCEL SHOWN ABOVE, WAS SURVEYED AND ADDED TO THIS MAP MAR. 22, 1961, FOR SCHOOL DIST. No 21.

COUNTY SURVEYORS FILE DA
DO NOT REMOVE FROM OF

C.S. FILE 52/69
M20-18