SECTION 31
T. 30 S., R. 5 W. W.M.

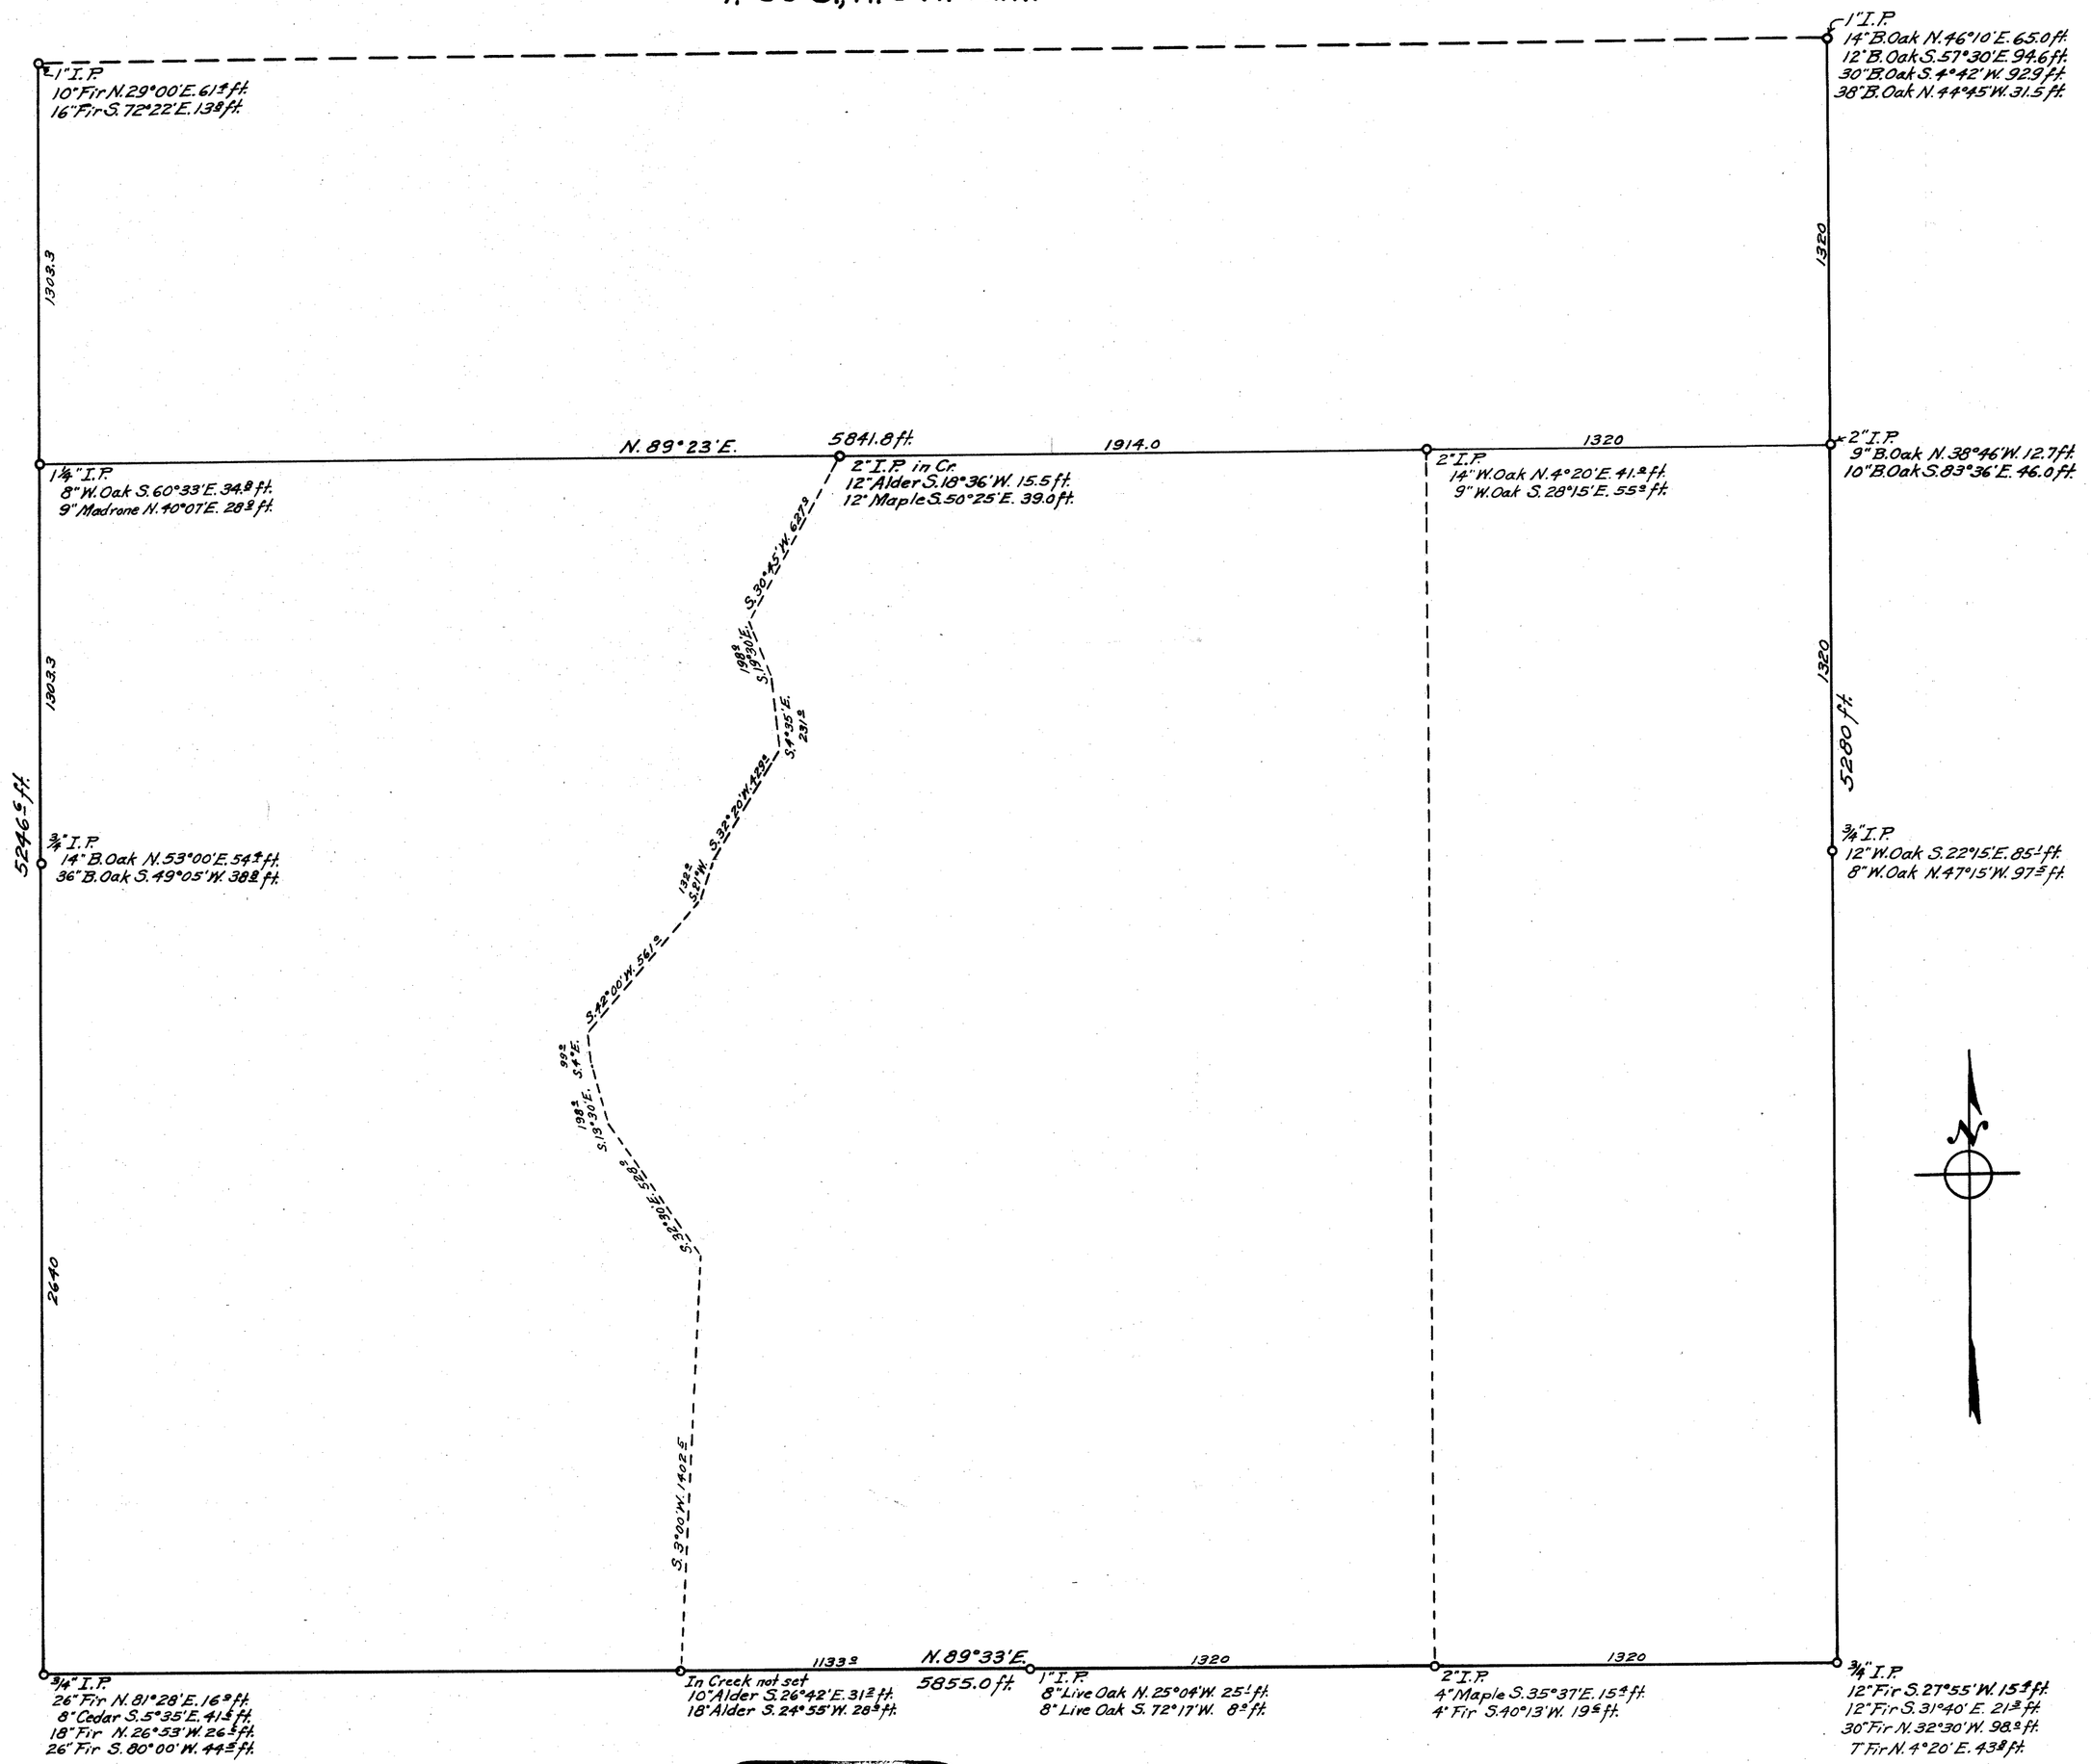

REGISTERED
OREGON
LAND SURVEYOR
Geo. J. Wenderoth
MARCH 10, 1944
George J. Wenderoth
5

COUNTY SURVEYOR'S OFFICE
DOUGLAS COUNTY, OREGON
Survey For
E. L. Pfaff Sept. 1946
W. Austin March 1946

Scale 1" = 400 ft.

COUNTY SURVEYORS FILE
DO NOT REMOVE FROM OFF

MAP FILE M20-24
C.S. File 44/151
Map File M20-24