COUNTY SURVEYORS FILE DATA
DO NOT REMOVE FROM OFFICE

SURVEY FOR DEED DESCRIPTIONS

IN SECTIONS 11 & 12, T.22 S, R.6 W.W.M.

Scale 1" = 100' Jan. 1961

FOR: ANDY HARRIS

REGISTERED
OREGON
LAND SURVEYOR
Wilford N. Haines
MAY 7, 1948
WILFORD N. HAINES
229

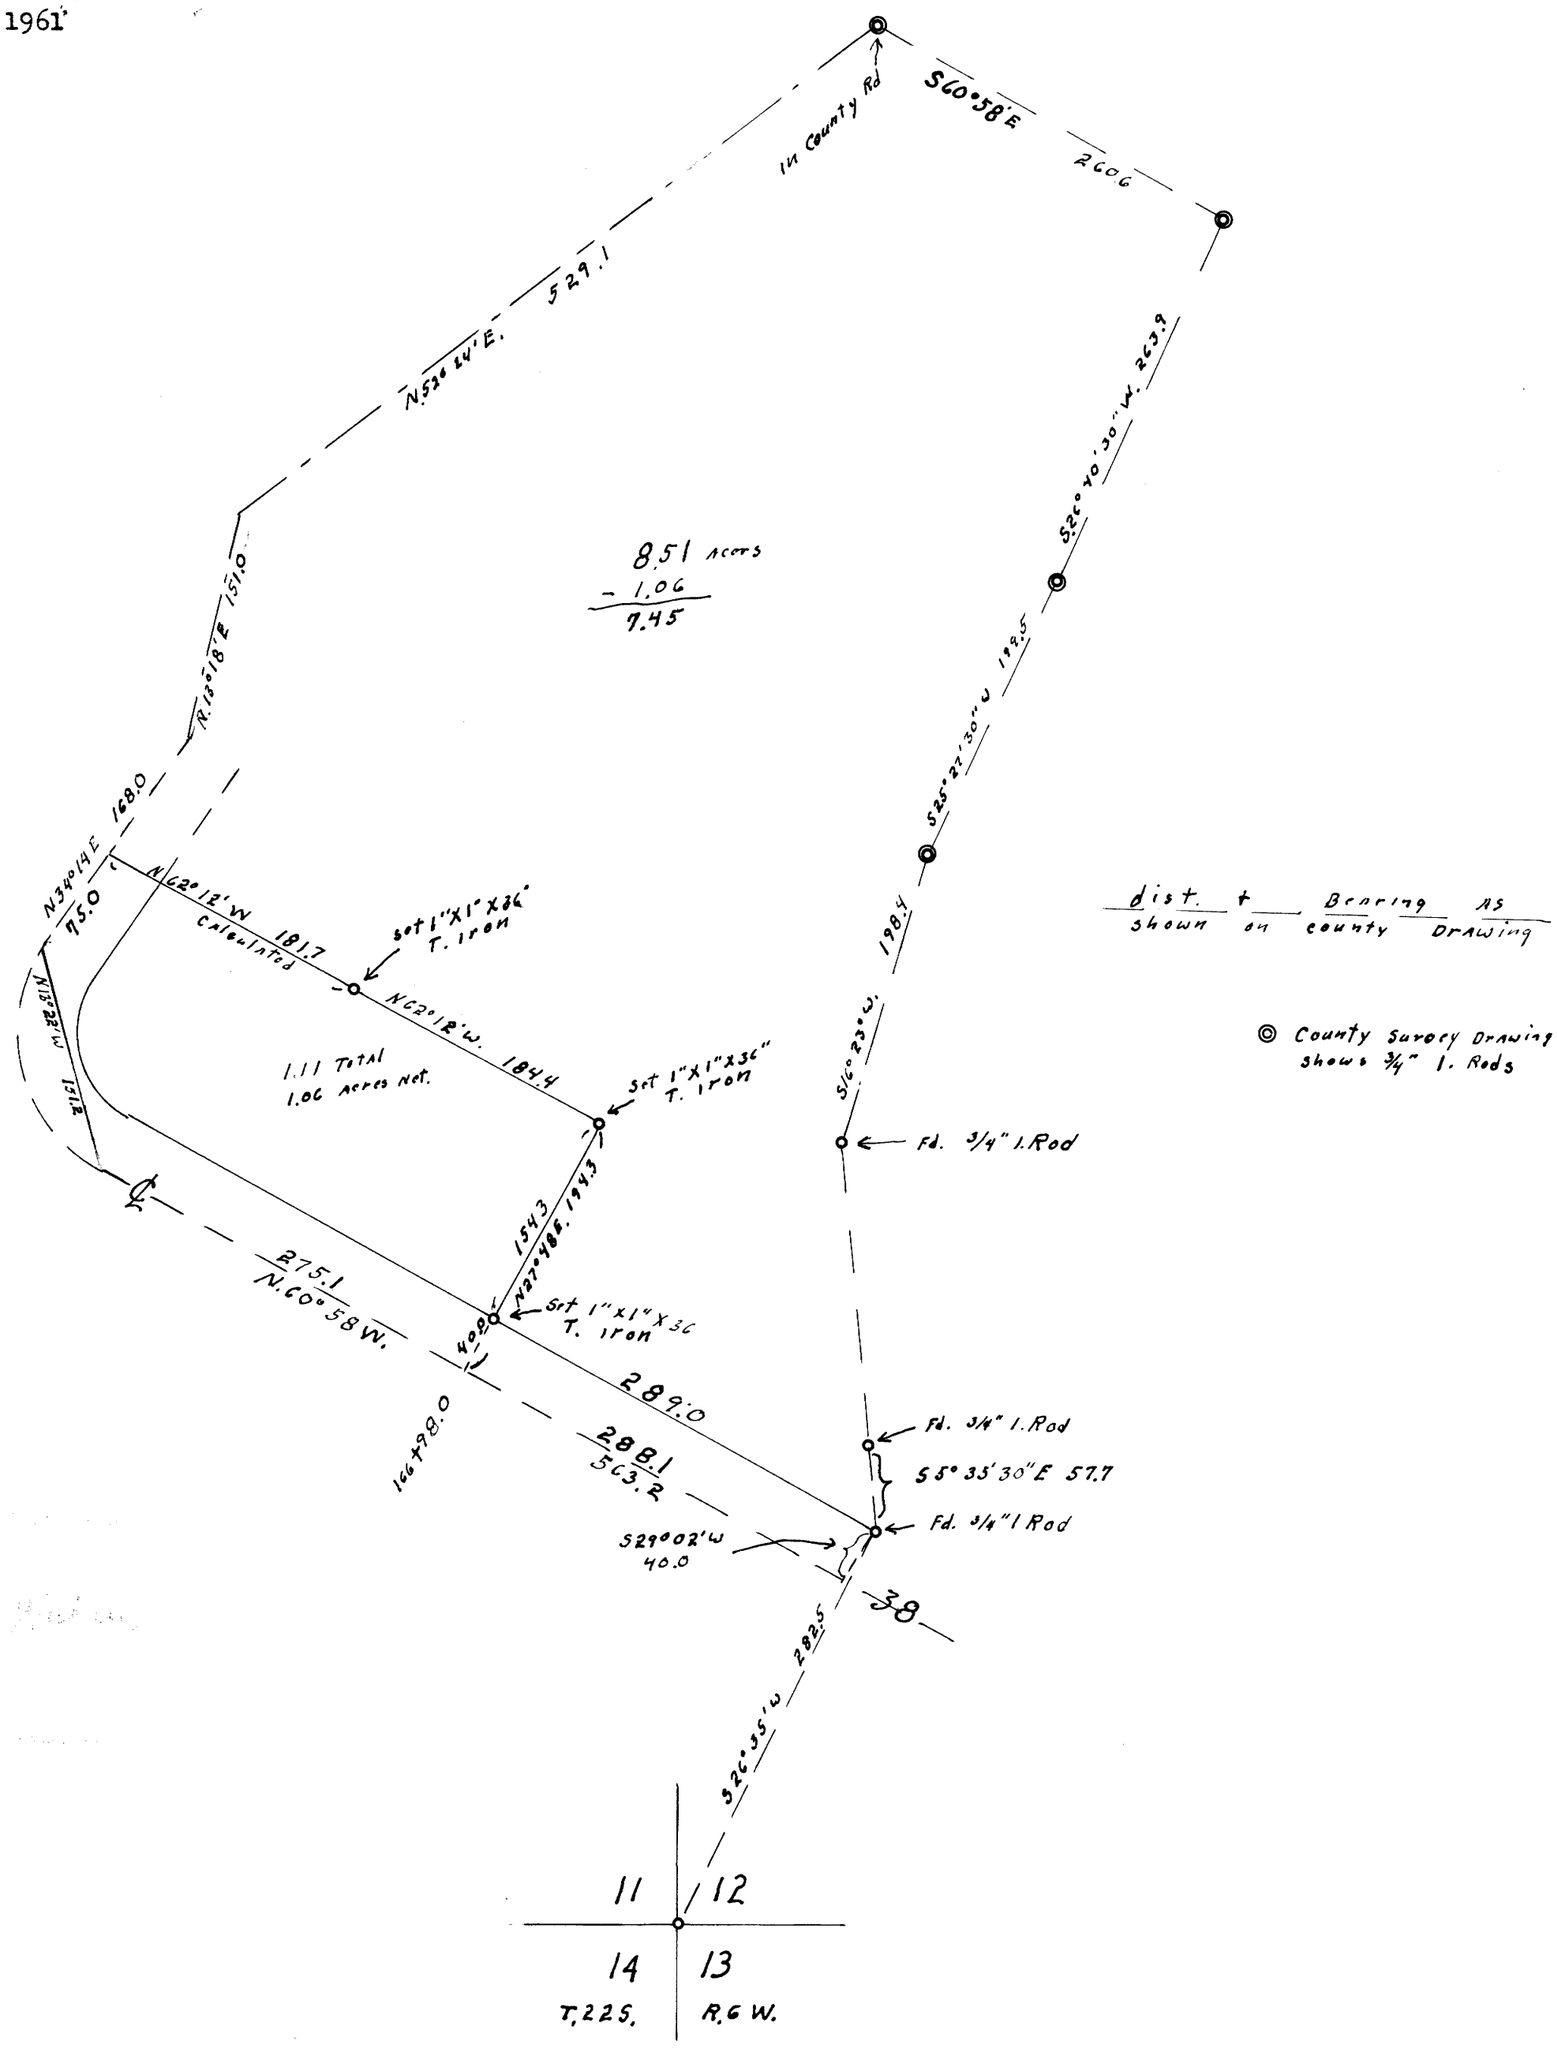

dist. + Bearing AS
shown on county Drawing

◎ County Survey Drawing shows 3/4" I. Rods

FILED
RECEIVED
MAY
COUNTY SURVEYOR
DOUGLAS COUNTY, ORE.

MAP FILE M 20 + 37