F.B. H-169
M 20-46

COUNTY SURVEYORS FILE DATA
DO NOT REMOVE FROM OFFICE

REGISTERED
OREGON
LAND SURVEYOR
Wilford N. Haines
MAY 7, 1946
WILFORD N. HAINES
239

SECT. 25, T.23 S., R.6 W. W.M.

for

Wayne K. Rice Oakland Oregon.

May 15, 1961. Scale 1" = 500'.

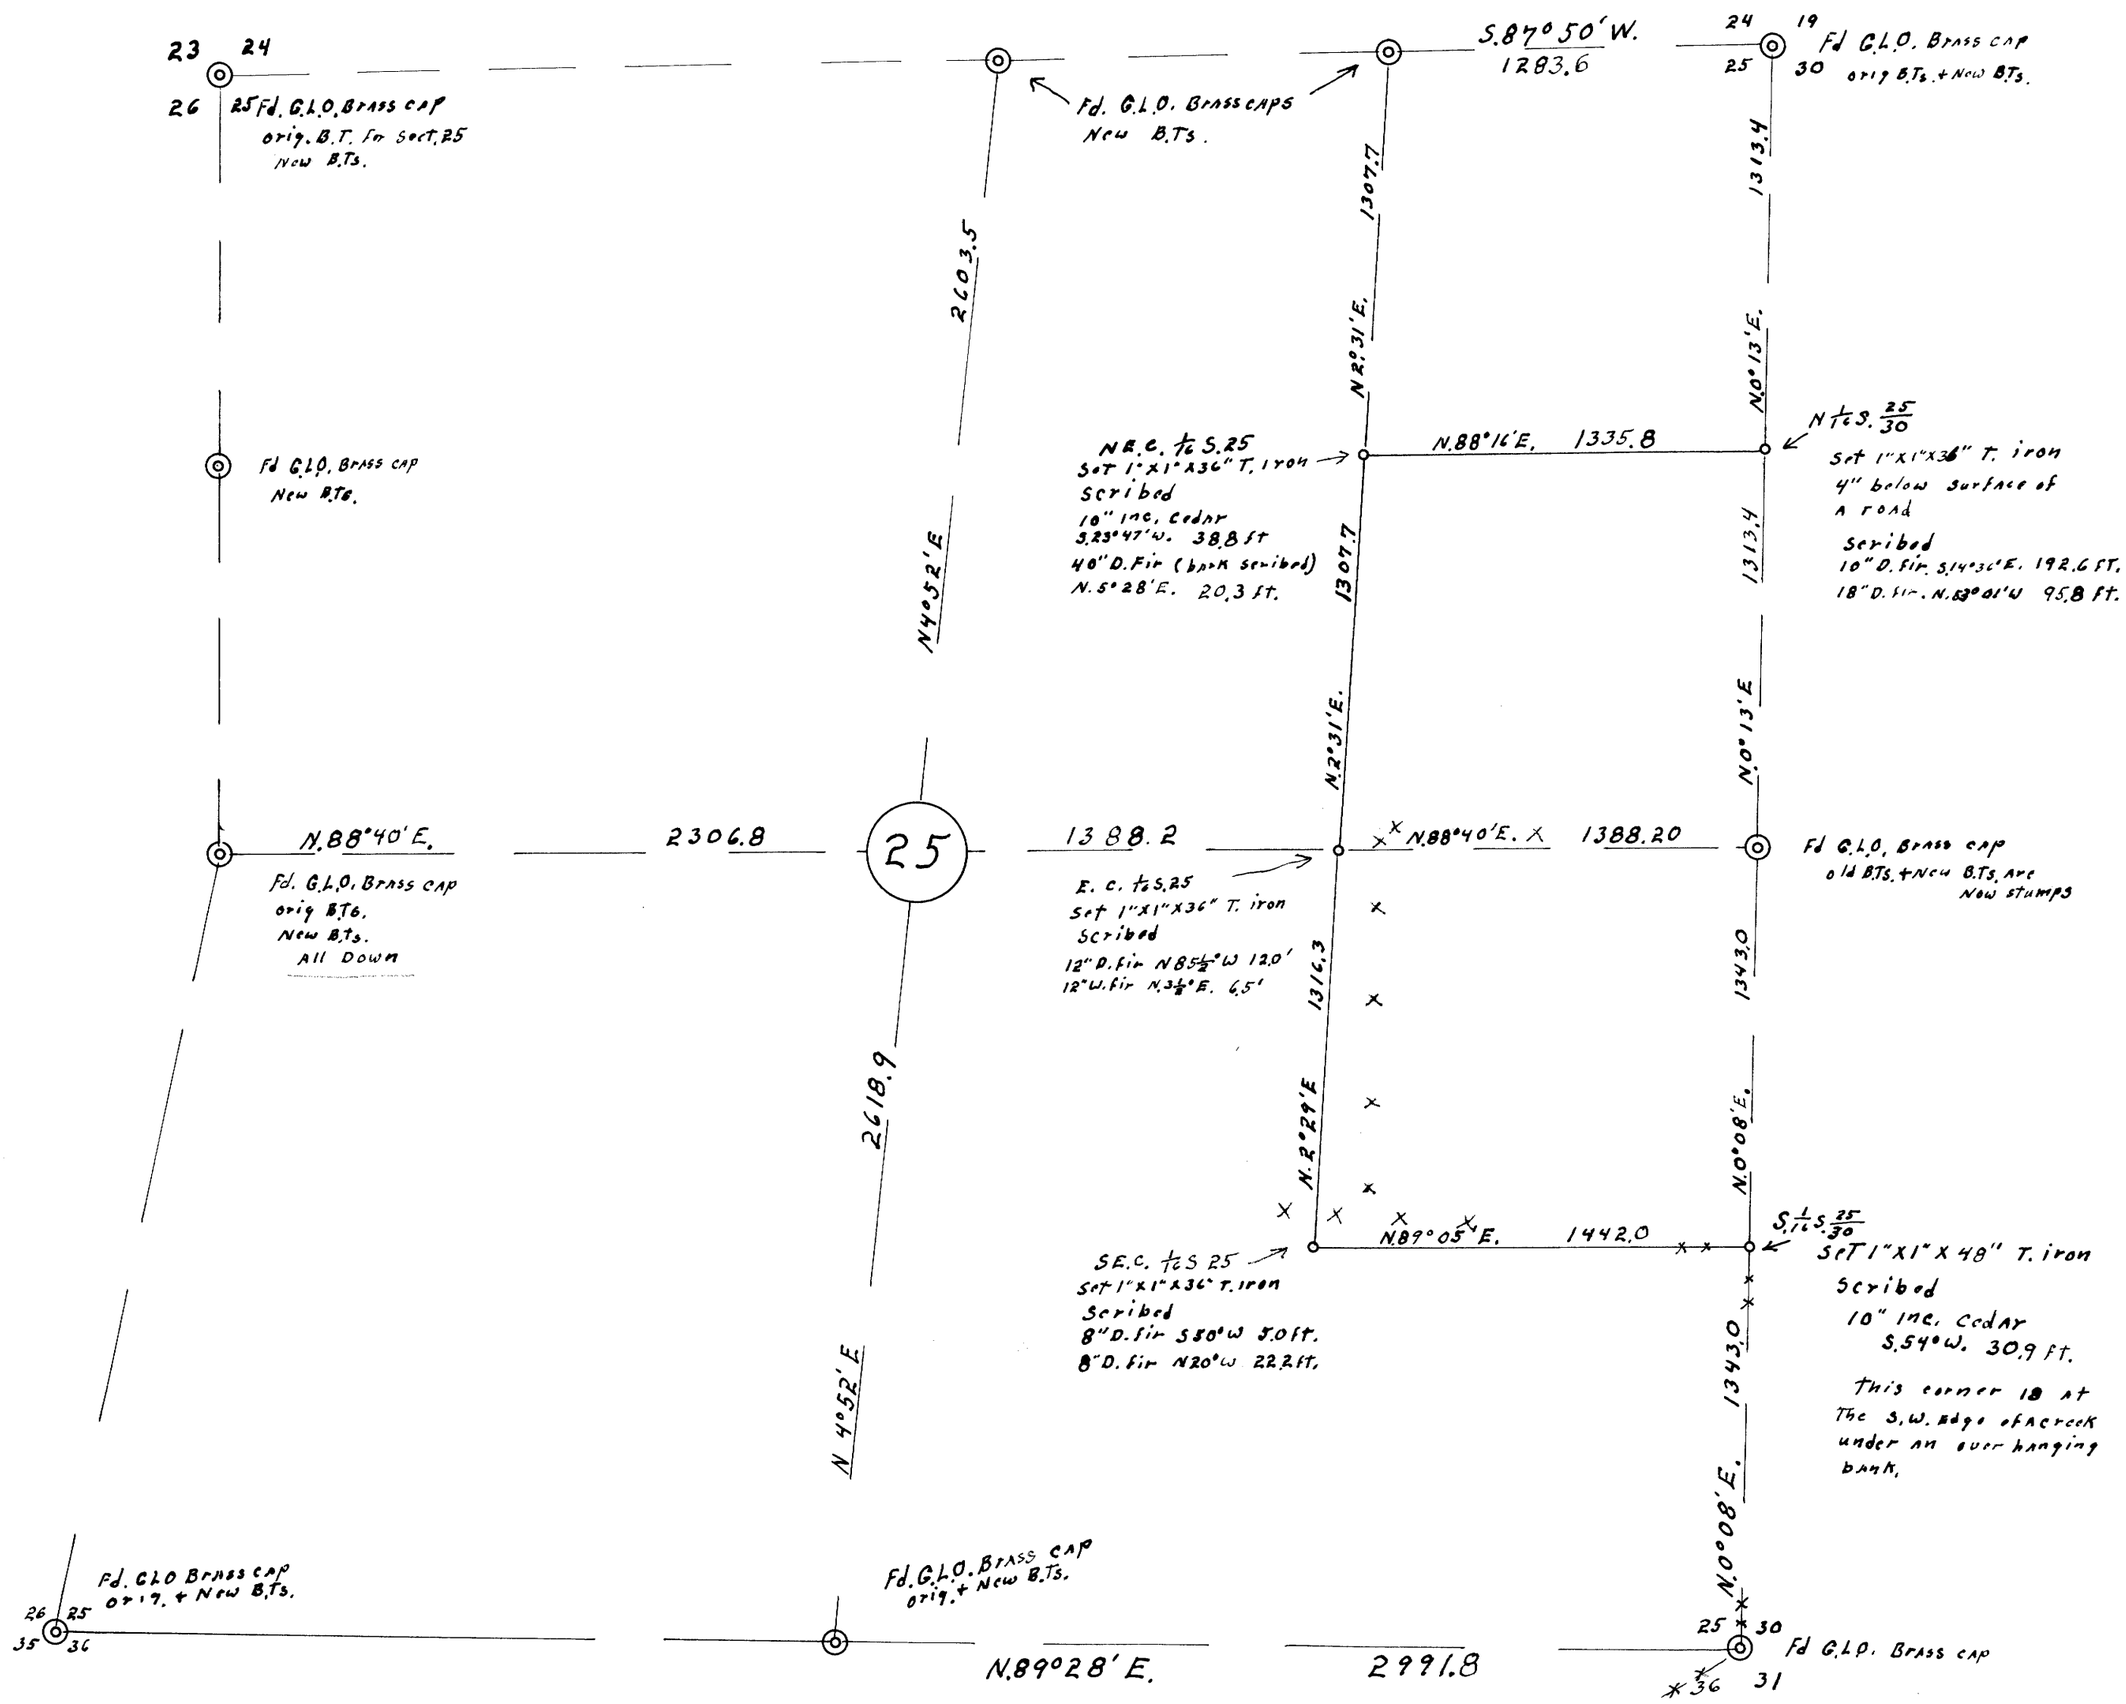

FILED
RECEIVED
MAY 9 1961
COUNTY SURVEYOR
DOUGLAS COUNTY, ORE.

F.B. H-169
MAP FILE M 20-46