COUNTY SURVEYORS FILE DATA
DO NOT REMOVE FROM OFFICE

SURVEY OF LOT 12, 13, & E 13.5 AC. LOT 14, PLAT E, UMPQUA PARK FRUIT LANDS, DOUGLAS COUNTY, OREGON

SURVEYED FOR: C. E. SPAULDING — MAY, 1961

SURVEYED BY: G. R. LECKLIDER - ENGINEER — SCALE: 1" = 200'

○ DENOTES STEEL TUBE WITH SURVEY CAP SET.

NOTE: ALL BEARINGS BASED ON SOLAR OBSERVATION REFER TO C.S. FILE M 1-53.

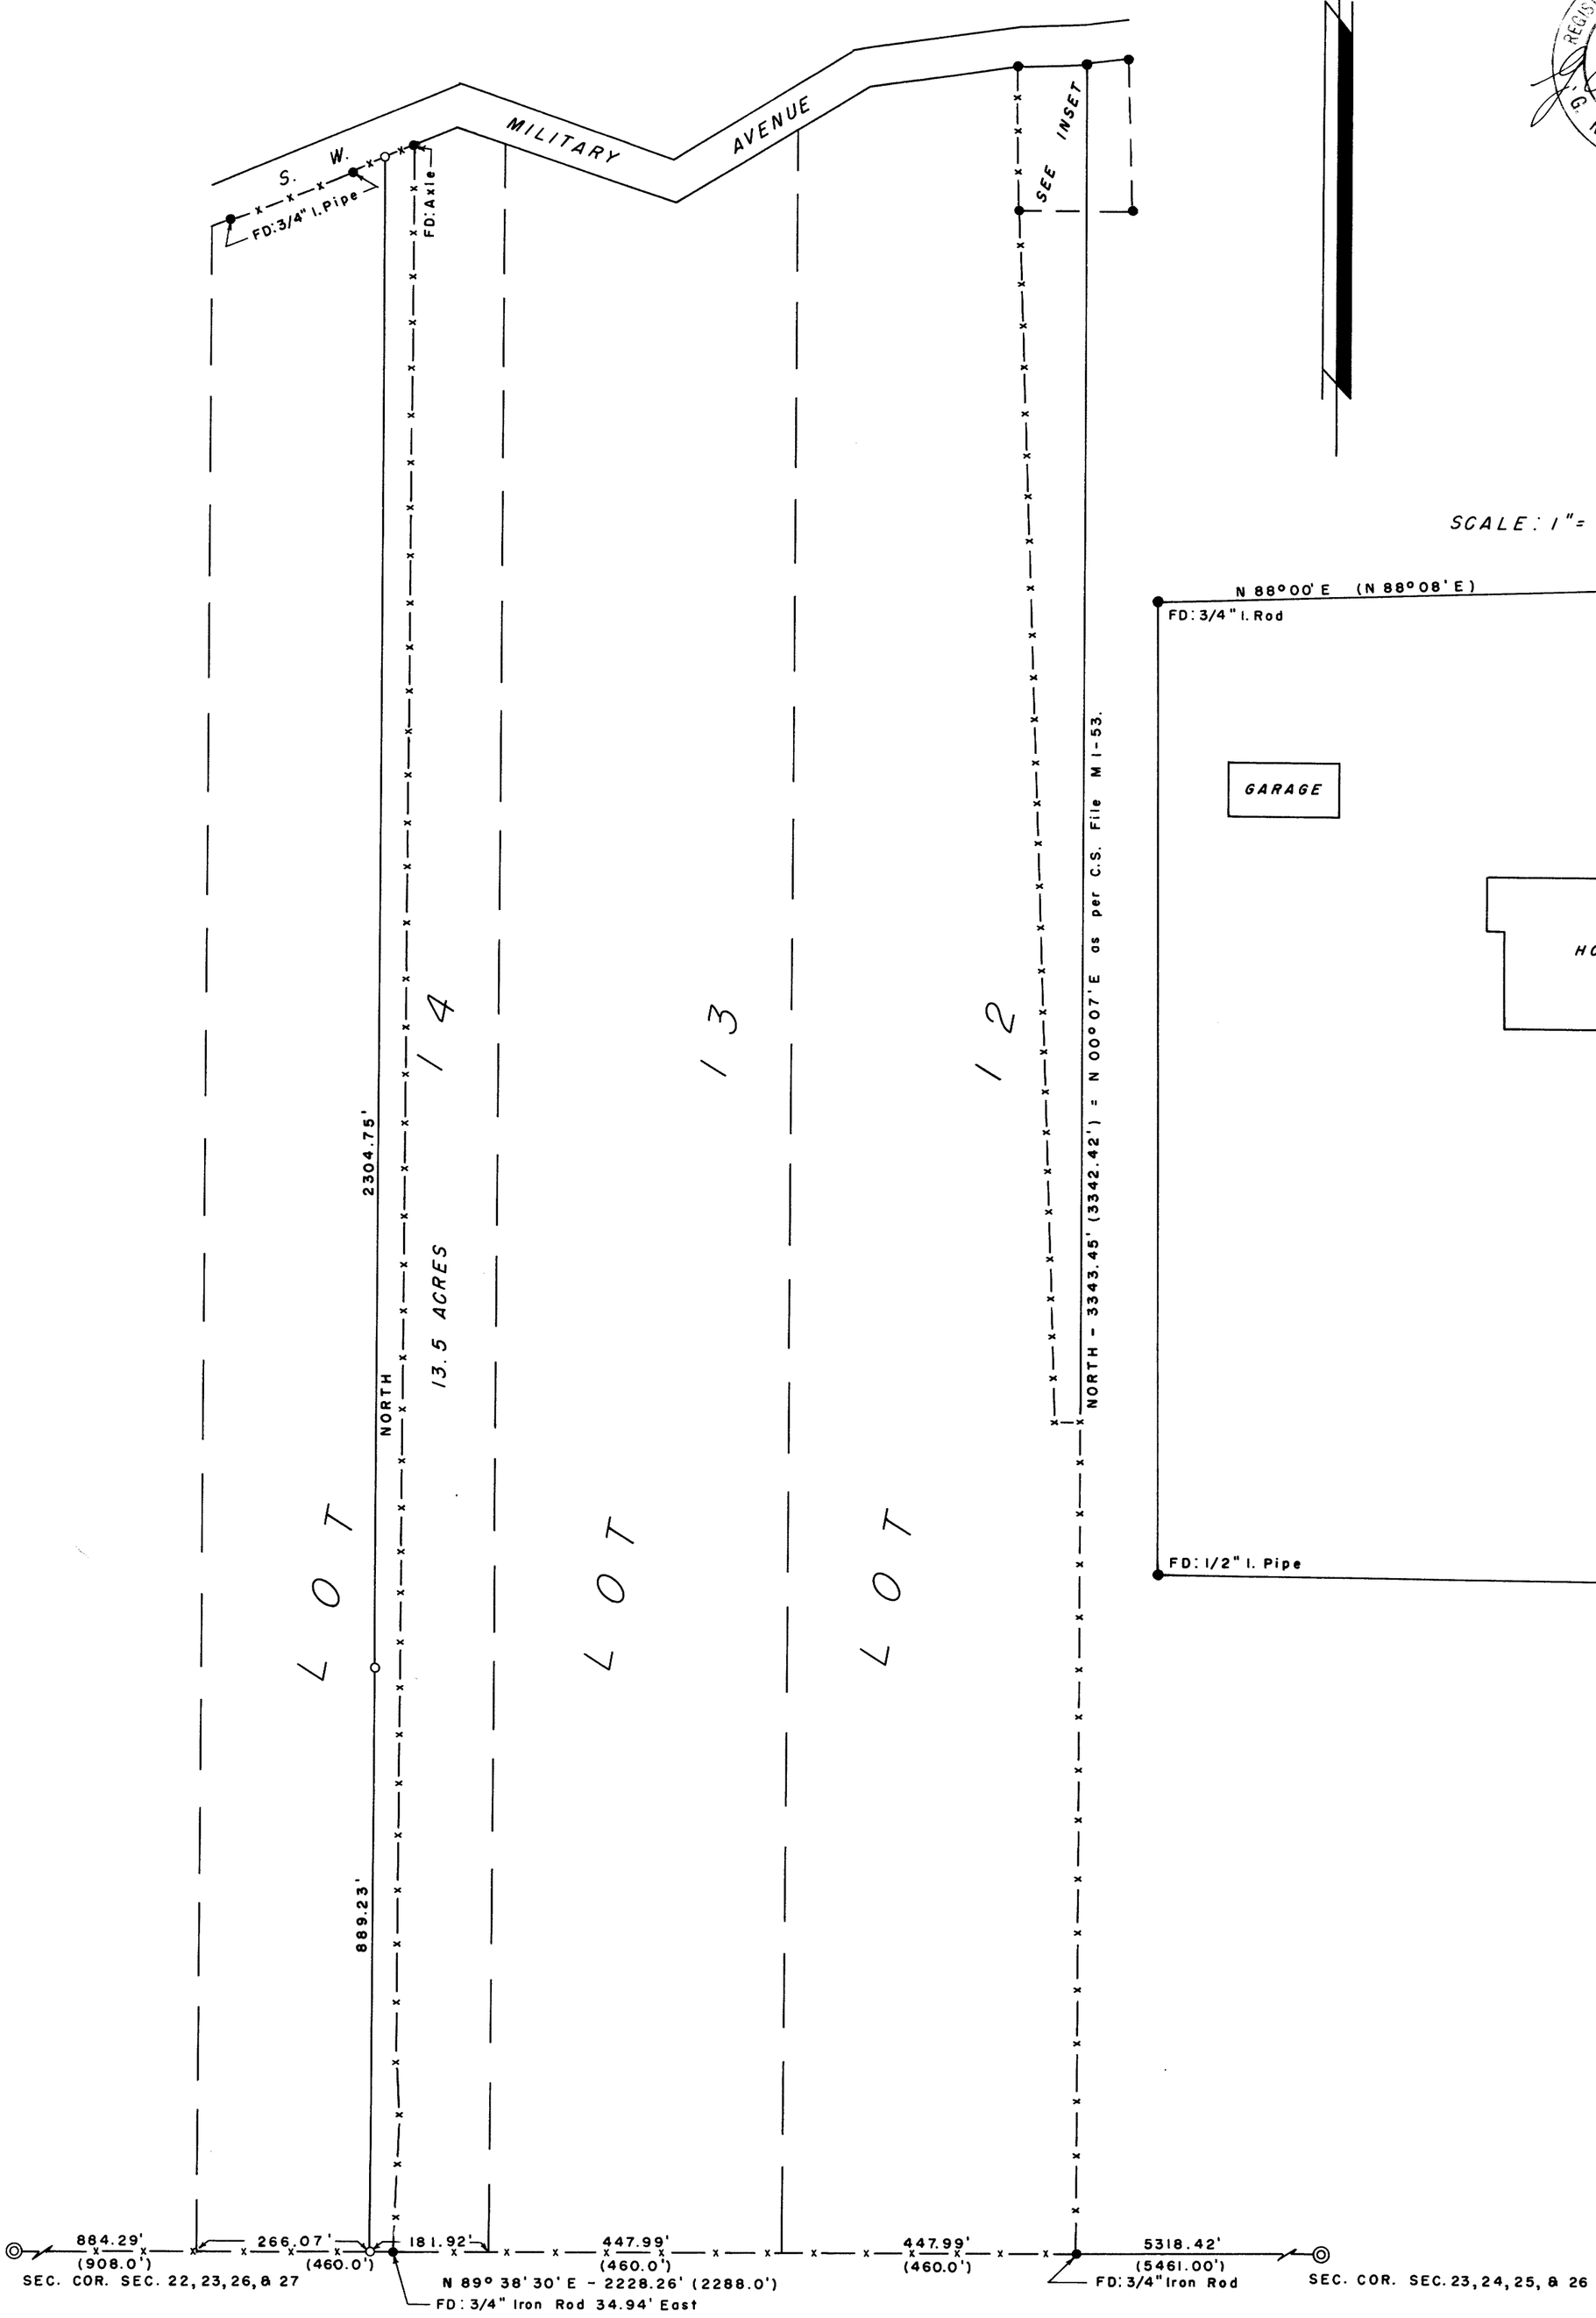

SCALE: 1" = 30'

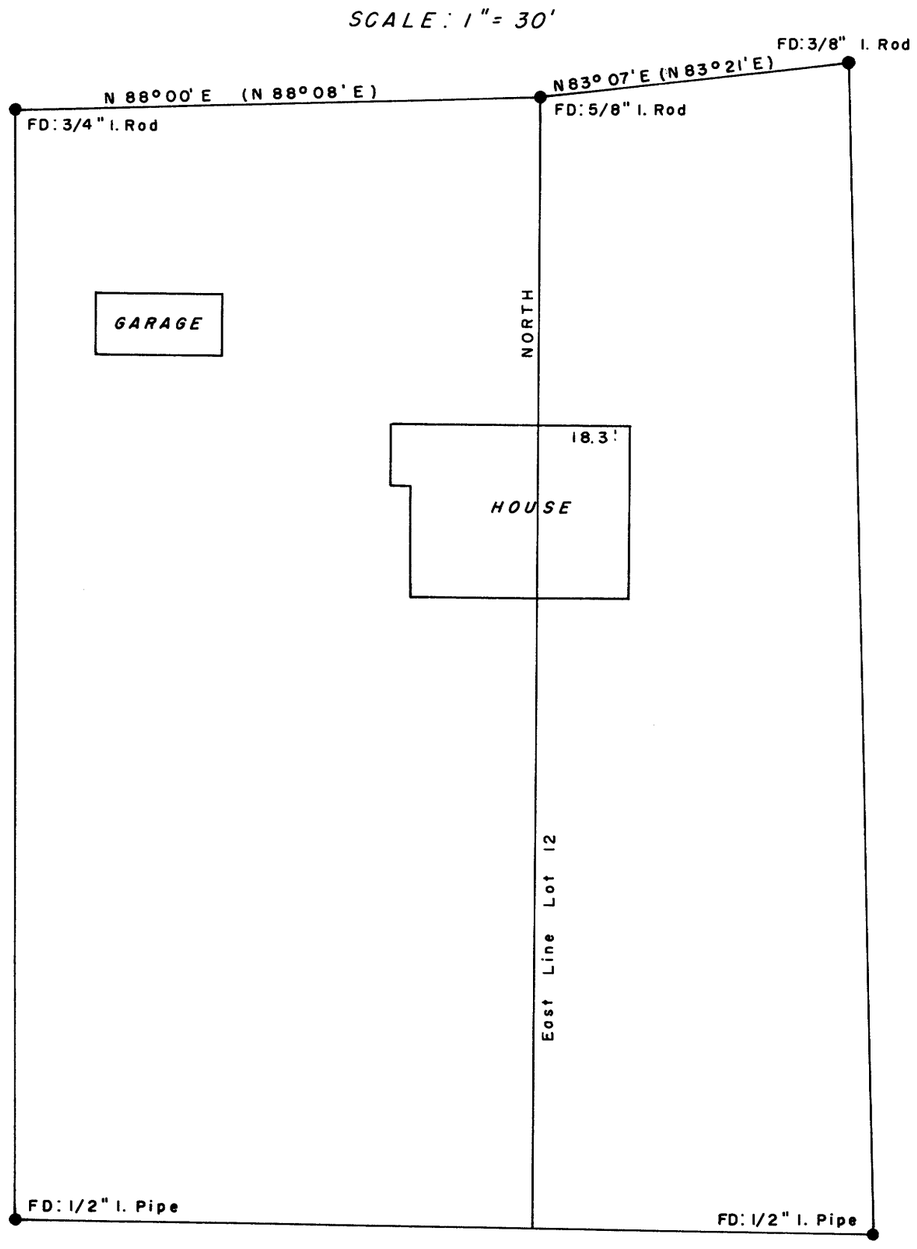

FILED
RECEIVED
JUN 2 1961
COUNTY SURVEYOR
DOUGLAS COUNTY, ORE.

MAP FILE M 20-49