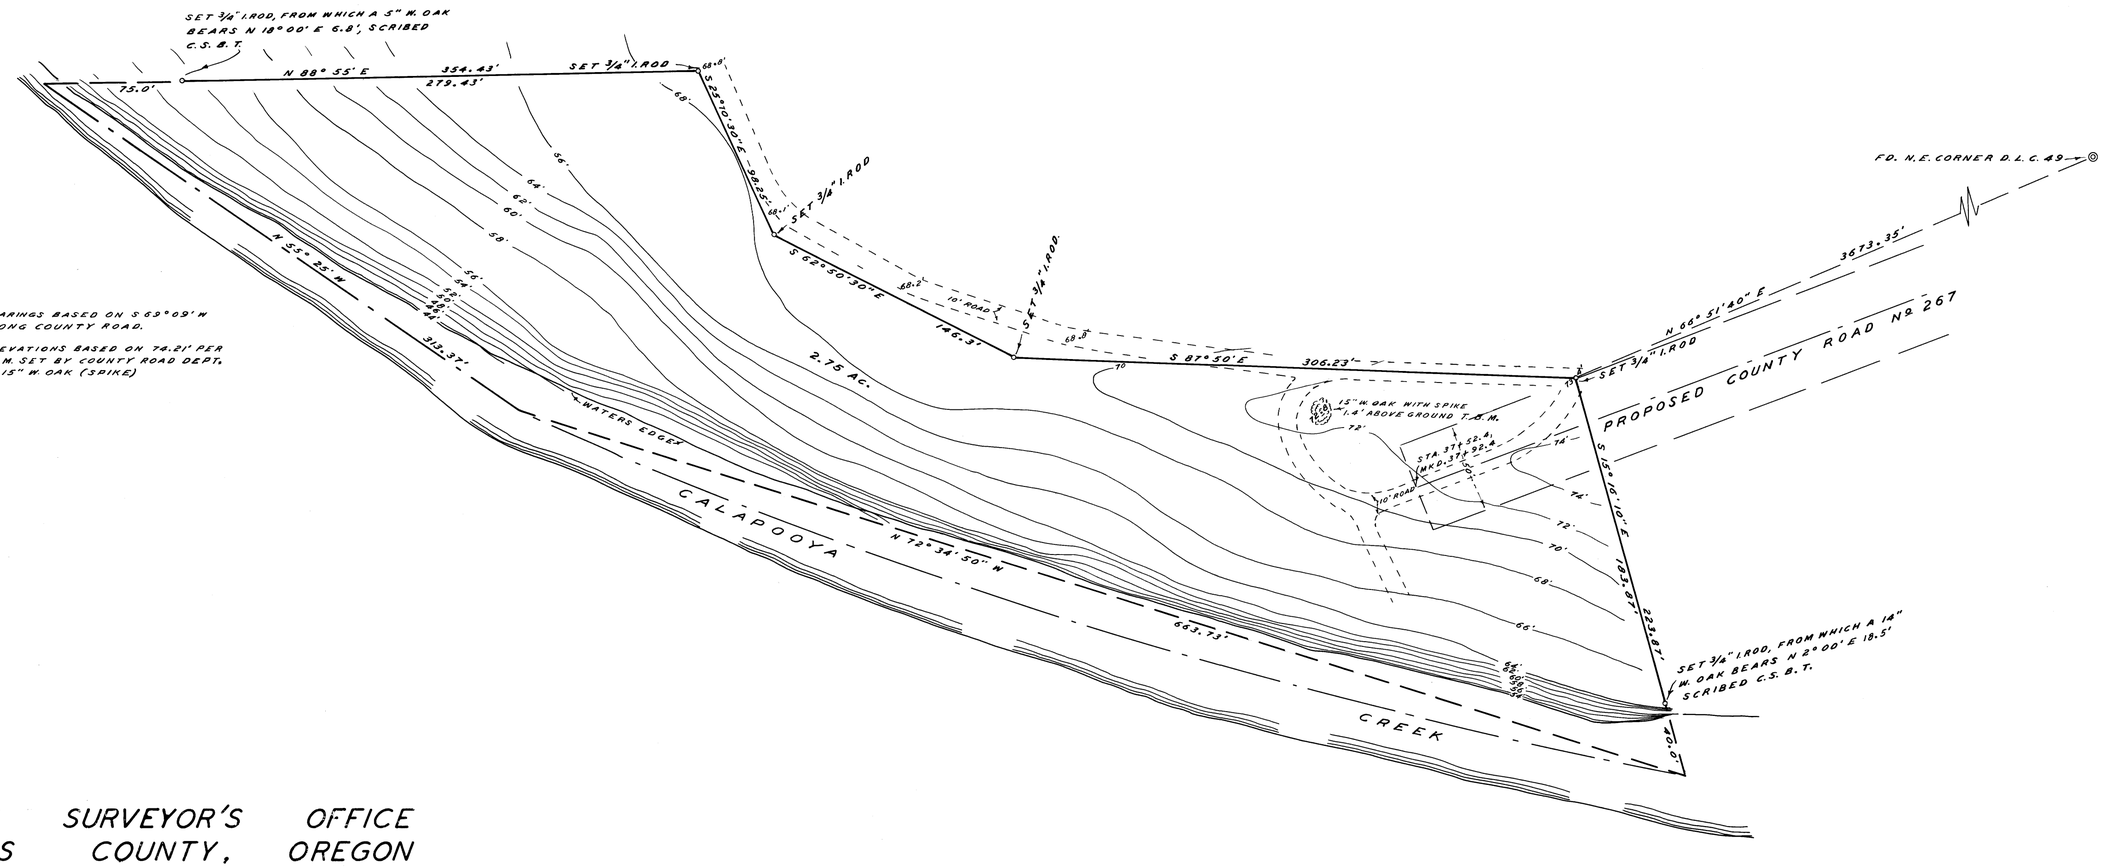


NOTE: BEARINGS BASED ON S 69° 09' W ALONG COUNTY ROAD.

ELEVATIONS BASED ON 74.21' PER T.B.M. SET BY COUNTY ROAD DEPT. ON 15" W. OAK (SPIKE)

COUNTY SURVEYOR'S OFFICE
DOUGLAS COUNTY, OREGON

SURVEY FOR DEED DESCRIPTION,
SECTION 9, T25S. R4W, W.M.

FRED M. DARBY — COUNTY SURVEYOR
SURVEYED JUNE 27, 1961 — BY
JAMES W. BYRON - DEPUTY — SCALE 1" = 50'
SURVEYED FOR CO. PARK DEPT.

REGISTERED OREGON LAND SURVEYOR
James W. Byron
JAMES W. BYRON
1973

COUNTY SURVEYORS FILE
DO NOT REMOVE FROM OFFICE

C.S. FILE 58/03
N 20-33

C.S. FILE 57/03
FL-48 N