

SL-02 W

sect 12 T 23 S R 7 W. W.M.

14'

To get To N $\frac{1}{4}$  go down  
Brads Creek Road

To A sign  
Snellstrom tree from  
9000 up creek to  
North

Lat 5254.51  
Dep 34.53  
Found original Cor.  
Set 1"X1"X36" T  
iron

Lat 5260.29  
Dep 2567.76  
Creek

2533.23  
S 89° 52' W

2645.98  
N 89° 54' W

Fd Both orig. Bts. &  
A scribed cedar  
tree at point for  
1/4 for Set 1"X1"X36"  
iron 2.56' west of Cor. tree

Fd G.L.O.  
BRASS CAP  
And orig Bts.

24" W Fir, N 58° W, 31.5  
30" Fir, S 35° E, 29.5

Lat 2.34  
Dep 2549.13  
99° 57'

8" Myrtle, N 0° 30' E, 21.13  
14" Maple, S 61° 40' N, 37.9

Lat 3934.66  
Dep 2567.25

Lat 3937.00  
Dep 18.12

N 89° 57' W

2549.13

Set 1"X1"X36"  
T. iron

Due to the Moving of SW Cor  
These corners would ALL  
MOVE North Along this line

Tree farm sign  
44" Fir, S 29° W, 10.5  
36" Fir, N 25° E, 45.4  
30" Fir, S 78° E, 23.0  
29" ced., N 50° W, 12.0

Lat 2609.06  
Dep. 2566.25

189° 46' W  
5219.22  
2654.22

Lat 2641.95  
Dep 5220.84

Not Set  
This Cor. has been  
set by B.L.M.

Lat. 2619.50  
Dep 1.32

2565.00

Fd. Both old  
Bts. - Fir down -  
Set 1"X1"X36" T. Iron  
There is an iron pipe  
by T. iron now and  
Brads (both Bts. gone)

20" Myrtle, S 55° 07' E, 35.0  
12" Myrtle, N 45° 26' W, 29.0  
N. 89° 12' E

18" Fir, N 70° E, 43.8  
14" Fir, S 48° E, 36.0  
28" Laurel, N 52° W, 66.0  
12" Fir, S 71° W, 59.5

Lat 1345.77  
Dep 2565.36

Lat 1309.75  
Dep. 0.86

2564.76

This point fall on  
old down tree drove  
Nail in log at point for  
to Cor.

Logged

5177.79  
2527.11

1263.29

Not  
Logged  
1961

Set 1"X1"X36"  
T. Iron

N 88° 09' E  
2565.31

5177.79  
2527.11

Bridge

S 88° 49' E  
2664.62

S 89° 25' E 2644.30  
New Position of Cor.

Lat. 2720  
Dep. 5238.44


Fd. Maple Bt.  
S.W.

Not Logged  
1961

Fd. Both old Bts.  
(dead or dying)

Fd. G.L.O. BRASS CAP  
BRASS CAP WAS MOVED BY  
B.L.M. About N 33° 46' W 28.25 FT  
SINCE OUR SURVEY

Surveyed 1955

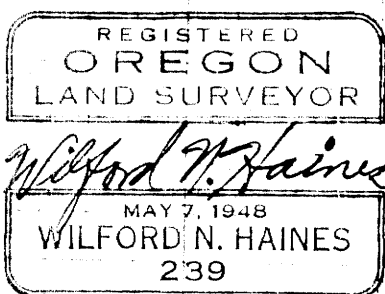

FILED  
RECEIVED

JUN 19 1961

COUNTY SURVEYOR  
DOUGLAS COUNTY, ORE.