MAP FILE M 20 - 79

COUNTY SURVEYORS FILE DATA
DO NOT REMOVE FROM OFFICE

SURVEY TO SET PROPERTY CORNERS IN BLOCKS 1&2, THOMAS' SUBDIVISION ROSEBURG, DOUGLAS COUNTY, OREGON.

SURVEYED FOR: MRS. LEO GOODMAN — JULY, 1961

SURVEYED BY: G. R. LECKLIDER - ENGINEER — SCALE: 1" = 30'

○ DENOTES STEEL TUBE WITH SURVEY CAP SET.

NOTE: Refer to C.S. File 45/105.

REGISTERED PROFESSIONAL ENGINEER 4079 OREGON OCT. 15, 1956 G. ROBERT LECKLIDER

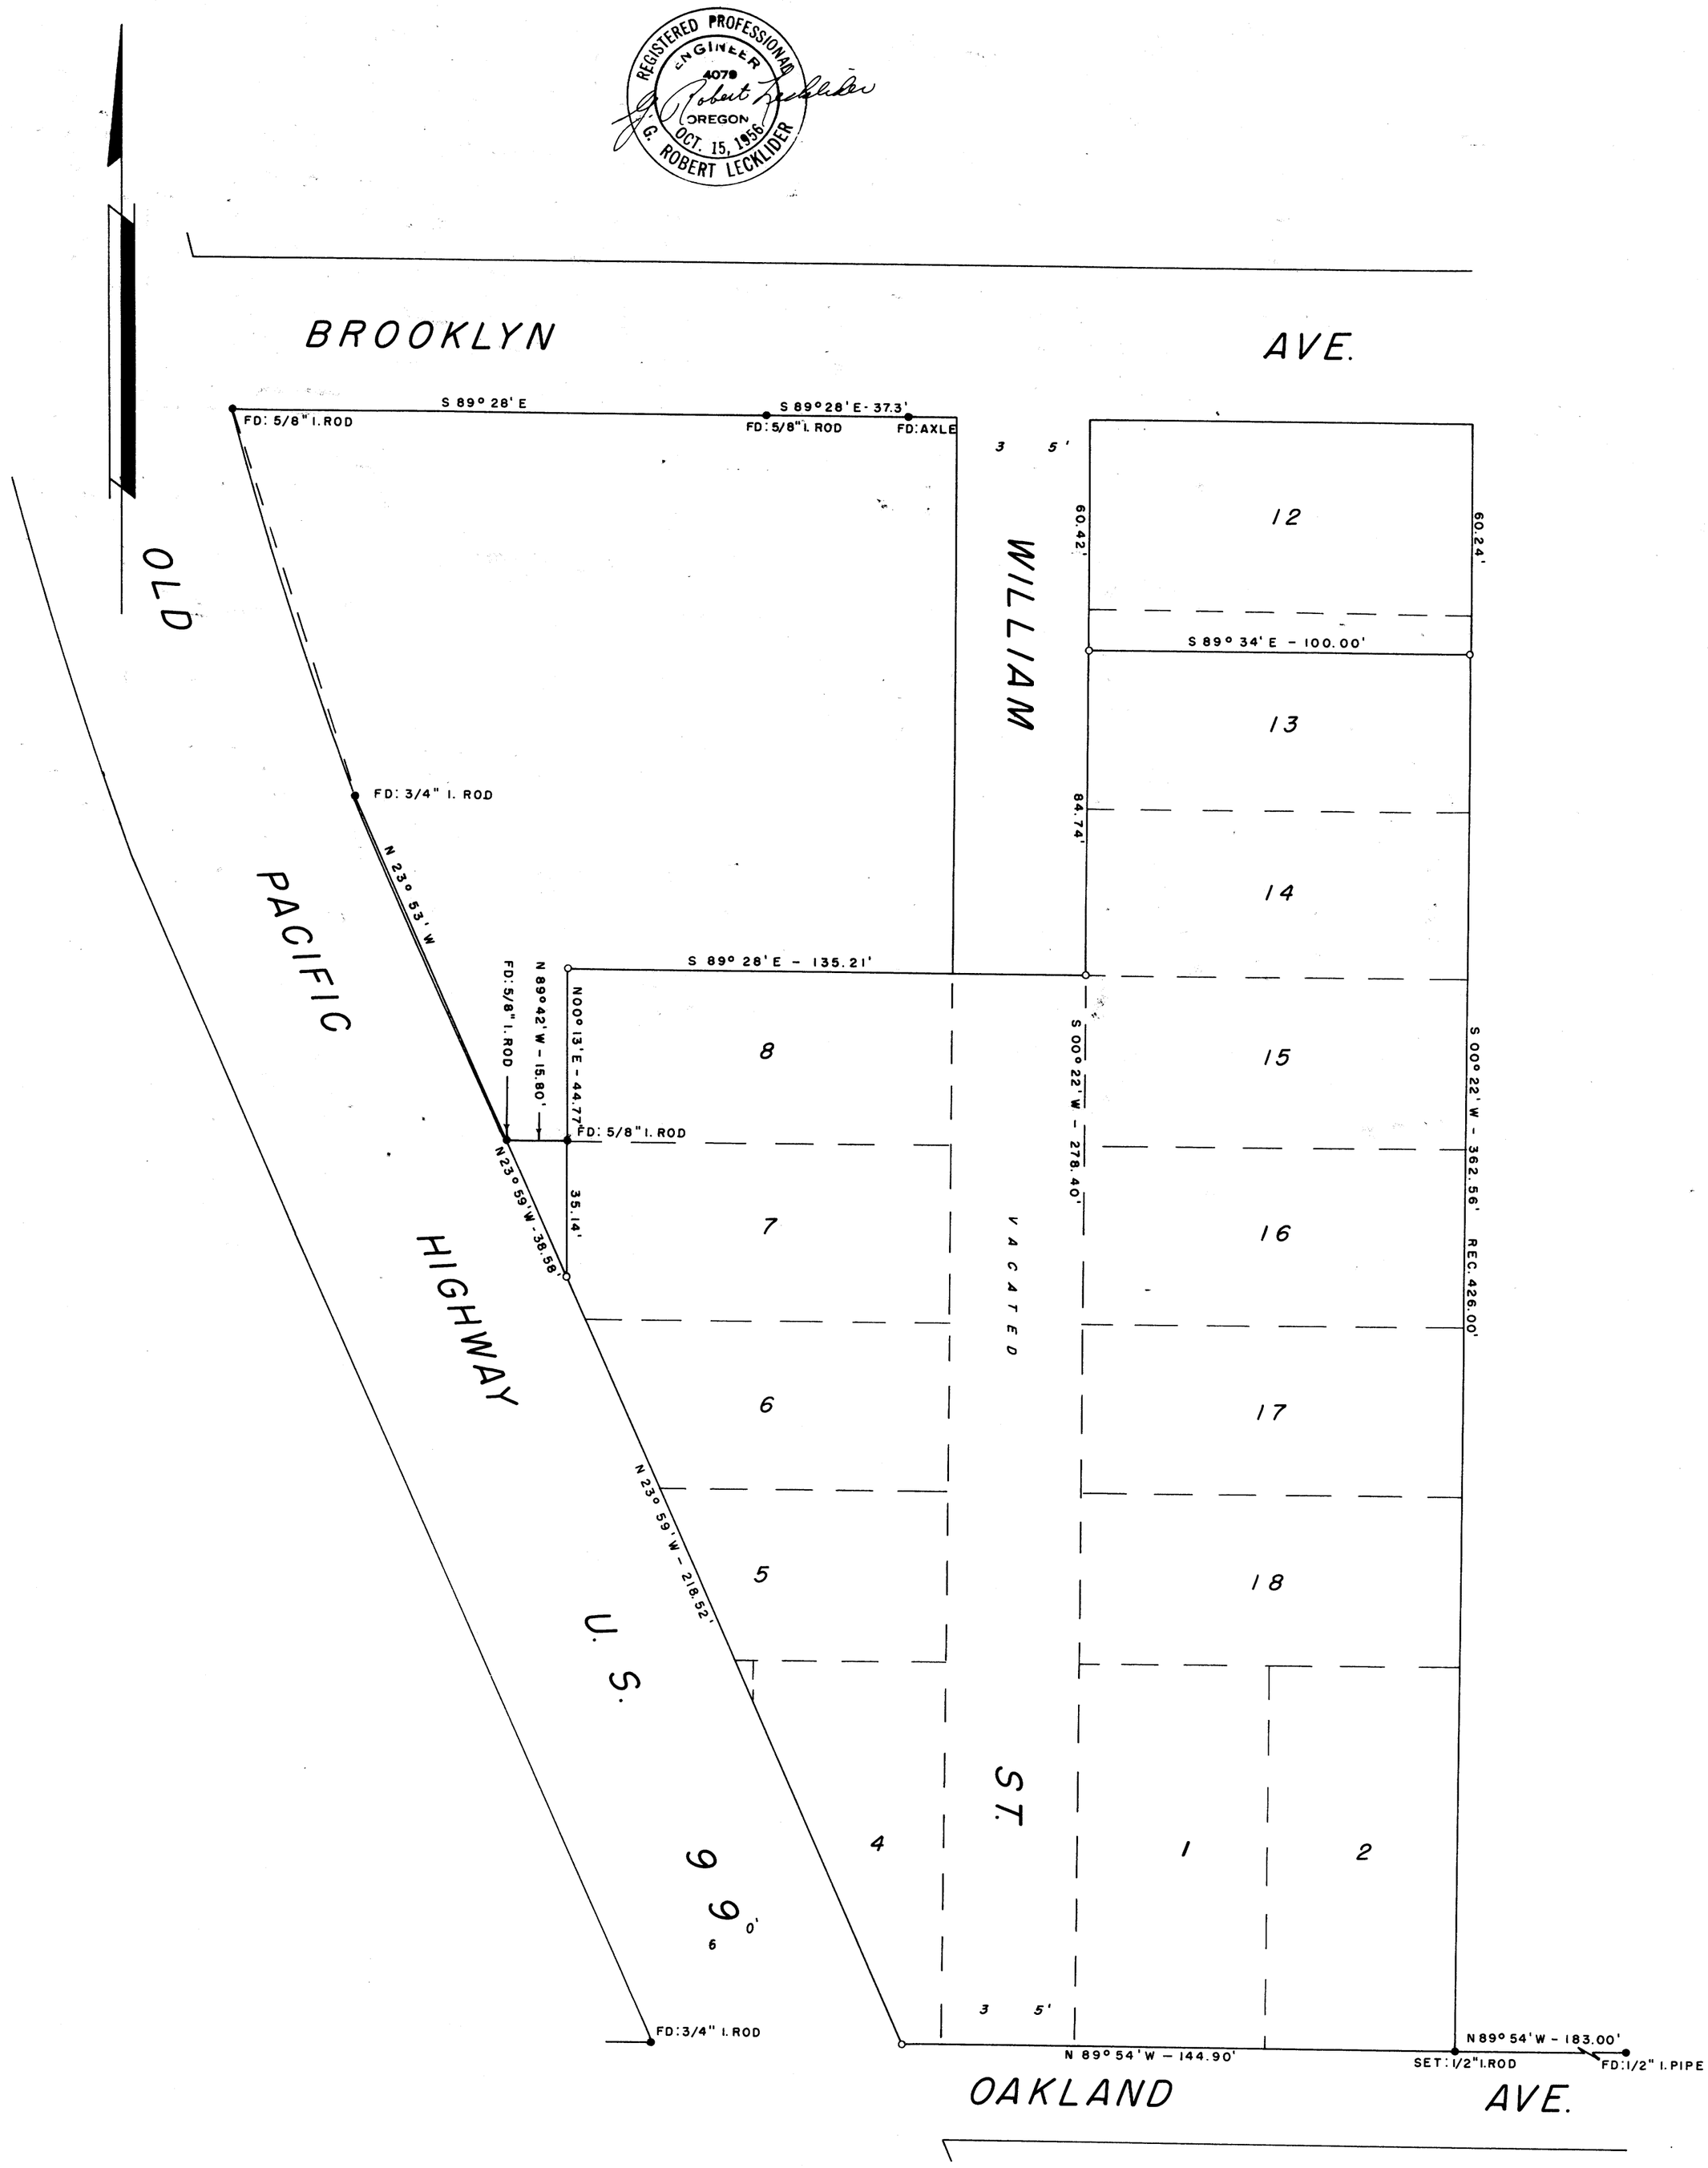

FILED
RECEIVED L.L.
JUL 1 0 1961
COUNTY SURVEYOR
DOUGLAS COUNTY, ORE.

MAP FILE M 20 - 79