C.S. File 40 / 21

Map File M2 Lr 13

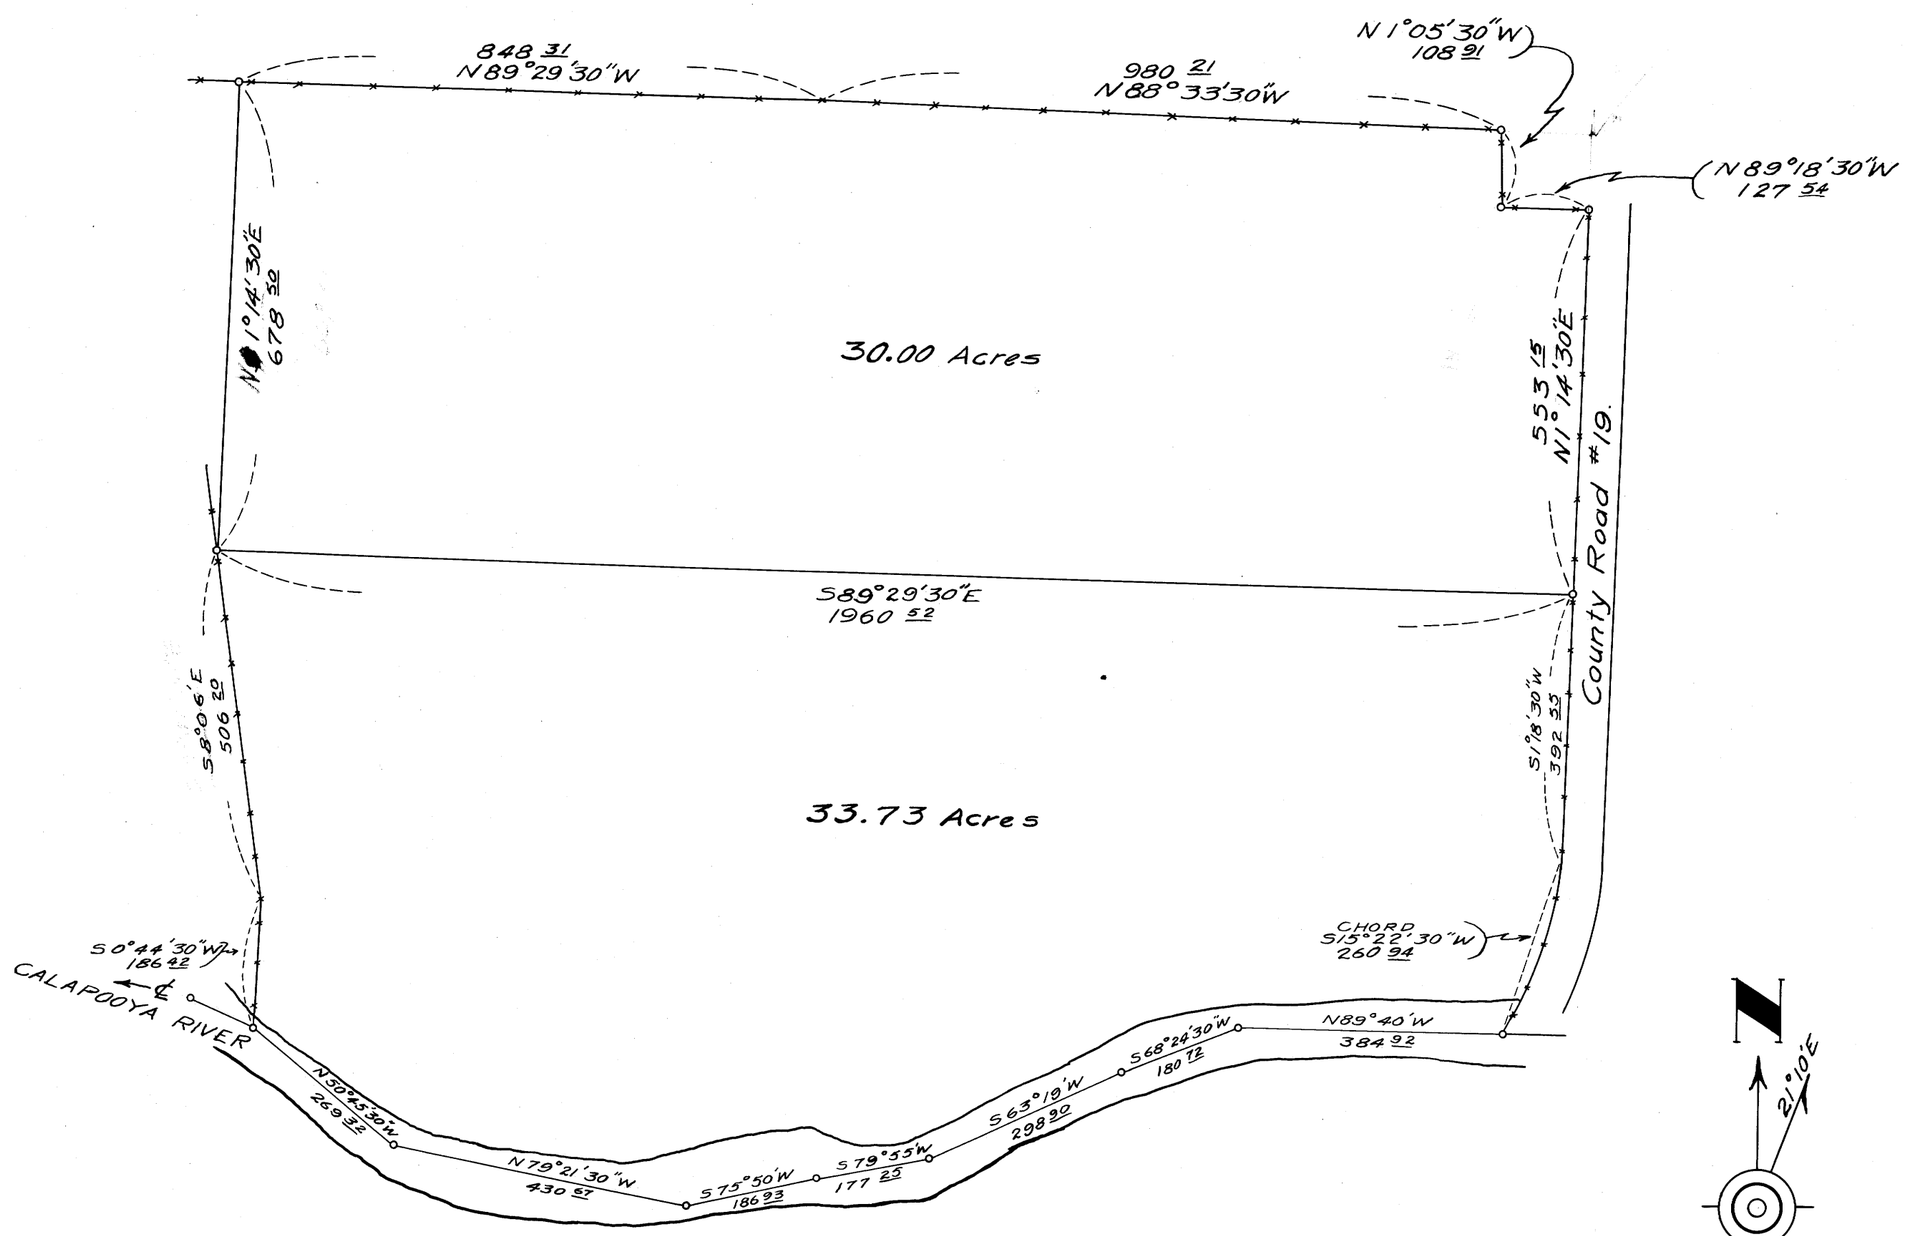

A PORTION OF

CLINTON SUTHERLIN D.L.C. No. 49.

TWP. 25 S, RANGE 4W., W.M.

AS SURVEYED FOR W.A. THOMAS

AUGUST, 1946.

—:—

Scale — 1-inch = 200 ft.

COUNTY SURVEYORS FILE DATA
DO NOT REMOVE FROM OFFICE

REGISTERED PROFESSIONAL ENGINEER 522 OREGON DEC. 8, 1919 Edwin S. Woodford

Edwin S. Woodford

FILED
RECEIVED
JUN 9 1951
COUNTY SURVEYOR
DOUGLAS COUNTY, ORE.

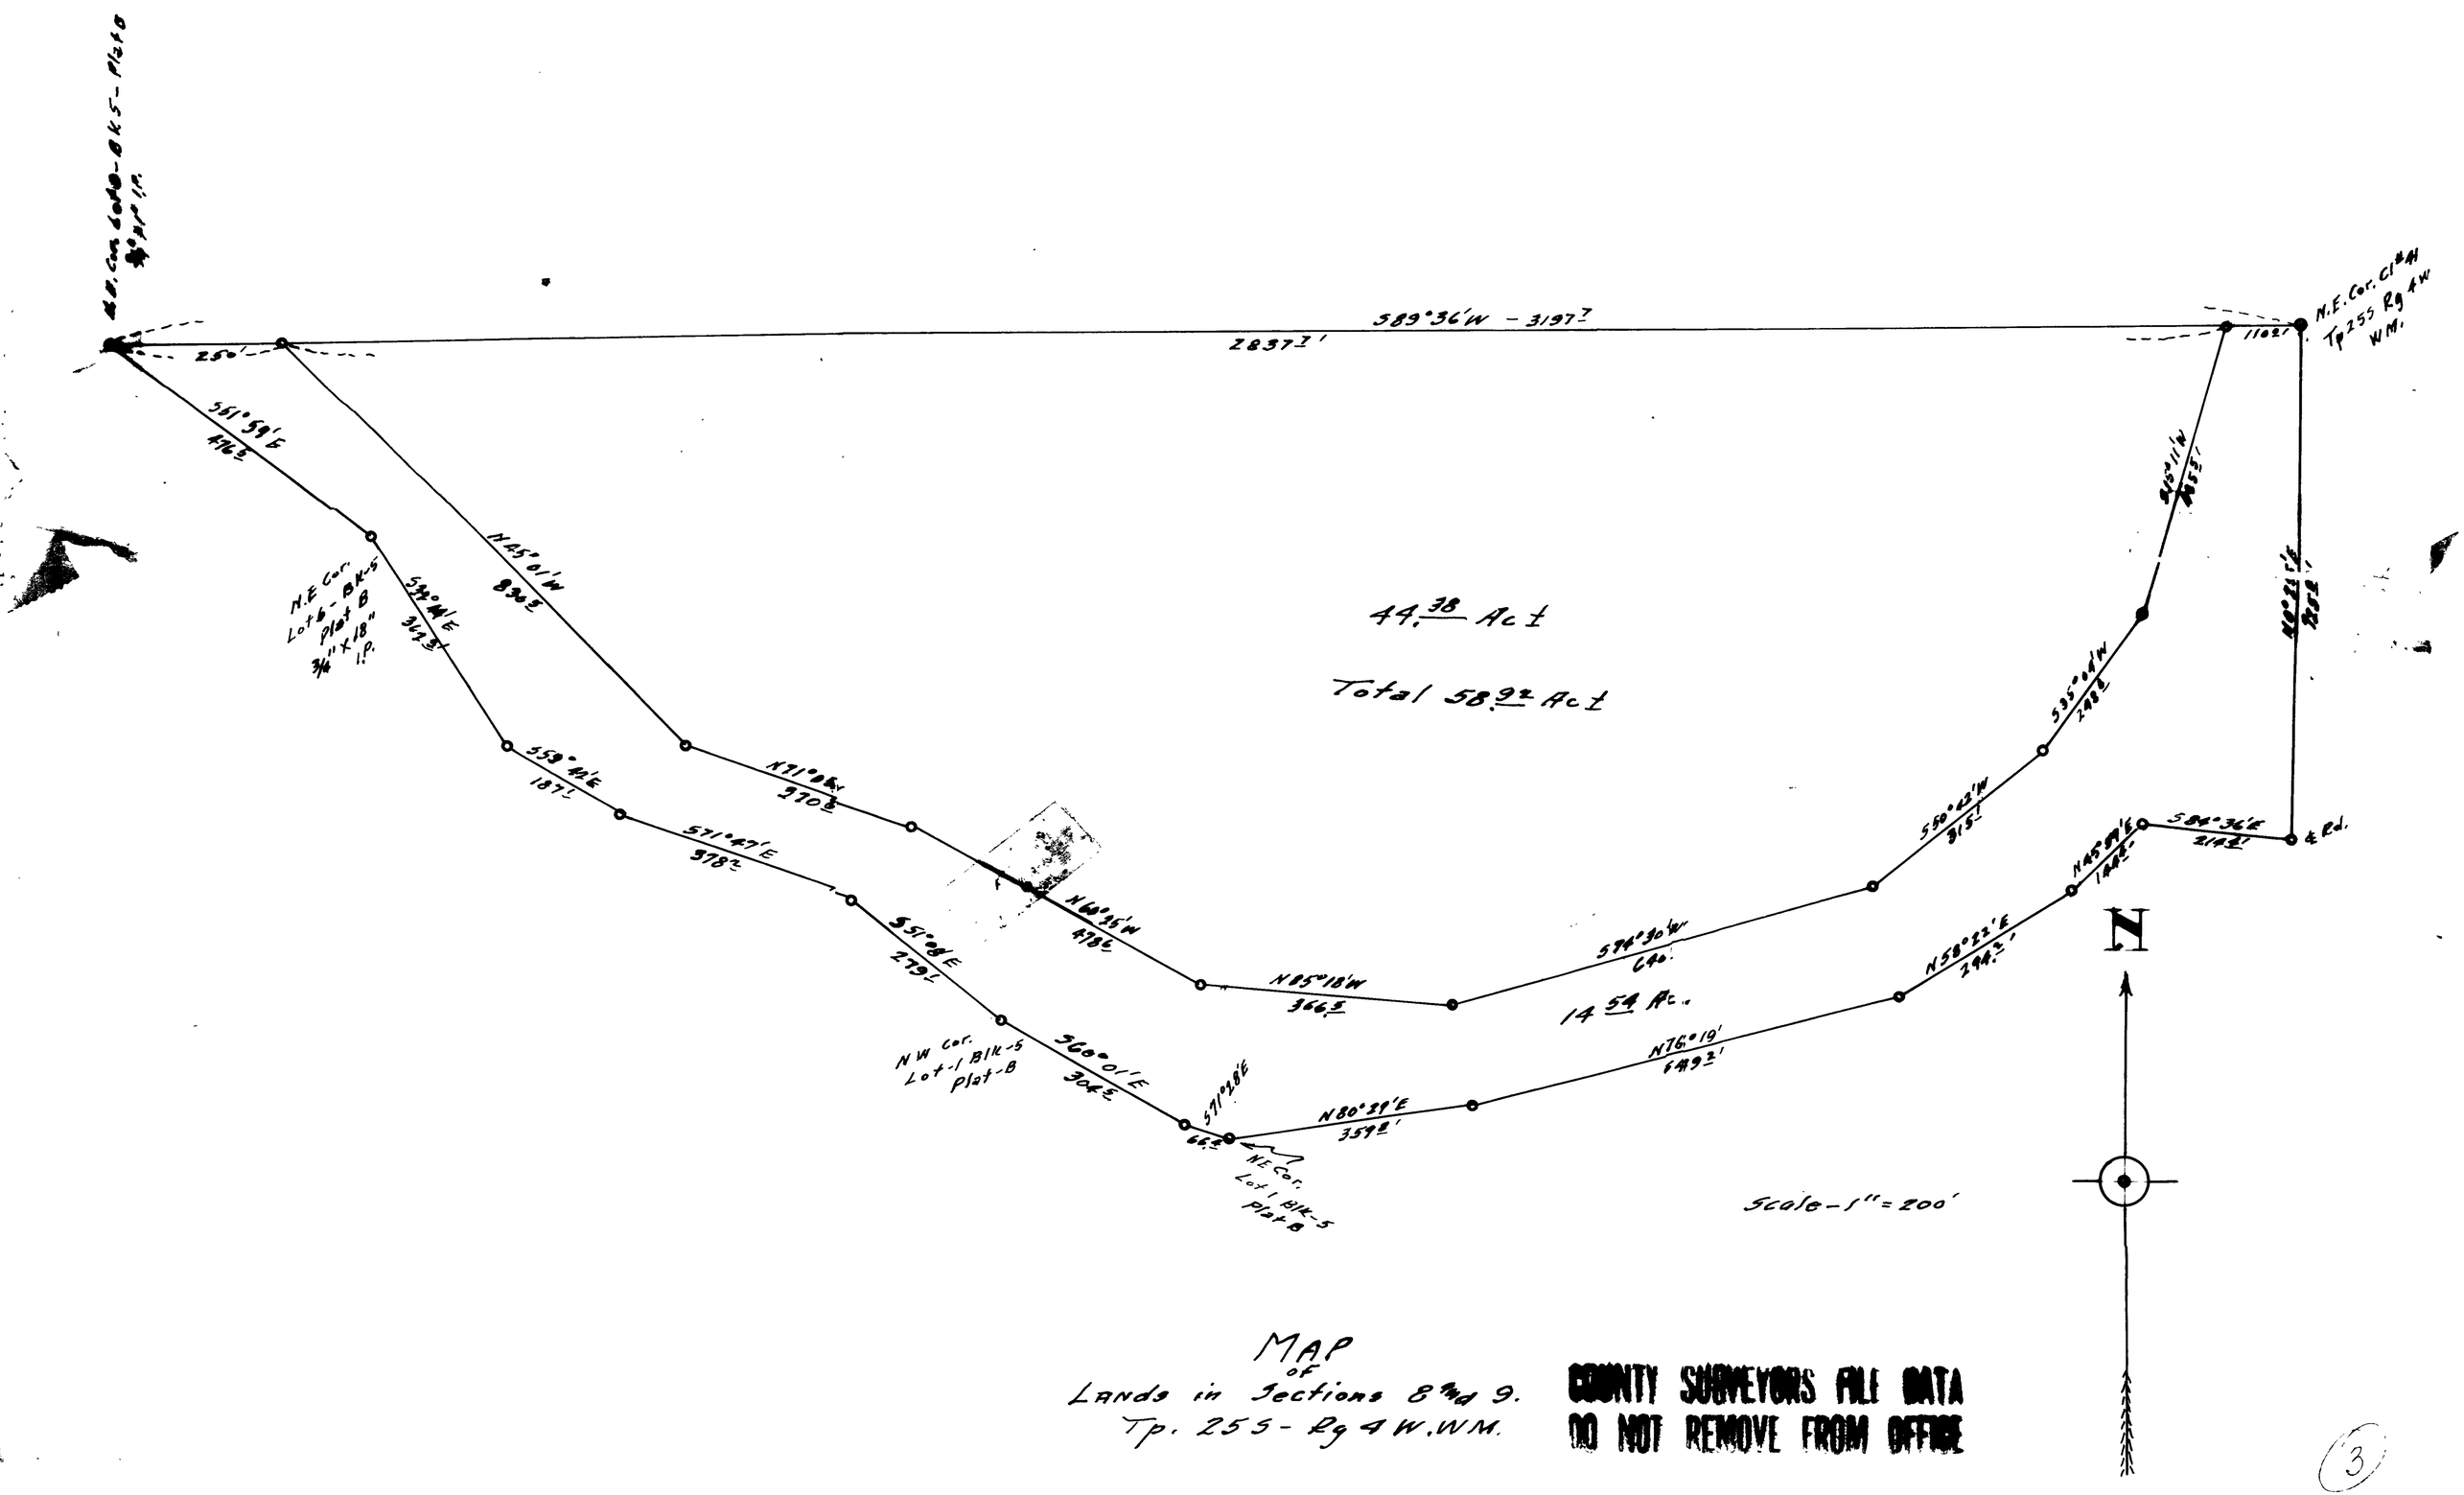

MAP
of
Lands in Sections 8 and 9.
Tp. 255 - Rg 4 W.W.M.

COUNTY SURVEYORS FILE DATA
DO NOT REMOVE FROM OFFICE

CS FILE FOLDER

CONTAINS

MORE

INFORMATION