COUNTY SURVEYORS FILE DATA
DO NOT REMOVE FROM OFFICE

FILE M21 - 21

SURVEY OF TRACT 8, REED PROPERTY
RAILROAD ADDITION
Amended Plat
REEDSPORT, OREGON
for
Byron Serfling

Scale: 1" = 30'
Corners found: ○
Corners set: ○

June 15, 1961

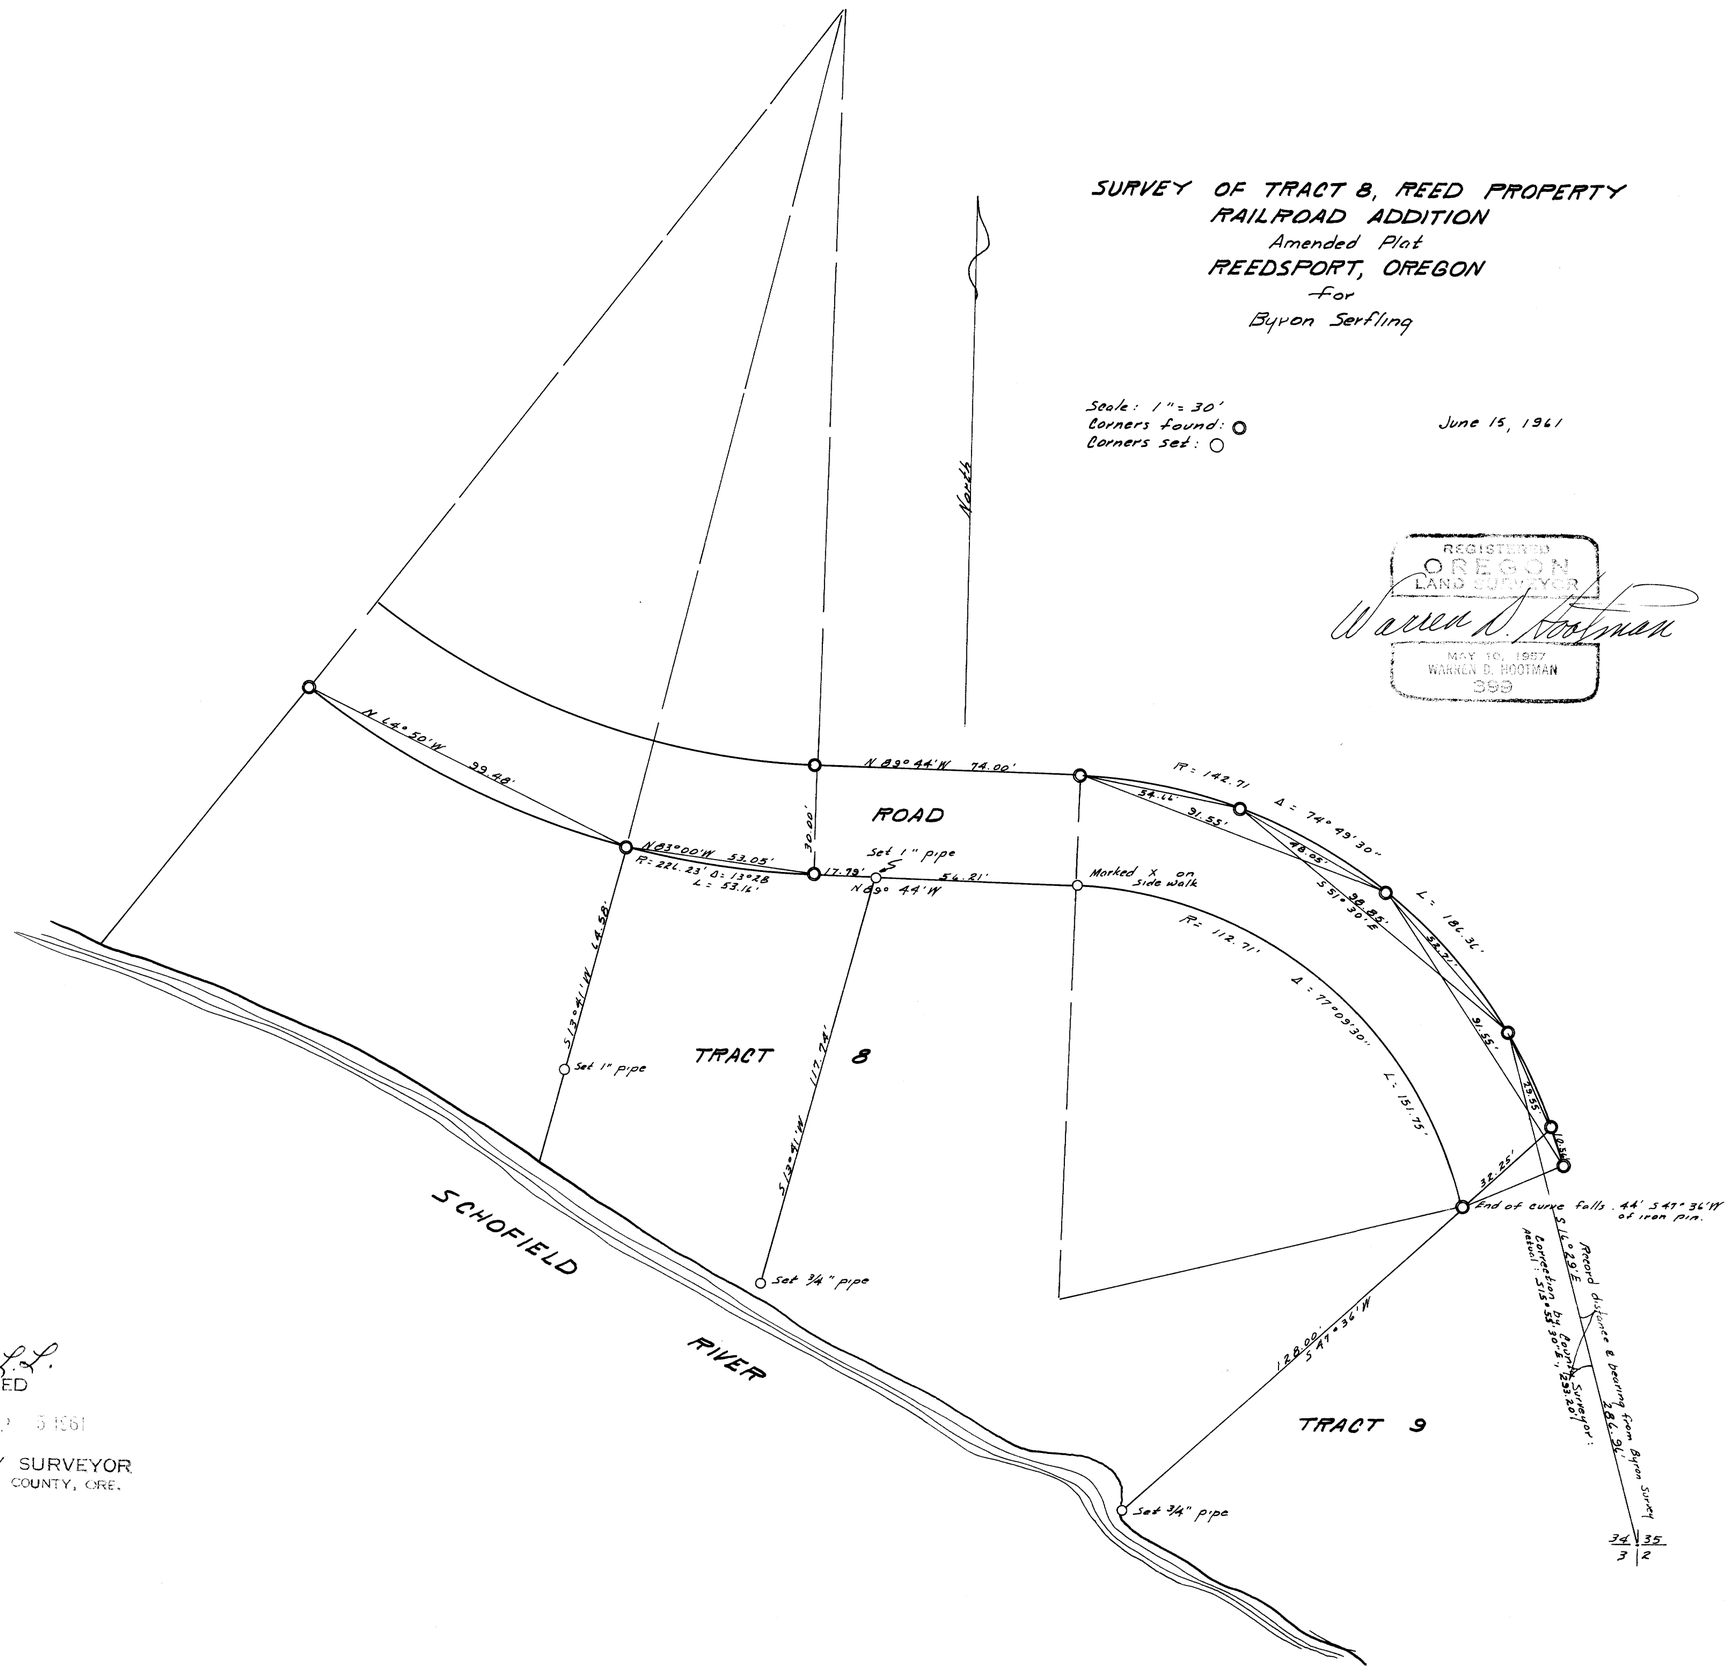

FILED
RECEIVED
SEP 5 1961
COUNTY SURVEYOR
DOUGLAS COUNTY, ORE.

REGISTERED
OREGON
LAND SURVEYOR
Warren D. Hootman
MAY 10, 1957
WARREN D. HOOTMAN
399

M 21-21