COUNTY SURVEYORS FILE DATA
DO NOT REMOVE FROM OFFICE

O.S. File 39/75
Map File M 21-39

COUNTY SURVEYORS OFFICE
DOUGLAS COUNTY OREGON

SURVEY OF PART OF LOT 18, PLAT "F"
ROSEBURG HOME ORCHARD TRACTS
SECTION 27, T28 S., R6 W. W. M.

BEN B IRVING COUNTY SURVEYOR
SURVEYED APRIL 9-10, 1947 BY
N E RICHARDSON DEPUTY

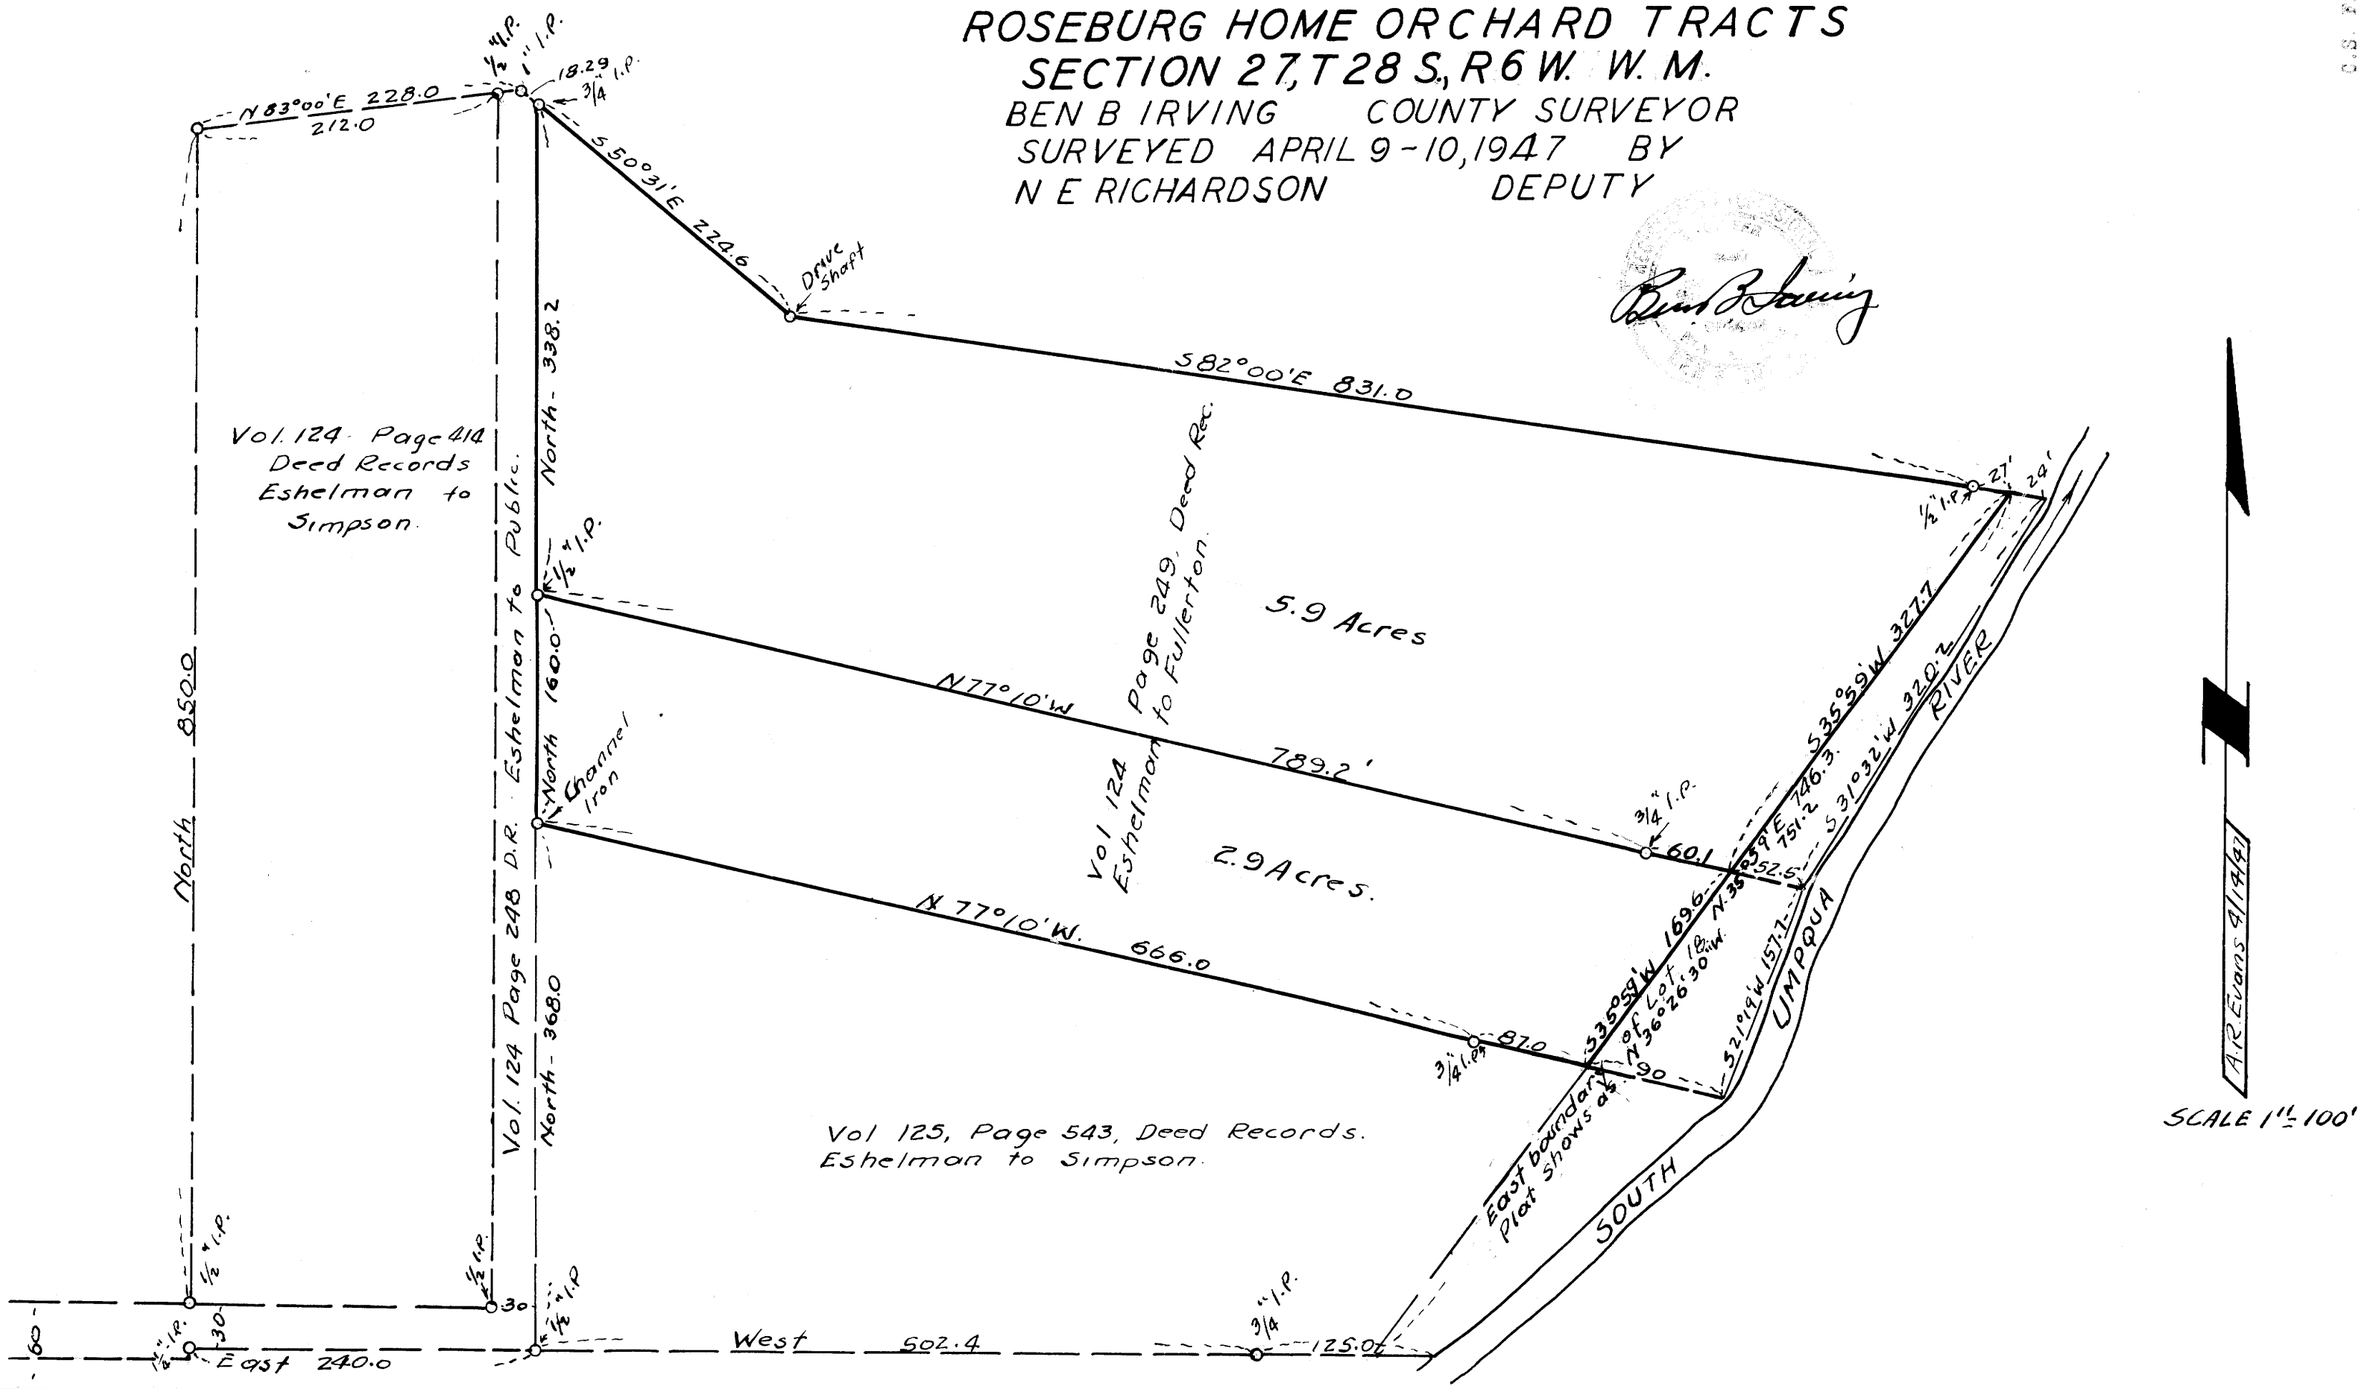

FILE 75 DRAWER 39