F.B. H-131
M22-1

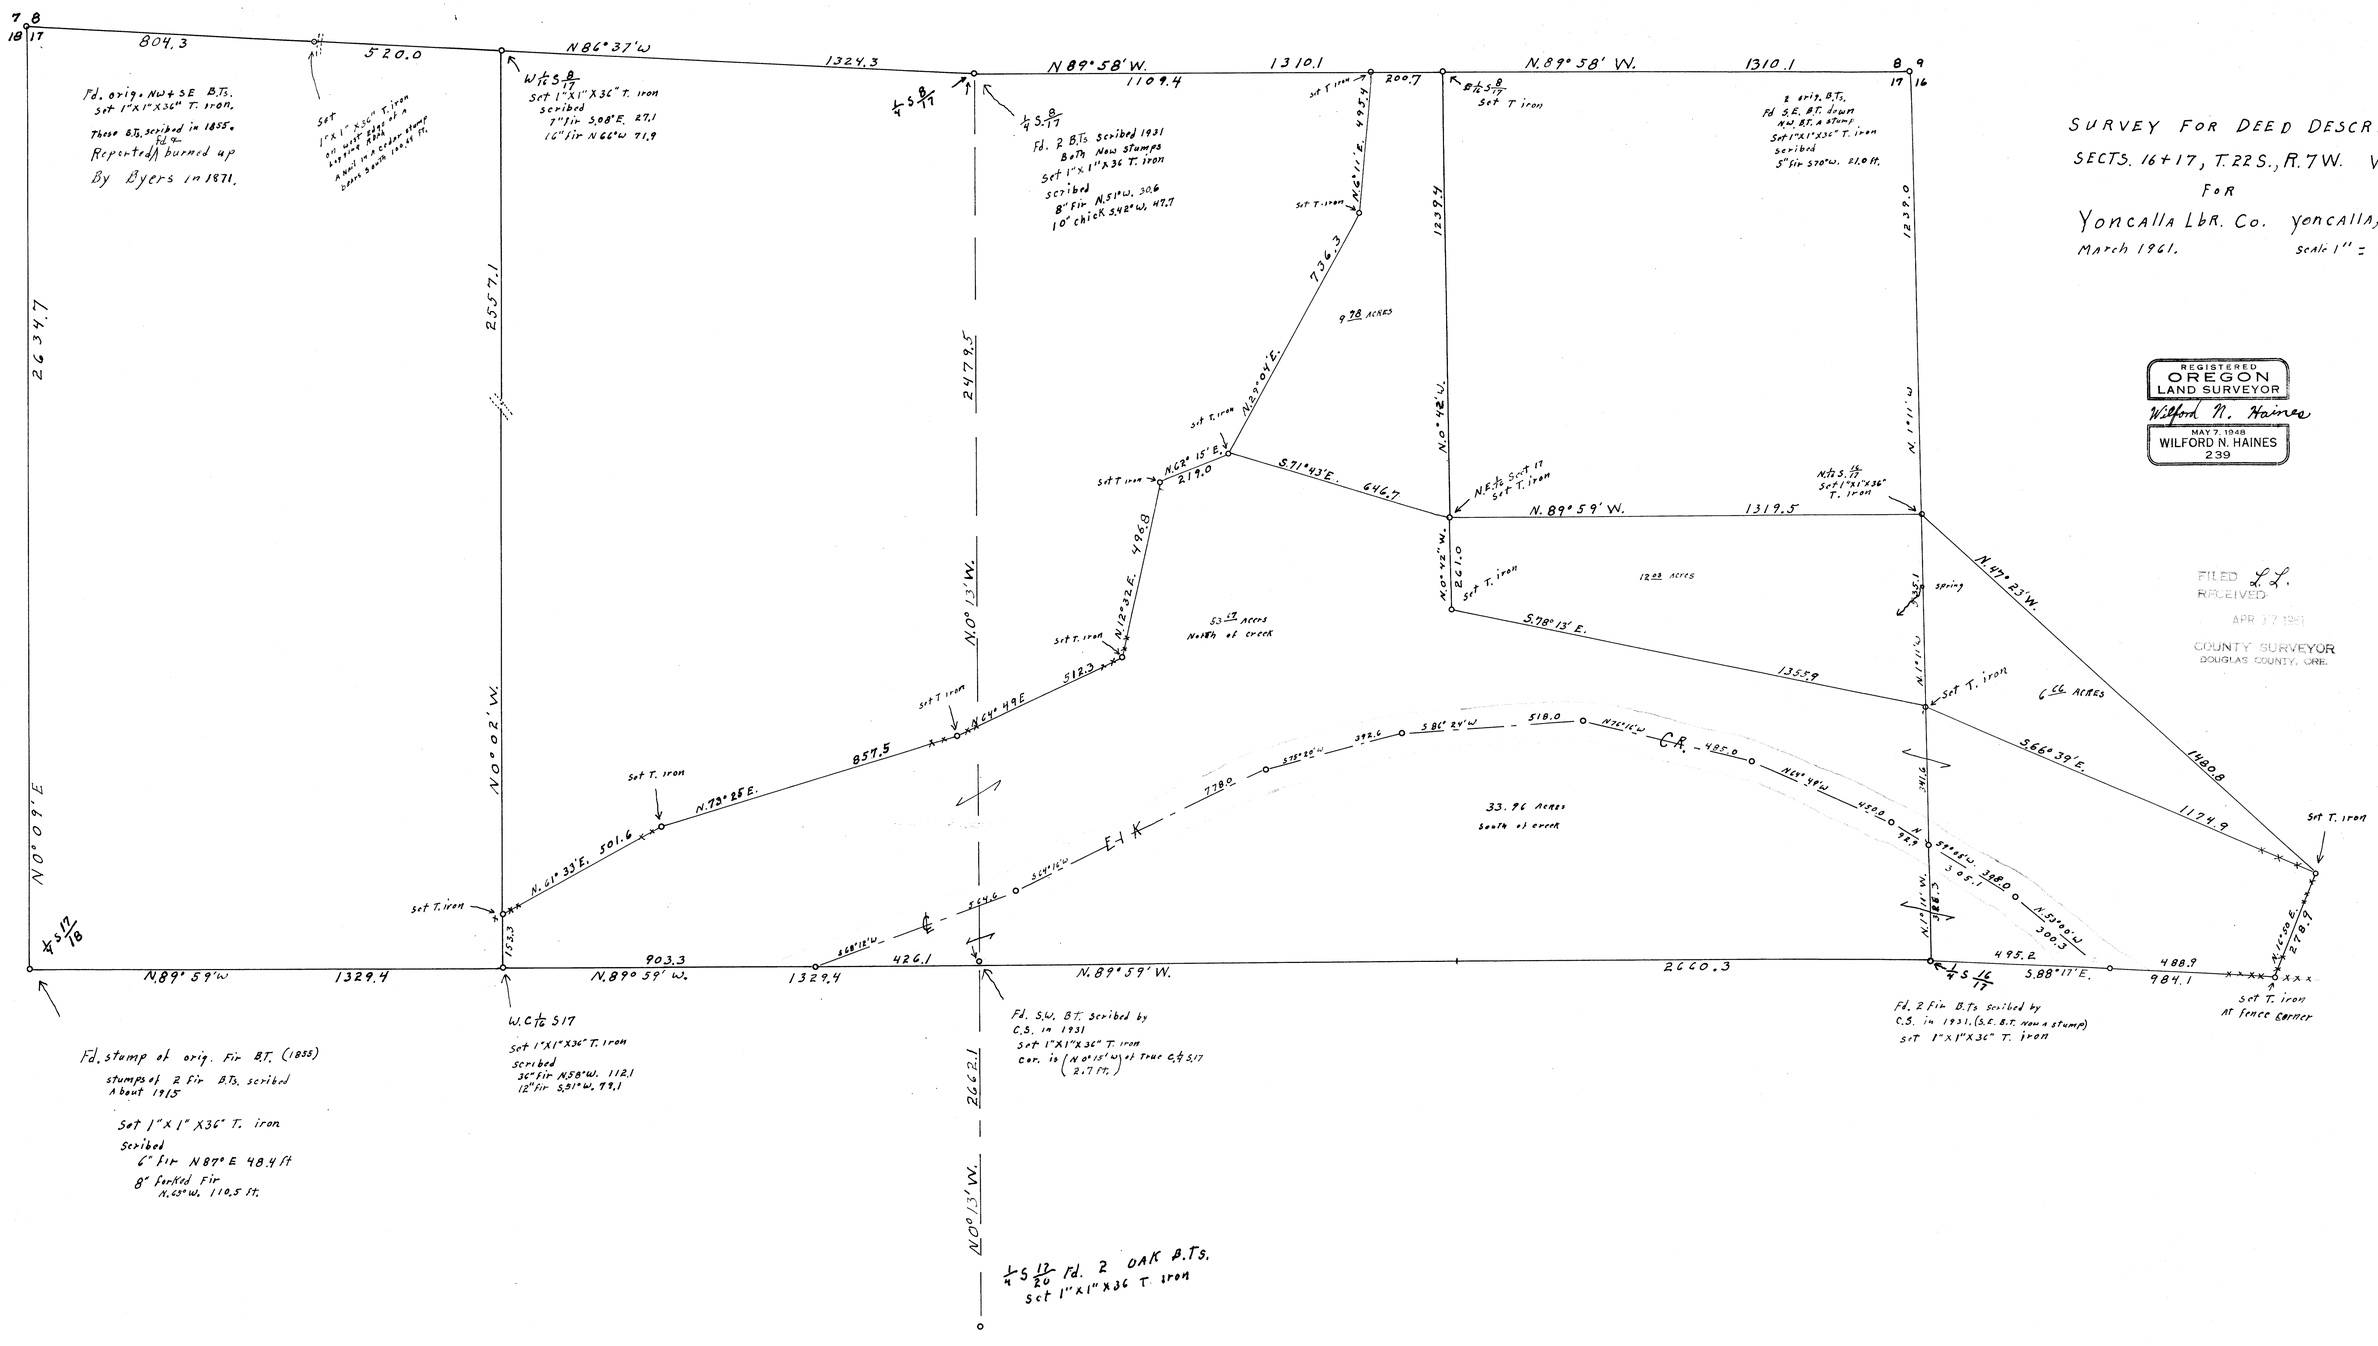

SURVEY FOR DEED DESCRIPTION
SECTS. 16 + 17, T. 22 S., R. 7 W. W. M.
FOR
Yoncalla Lbr. Co. Yoncalla, ORE.
March 1961. Scale 1" = 200'

REGISTERED
OREGON
LAND SURVEYOR
Wilford N. Haines
MAY 7, 1948
WILFORD N. HAINES
239

FILED L.L.
RECEIVED
APR 17 1961
COUNTY SURVEYOR
DOUGLAS COUNTY, ORE.

COUNTY SURVEYORS FILE
DO NOT REMOVE FROM OFFICE

F.B. H-131
MAP FILE M22-1