M 22-10

COUNTY SURVEYORS FILE DATA
DO NOT REMOVE FROM OFFICE

FILED
RECEIVED
JUN 5 1961
COUNTY SURVEYOR
DOUGLAS COUNTY, ORE.

MAP FILE M 22-10

MAP
OF
LYLE MARSTERS PROPERTY
IN
SECTION-11-Tp. 31S-Rg. 5W WM.

SCALE-1" = 300.'

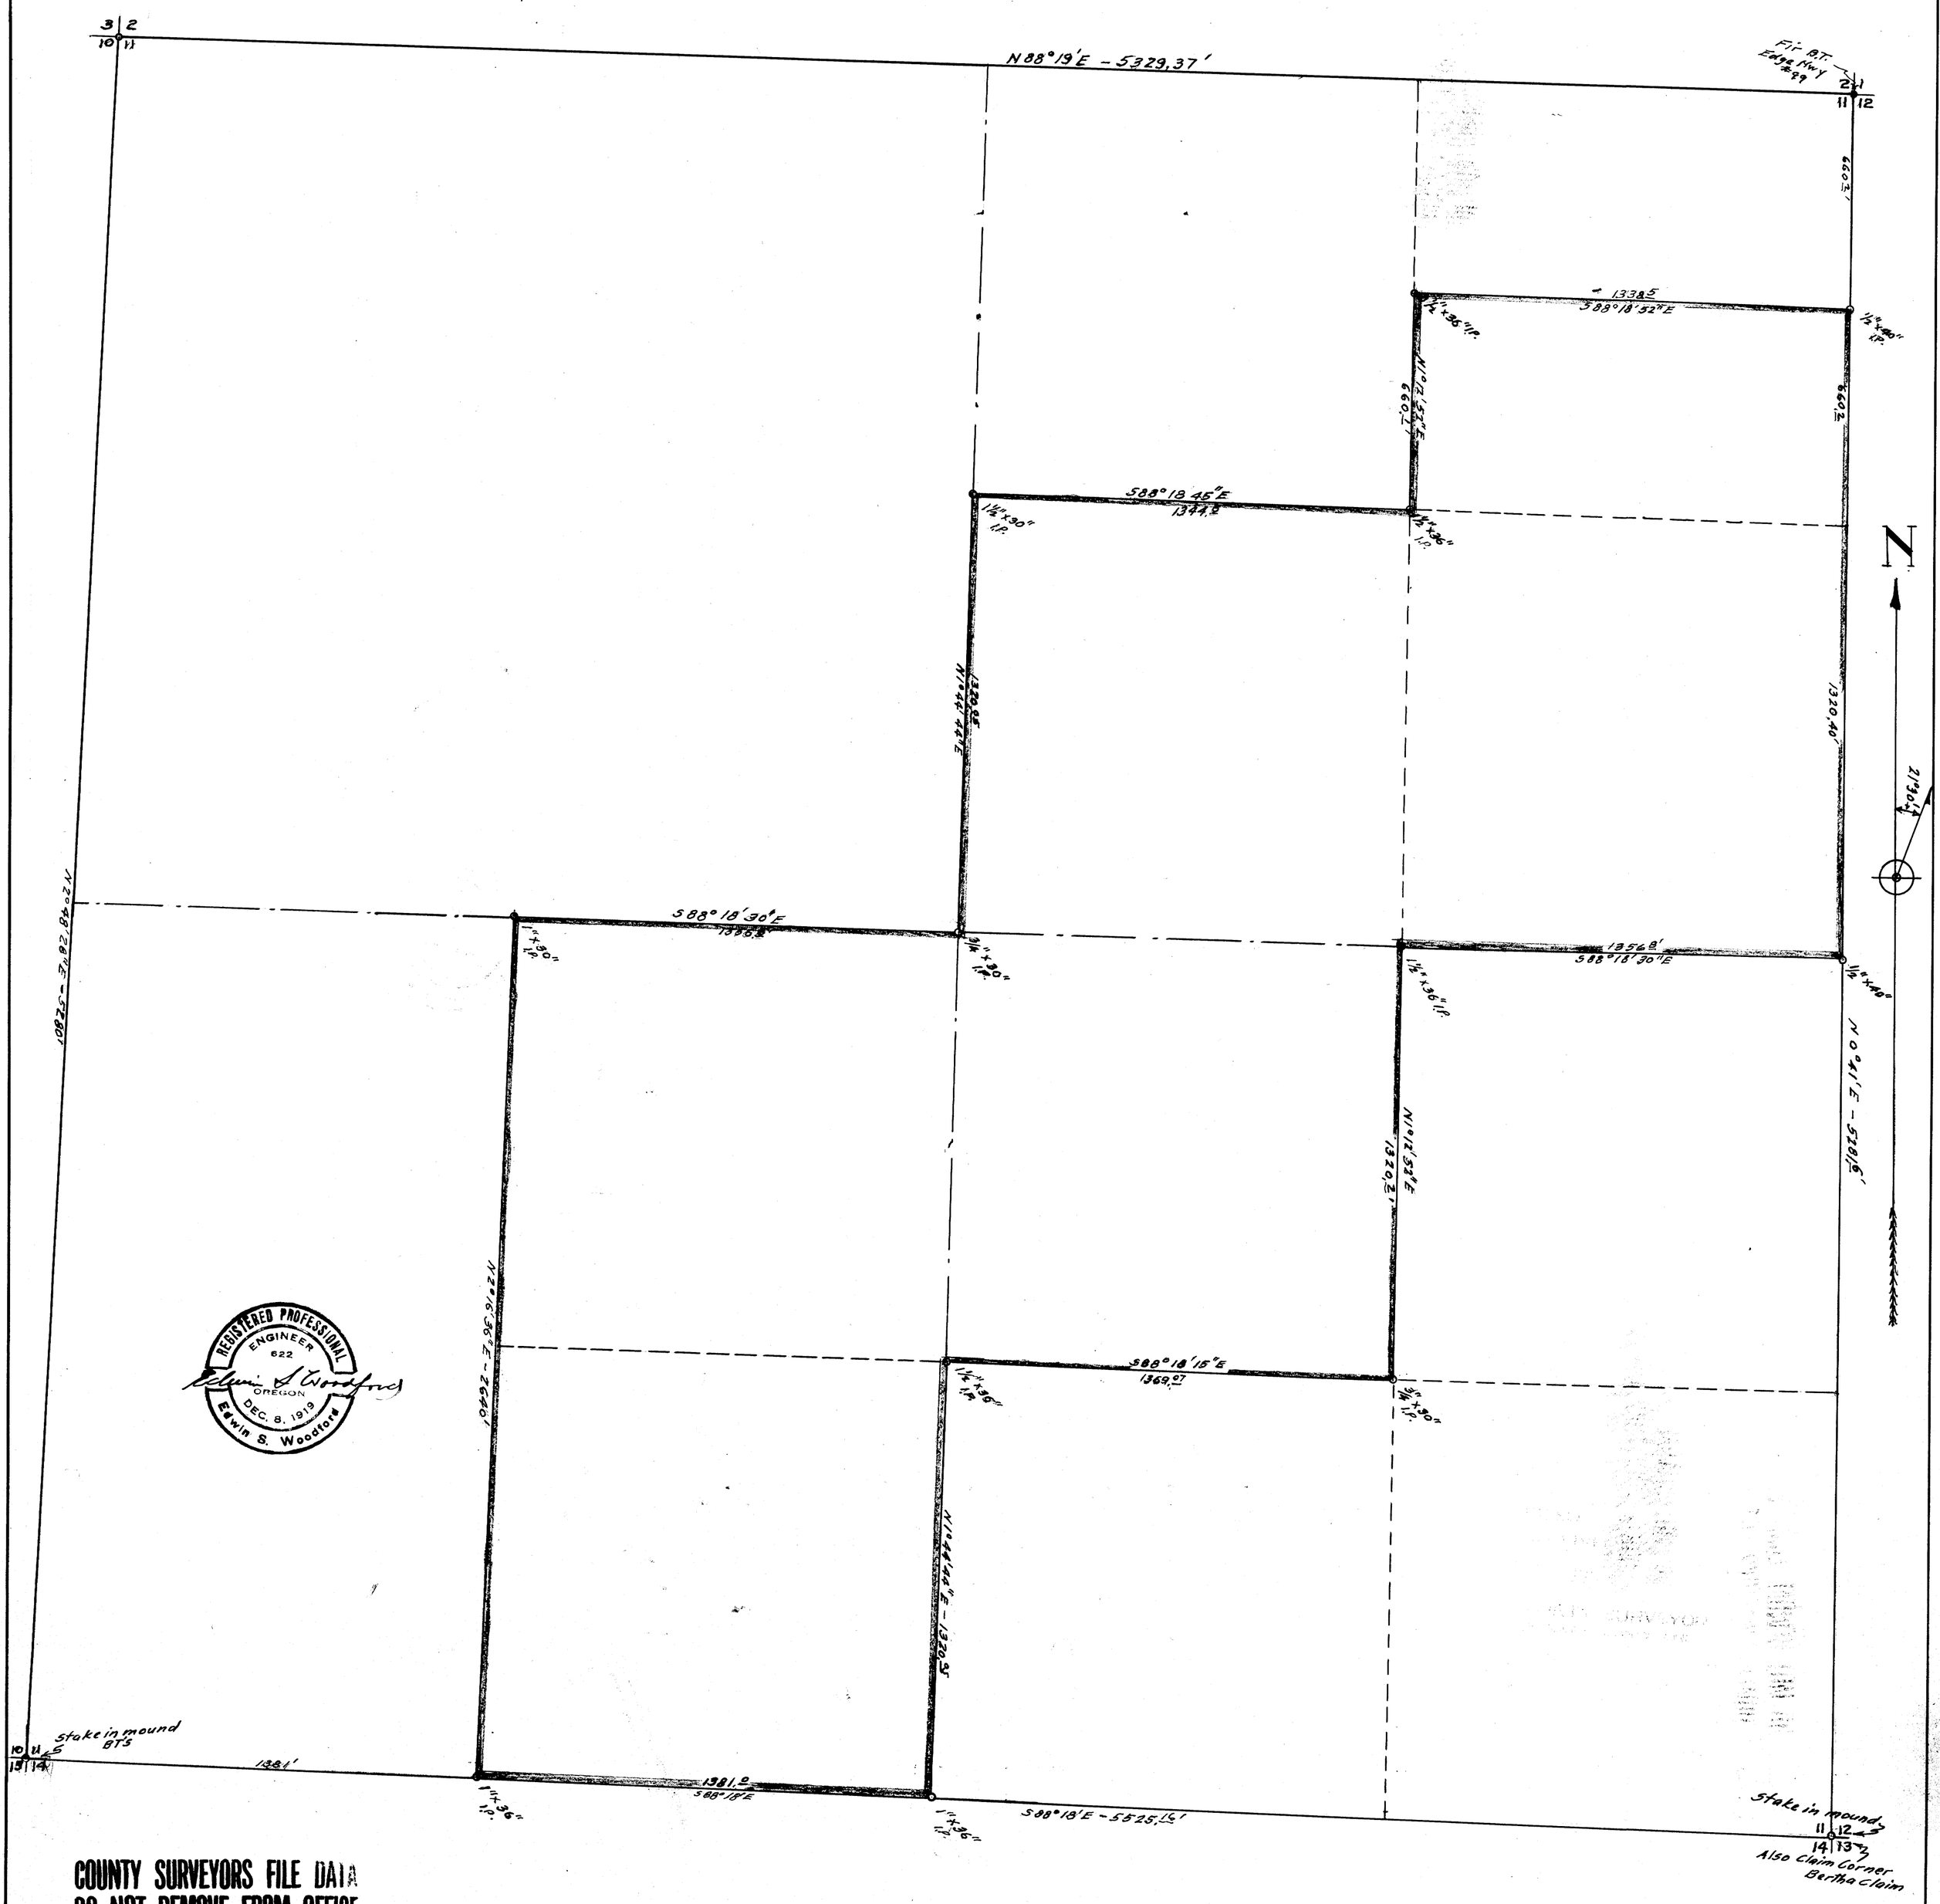

COUNTY SURVEYORS FILE DATA
DO NOT REMOVE FROM OFFICE

C.S. 40/204
MAP FILE M22-10