M 22-37
COUNTY SURVEYORS FILE DATA
DO NOT REMOVE FROM OFFICE

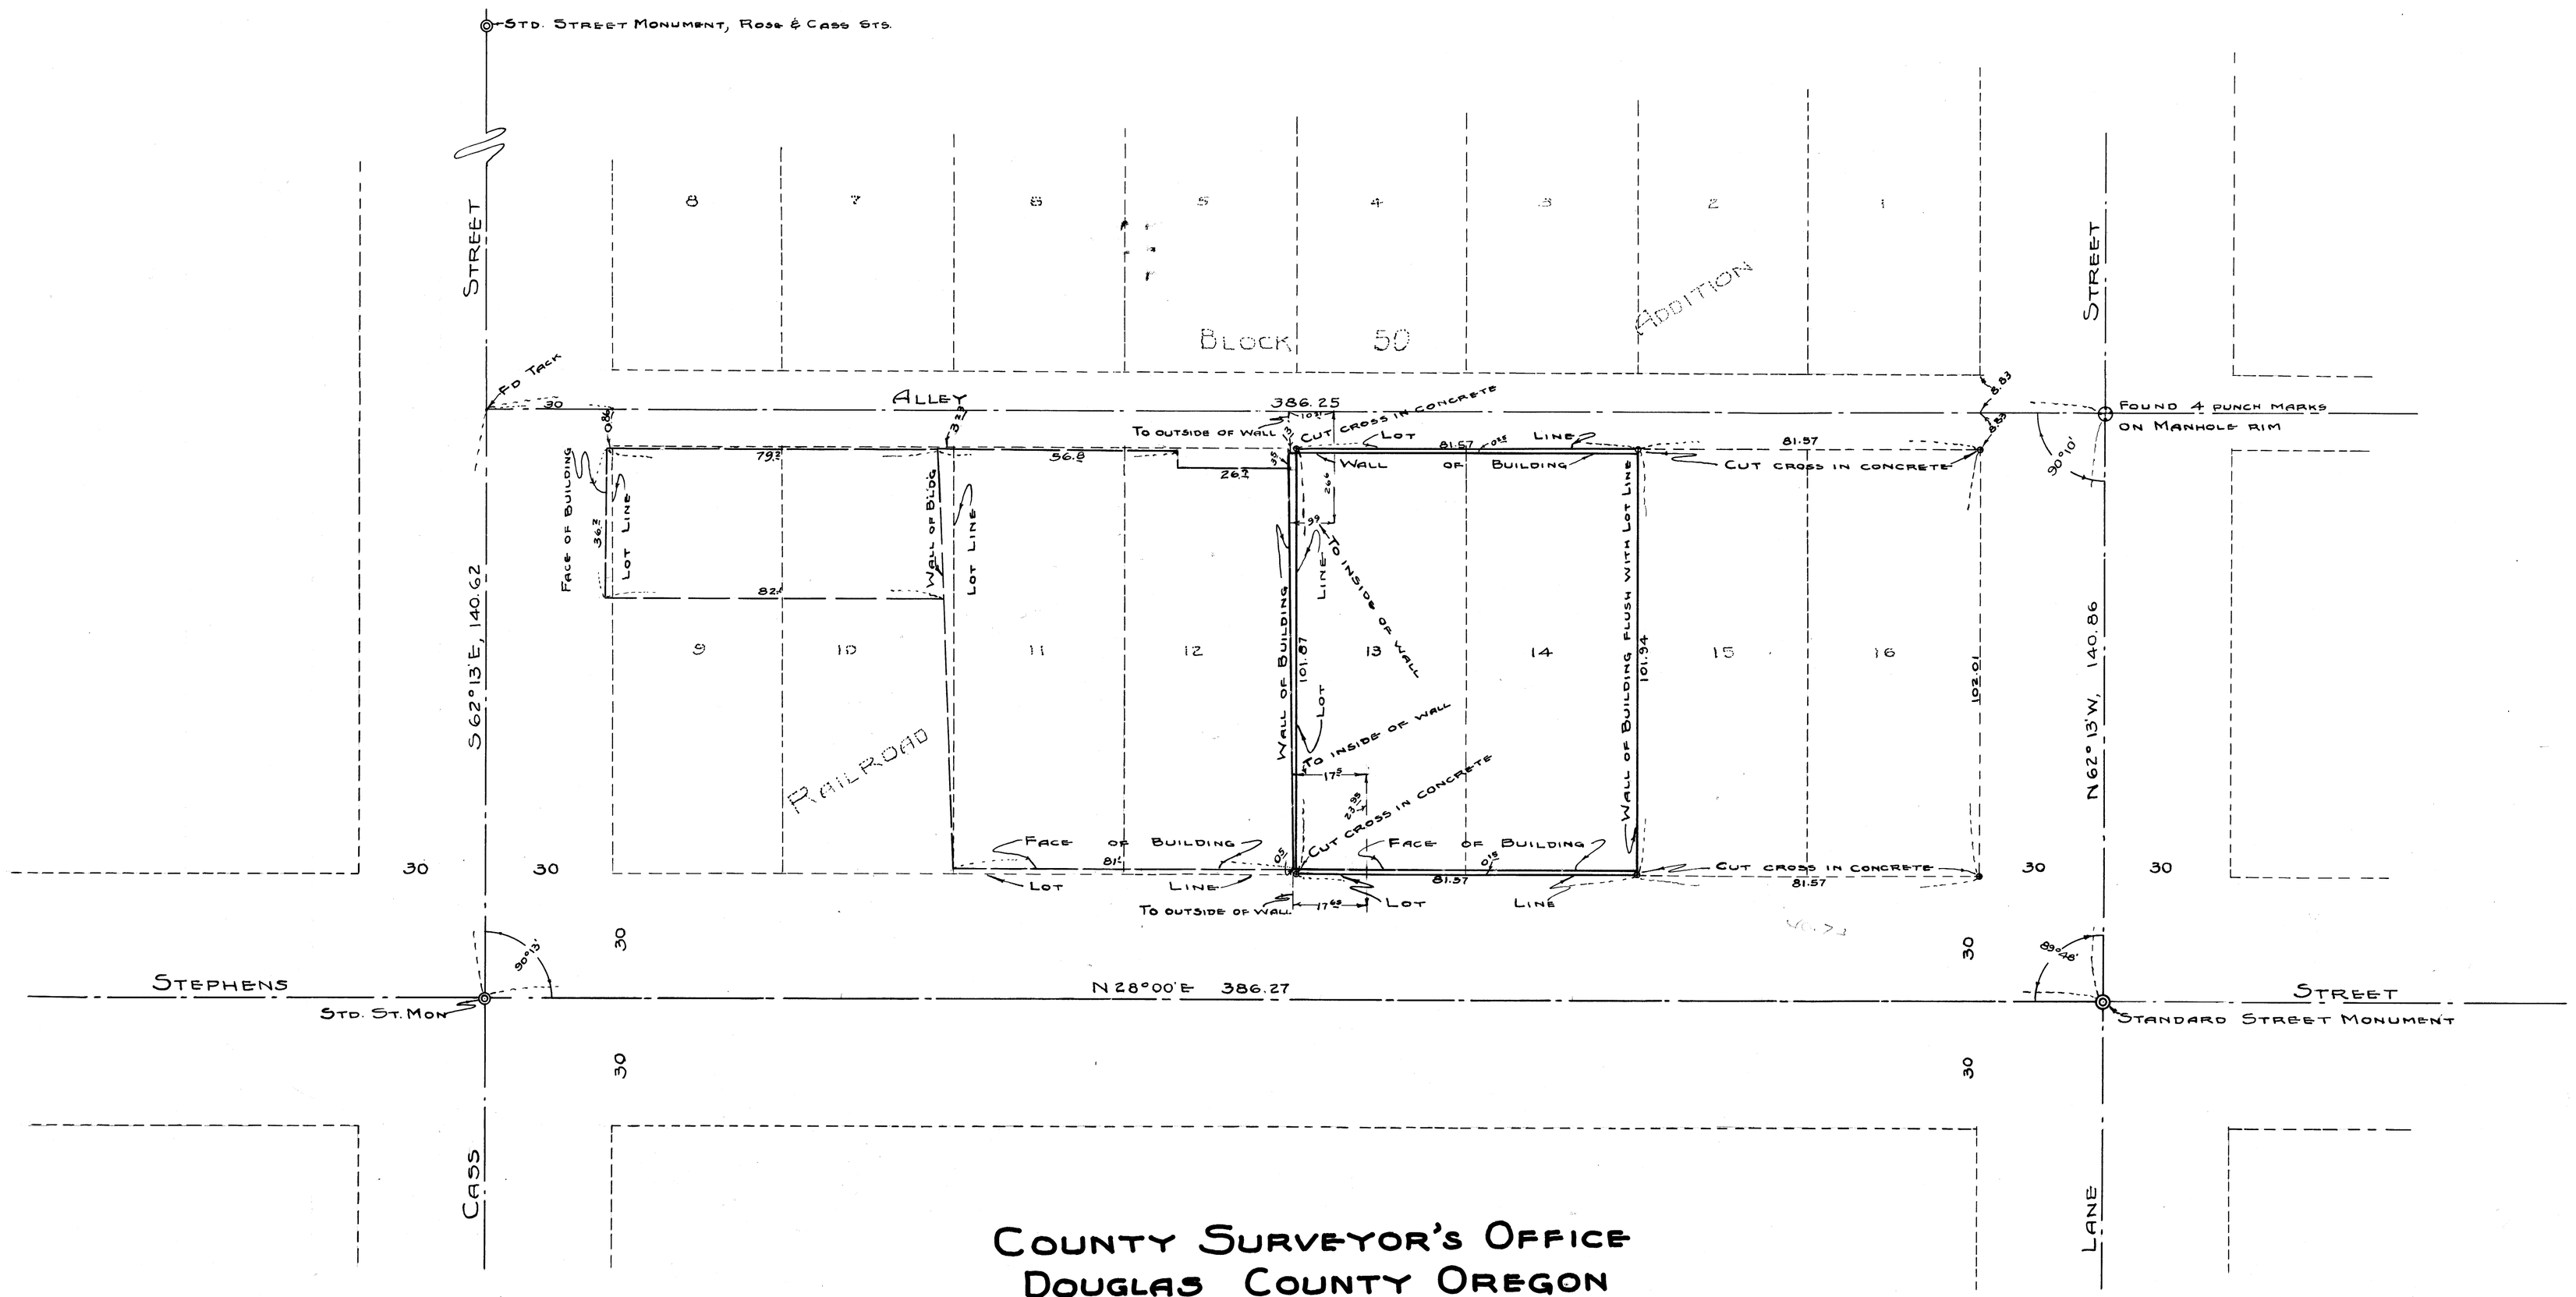


# COUNTY SURVEYOR'S OFFICE
# DOUGLAS COUNTY OREGON
# SURVEY SHOWING LOCATION OF BUILDING ON LOTS 13 & 14 BLOCK 50, RAILROAD ADDITION CITY OF ROSEBURG, OREGON

REGISTERED PROFESSIONAL ENGINEER 2741 OREGON NOV. 7, 1967 ARTHUR R. EVANS

BEN B. IRVING COUNTY SURVEYOR
SURVEYED & PLATTED, FEBRUARY, 1950
A.R. EVANS, DEPUTY COUNTY SURVEYOR
SCALE 1" = 20'

COUNTY SURVEYORS FILE DATA
DO NOT REMOVE FROM OFFICE

C.S File 44/16
Map File M 22-37