C.S. FILE 39/194
M 22-45

COUNTY SURVEYORS FILE DATA
DO NOT REMOVE FROM OFFICE

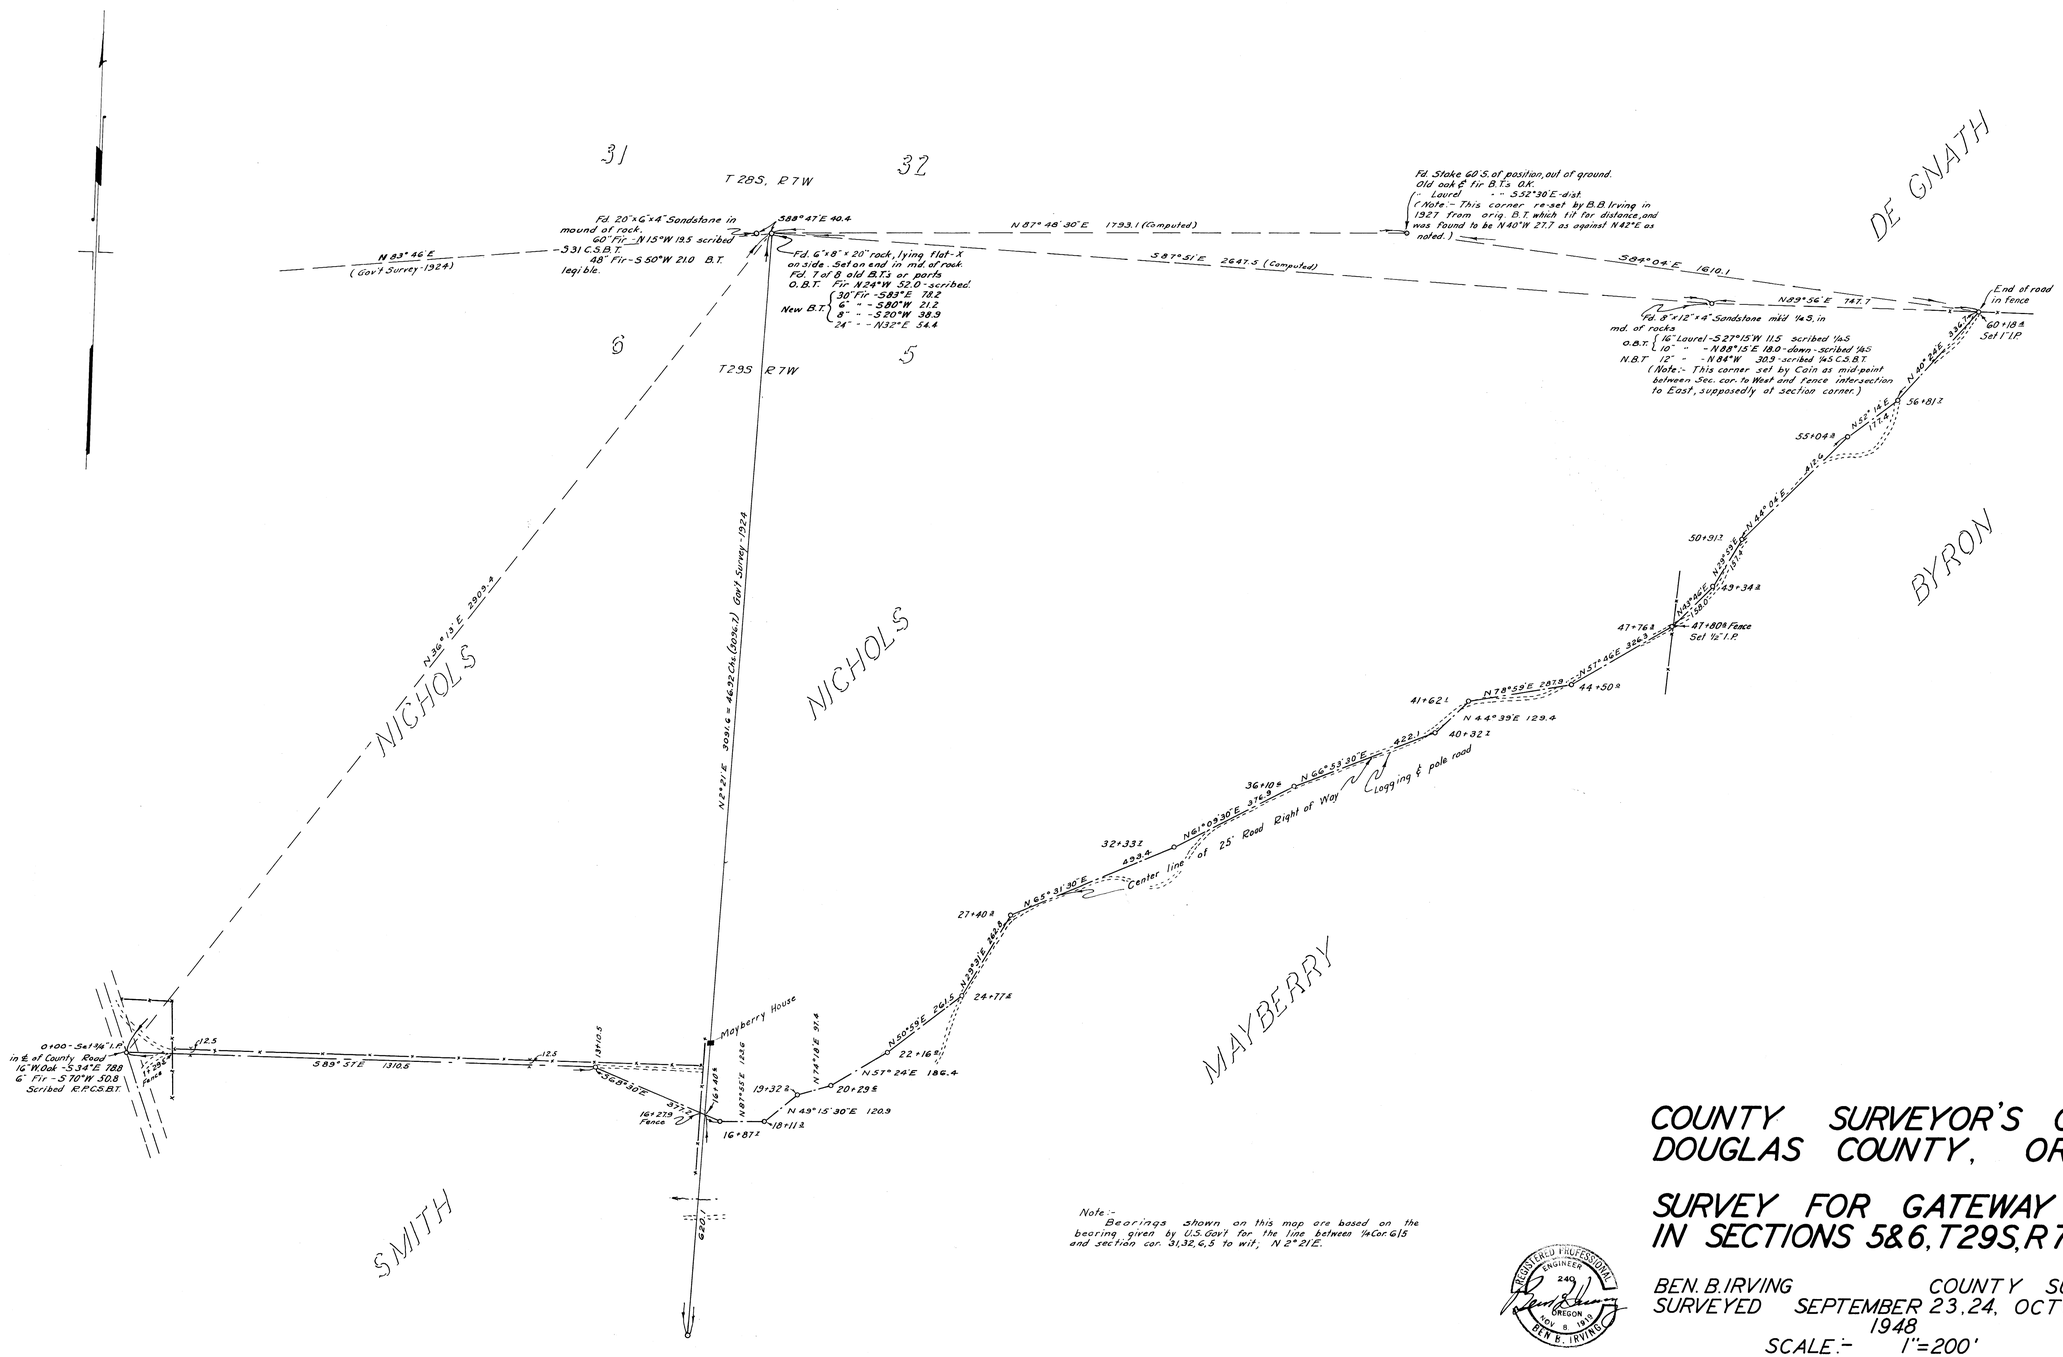

Note:- Bearings shown on this map are based on the bearing given by U.S. Gov't for the line between 1/4 Cor. 6 & 5 and section cor. 31, 32, 4, 5 to wit; N 2° 21' E.

REGISTERED PROFESSIONAL ENGINEER 240 OREGON NOV 8 1948 BEN B. IRVING

COUNTY SURVEYOR'S OFFICE DOUGLAS COUNTY, OREGON.

SURVEY FOR GATEWAY ROAD IN SECTIONS 5 & 6, T 29 S, R 7 W, W.M.

BEN. B. IRVING — COUNTY SURVEYOR

SURVEYED SEPTEMBER 23, 24, OCTOBER 4, 5, 1948

SCALE:- 1" = 200'

COUNTY SURVEYORS FILE DATA
DO NOT REMOVE FROM OFFICE

M 22-45