COUNTY SURVEYORS FILE ONLY
DO NOT REMOVE FROM OFFICE

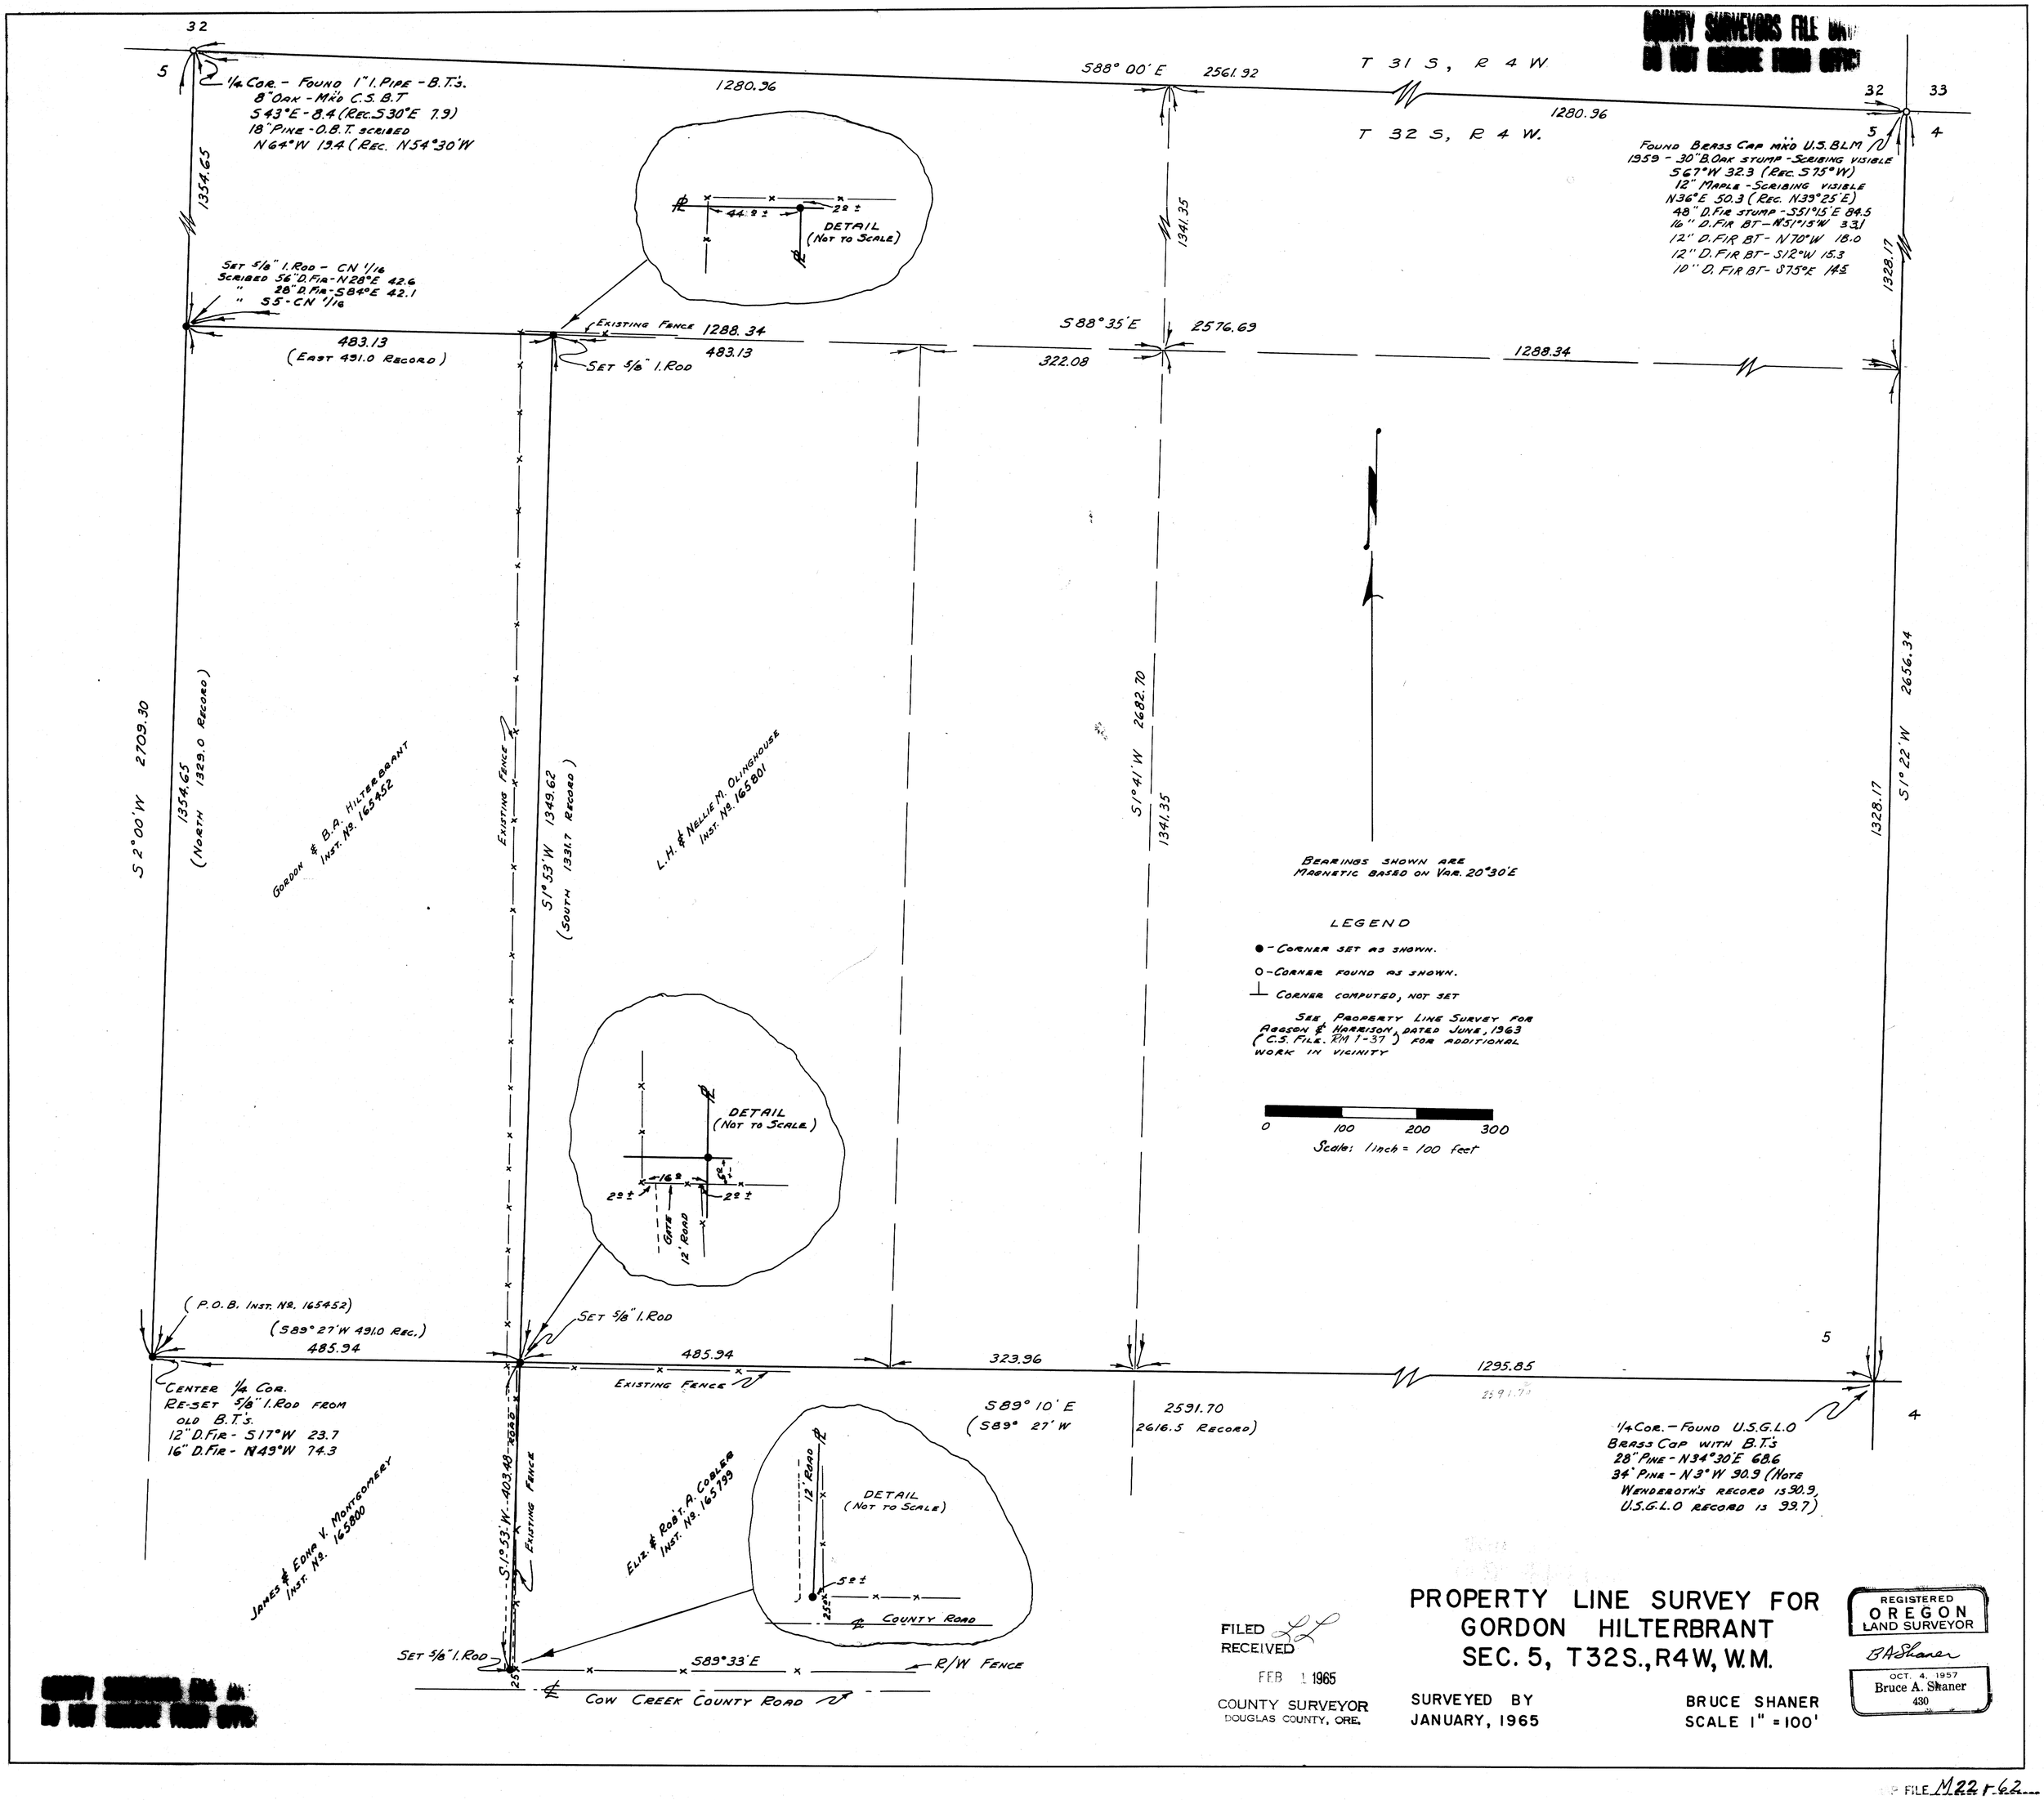

FILED
RECEIVED
FEB 1 1965
COUNTY SURVEYOR
DOUGLAS COUNTY, ORE.

PROPERTY LINE SURVEY FOR GORDON HILTERBRANT SEC. 5, T32S., R4W, W.M.

SURVEYED BY
JANUARY, 1965

BRUCE SHANER
SCALE 1" = 100'

REGISTERED
OREGON
LAND SURVEYOR
B A Shaner
OCT. 4, 1957
Bruce A. Shaner
430

MAP FILE M22 r 62