COUNTY SURVEYORS FILE DATA
DO NOT REMOVE FROM OFFICE

A SURVEY IN SECS. 28-29 & 32
TOWNSHIP 27 S. RANGE 7 W. W.M.

FOR NORMAN ATHERTON, EDWARD DAMEWOOD & ARTHUR JONES
BY DON E. GARRETT 2-21-66 SCALE 1" = 100'

BEARINGS ARE BASED ON THE RELOCATION SURVEY OF COUNTY ROAD #51, N24°35'00"E

REGISTERED
OREGON
LAND SURVEYOR
Don E. Garrett
JULY 14, 1961
DON E. GARRETT
544

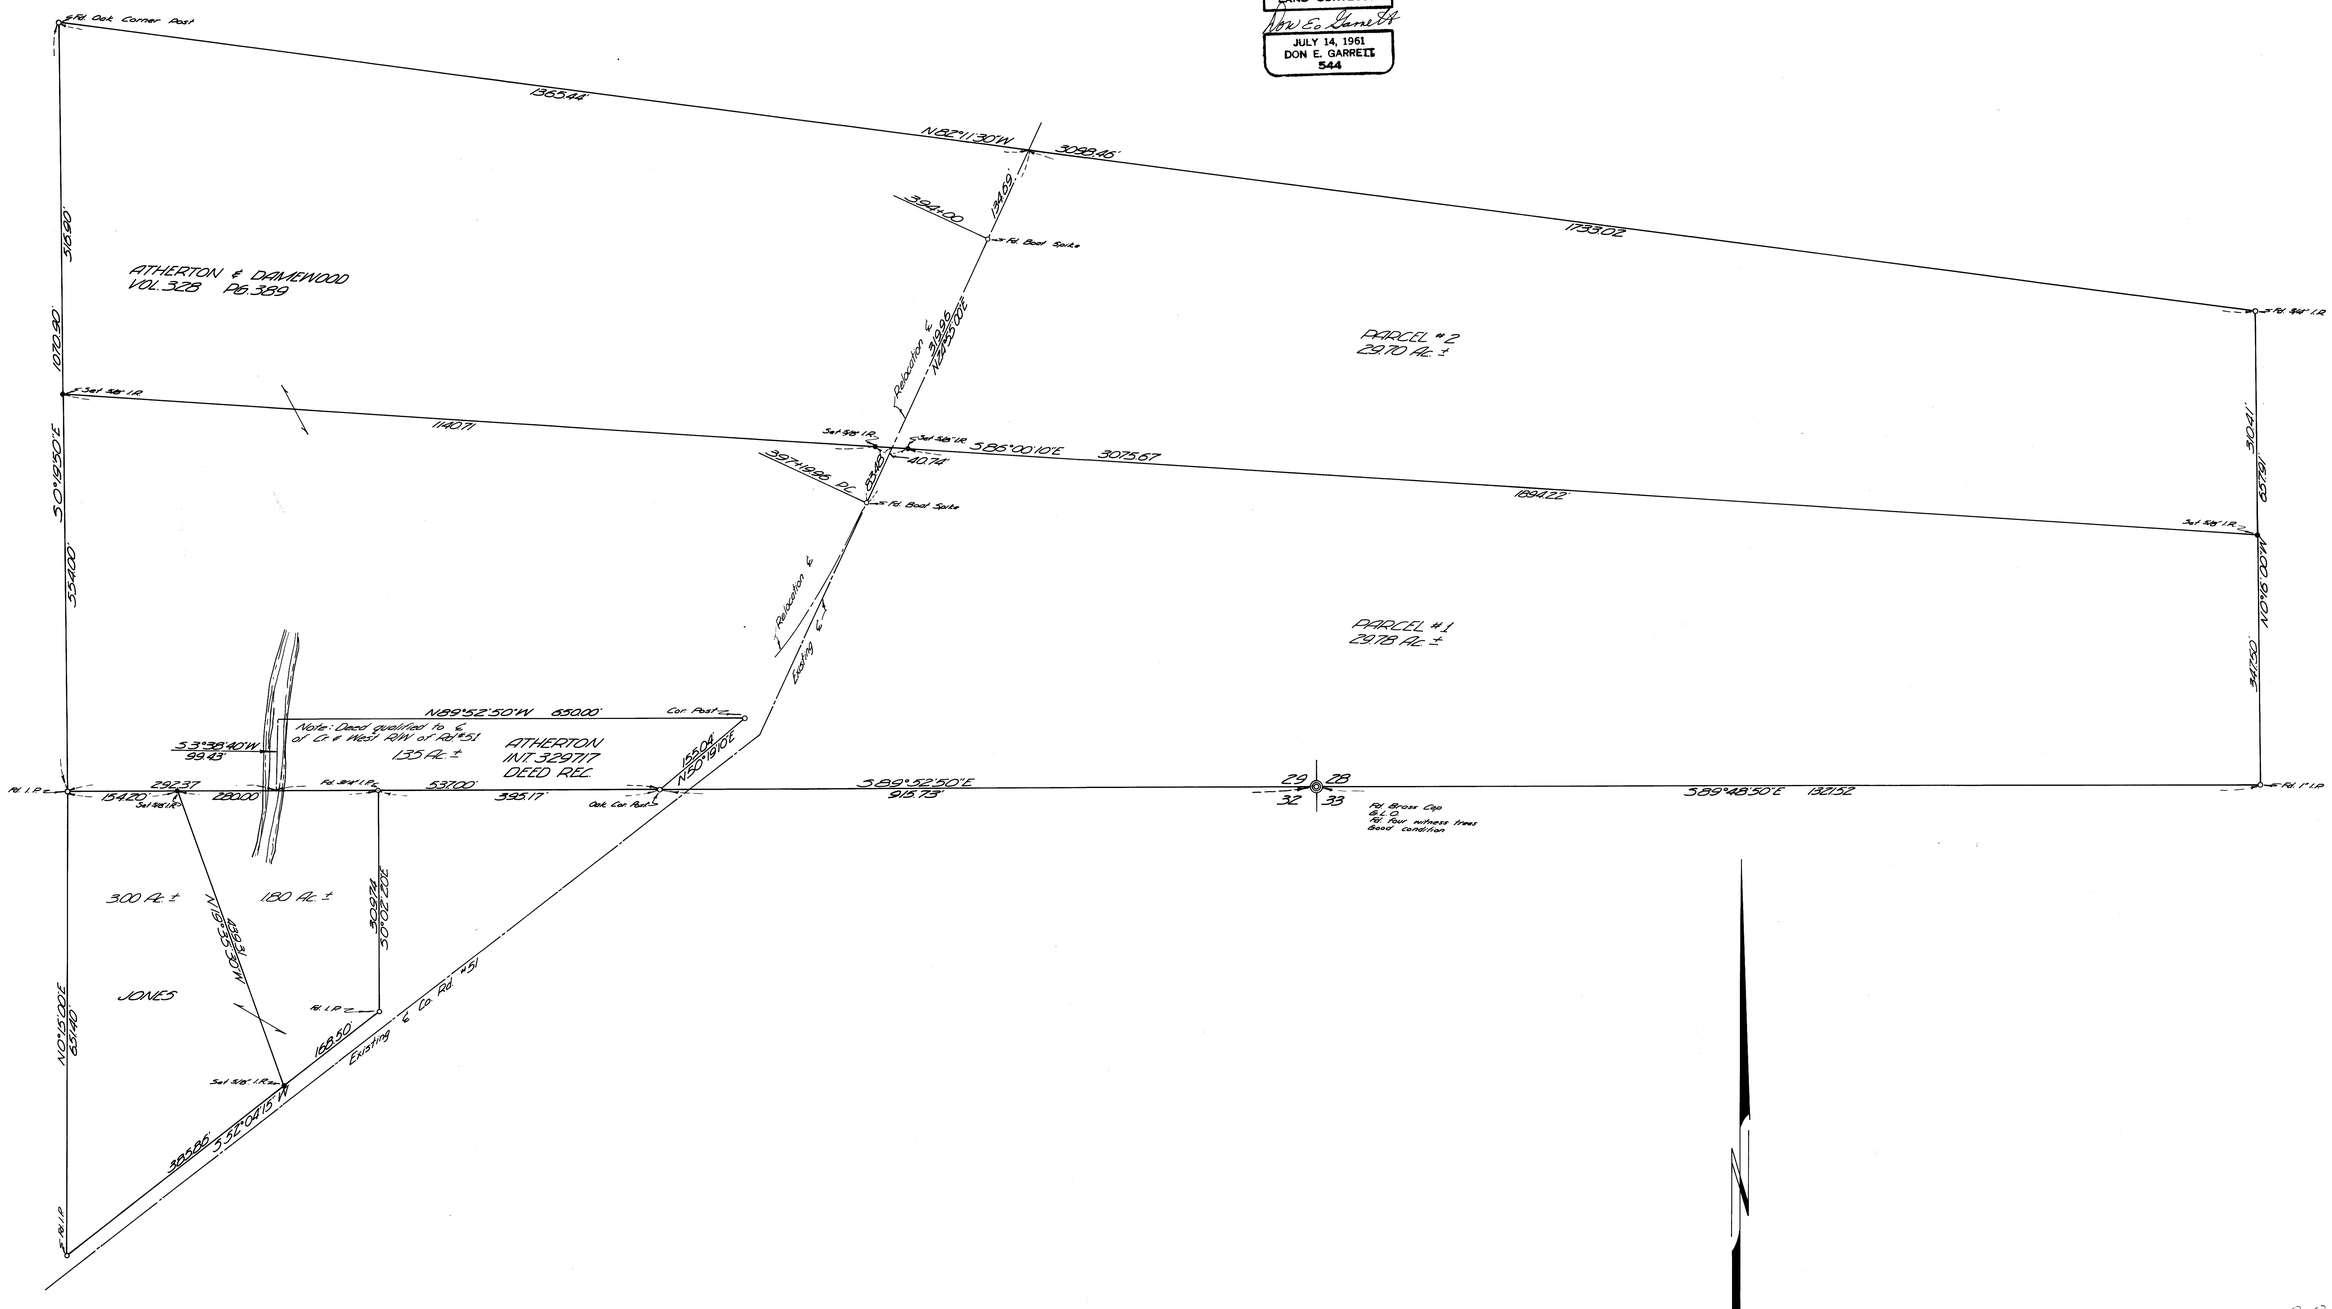

COUNTY SURVEYORS FILE DATA
DO NOT REMOVE FROM OFFICE

FILED
RECEIVED
MAR 2 1966
COUNTY SURVEYOR
DOUGLAS COUNTY, ORE.

MAP FILE M 22 7 77 i