COUNTY SURVEYORS FILE DATA
DO NOT REMOVE FROM OFFICE

SURVEY IN MOFFITT BLK. & BLK. 53-B, RAILROAD ADD. TO ROSEBURG, DOUGLAS COUNTY, OREGON

SURVEYED FOR: R. P. STRITZKE
SURVEYED BY: G. R. LECKLIDER-ENGINEER

FEBRUARY, 1962
SCALE: 1" = 50'

REGISTERED PROFESSIONAL ENGINEER 4079 OREGON OCT. 15, 1956 ROBERT LECKLIDER

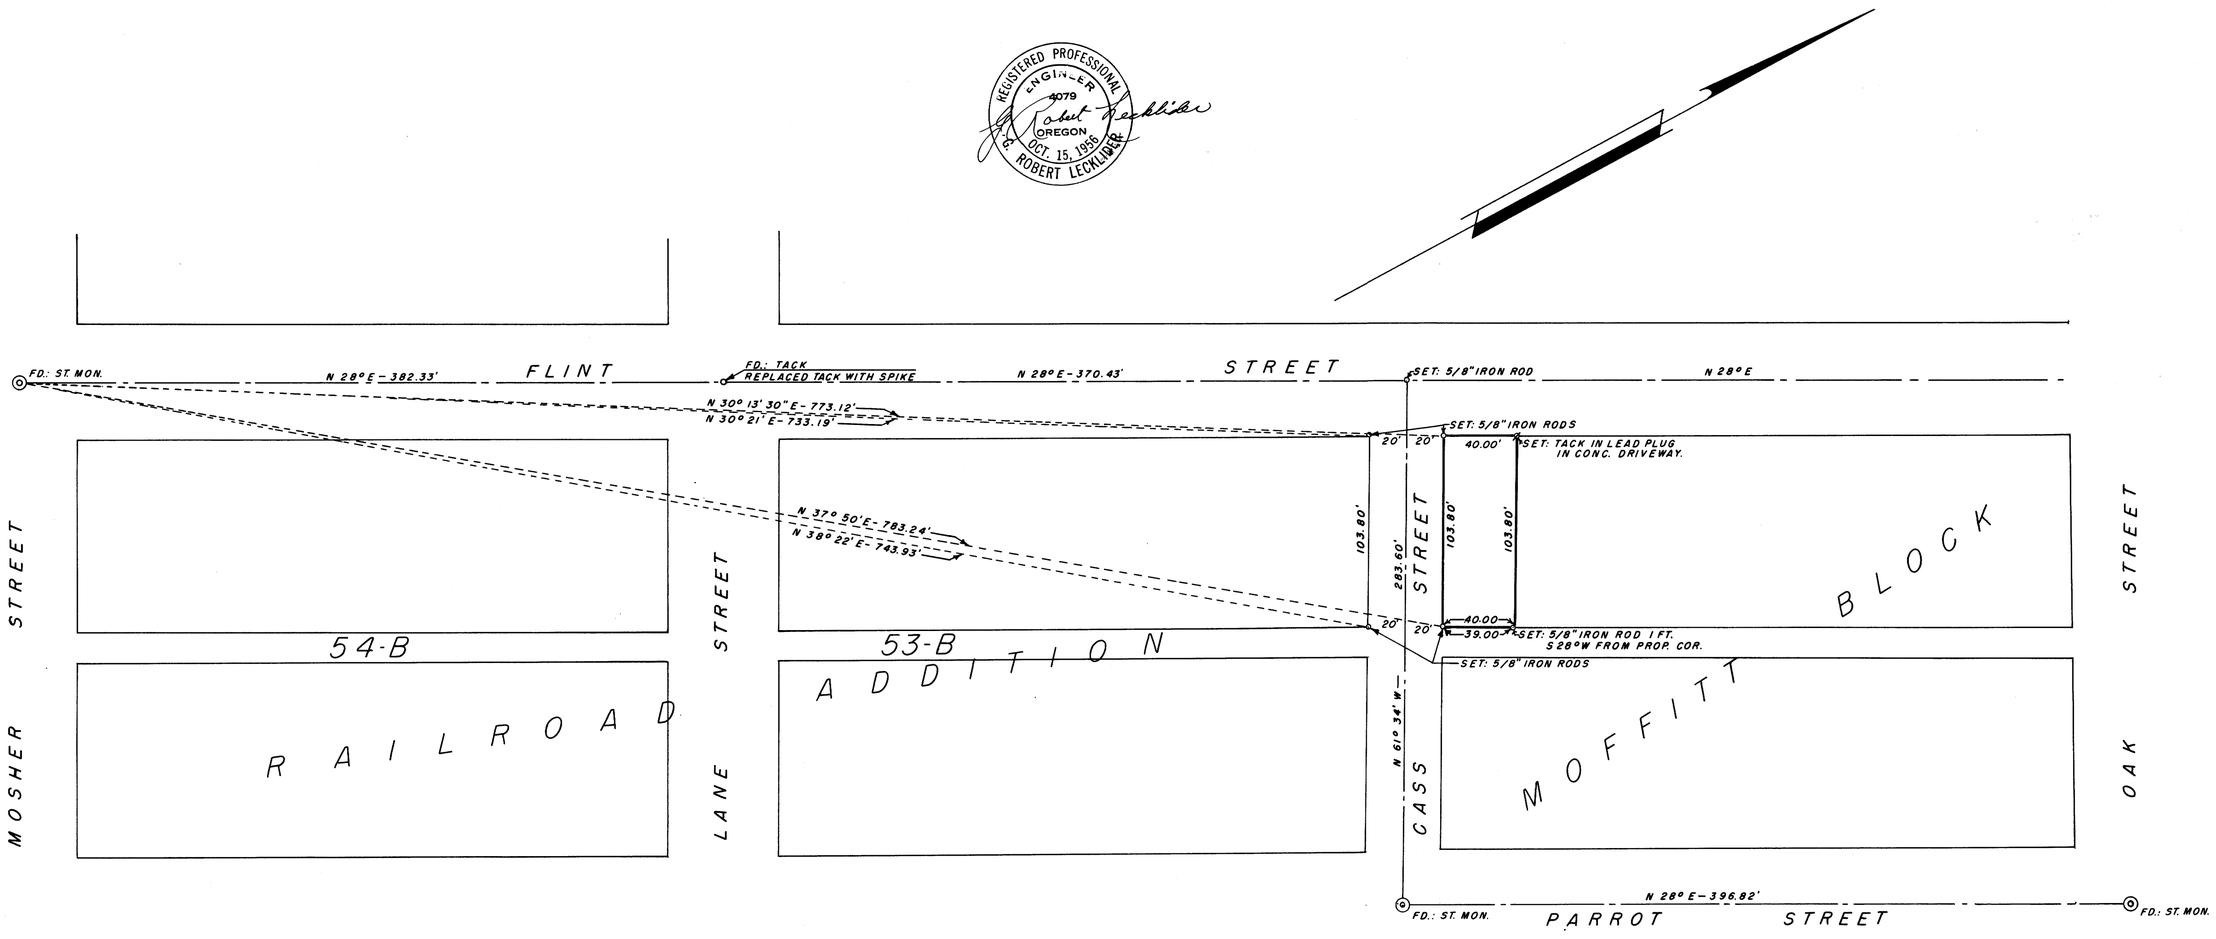

FILED
RECEIVED
FEB 23 1962
COUNTY SURVEYOR
DOUGLAS COUNTY, ORE.

MAP FILE M 22 T-12
MAP FILE M 22 T-12