C.S. 52/105
M23-15

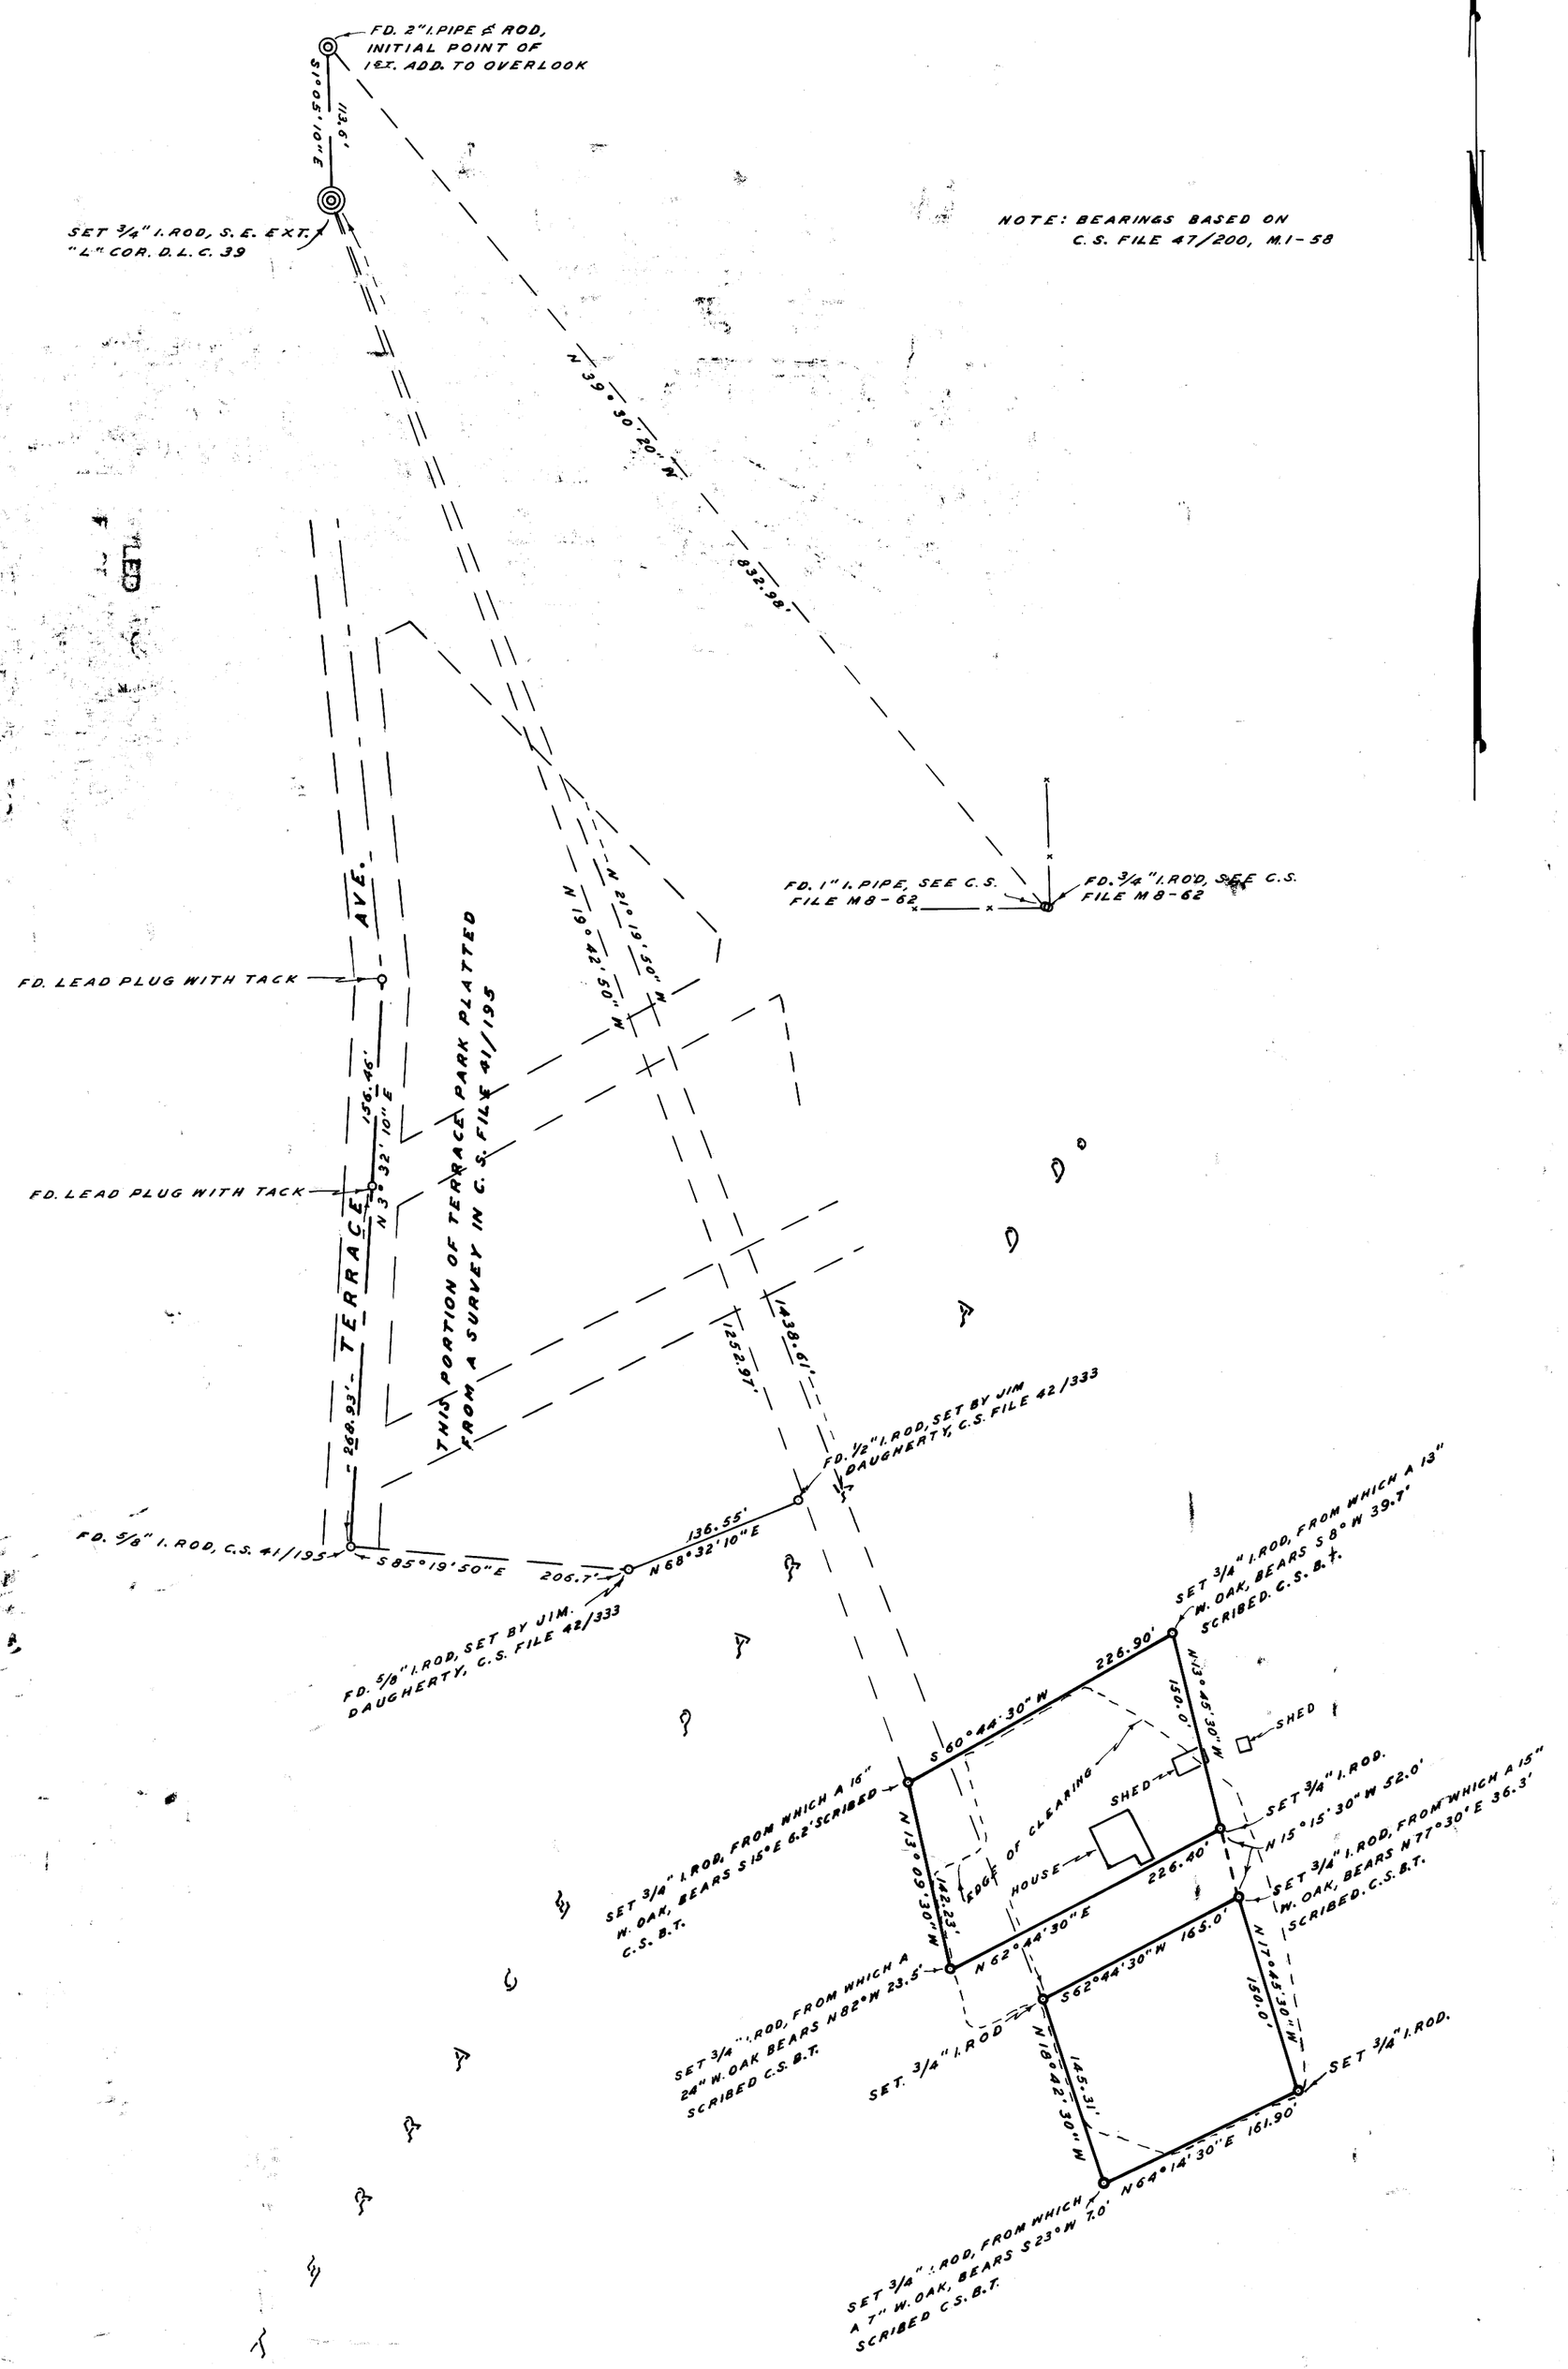

COUNTY SURVEYOR'S OFFICE
DOUGLAS COUNTY, OREGON

SURVEY FOR DEED DESCRIPTION,
TERRACE PARK ADDITION TO THE
CITY OF ROSEBURG

FRED M. DARBY — COUNTY SURVEYOR
SURVEYED FEB. 1, 1962 — BY
JAMES W. BYRON - DEPUTY — SCALE 1" = 100'
SURVEYED FOR E. METZGER

James W. Byron

COUNTY SURVEYORS FILE DATA
DO NOT REMOVE FROM OFFICE

C.S. FILE 52/105
M23-15