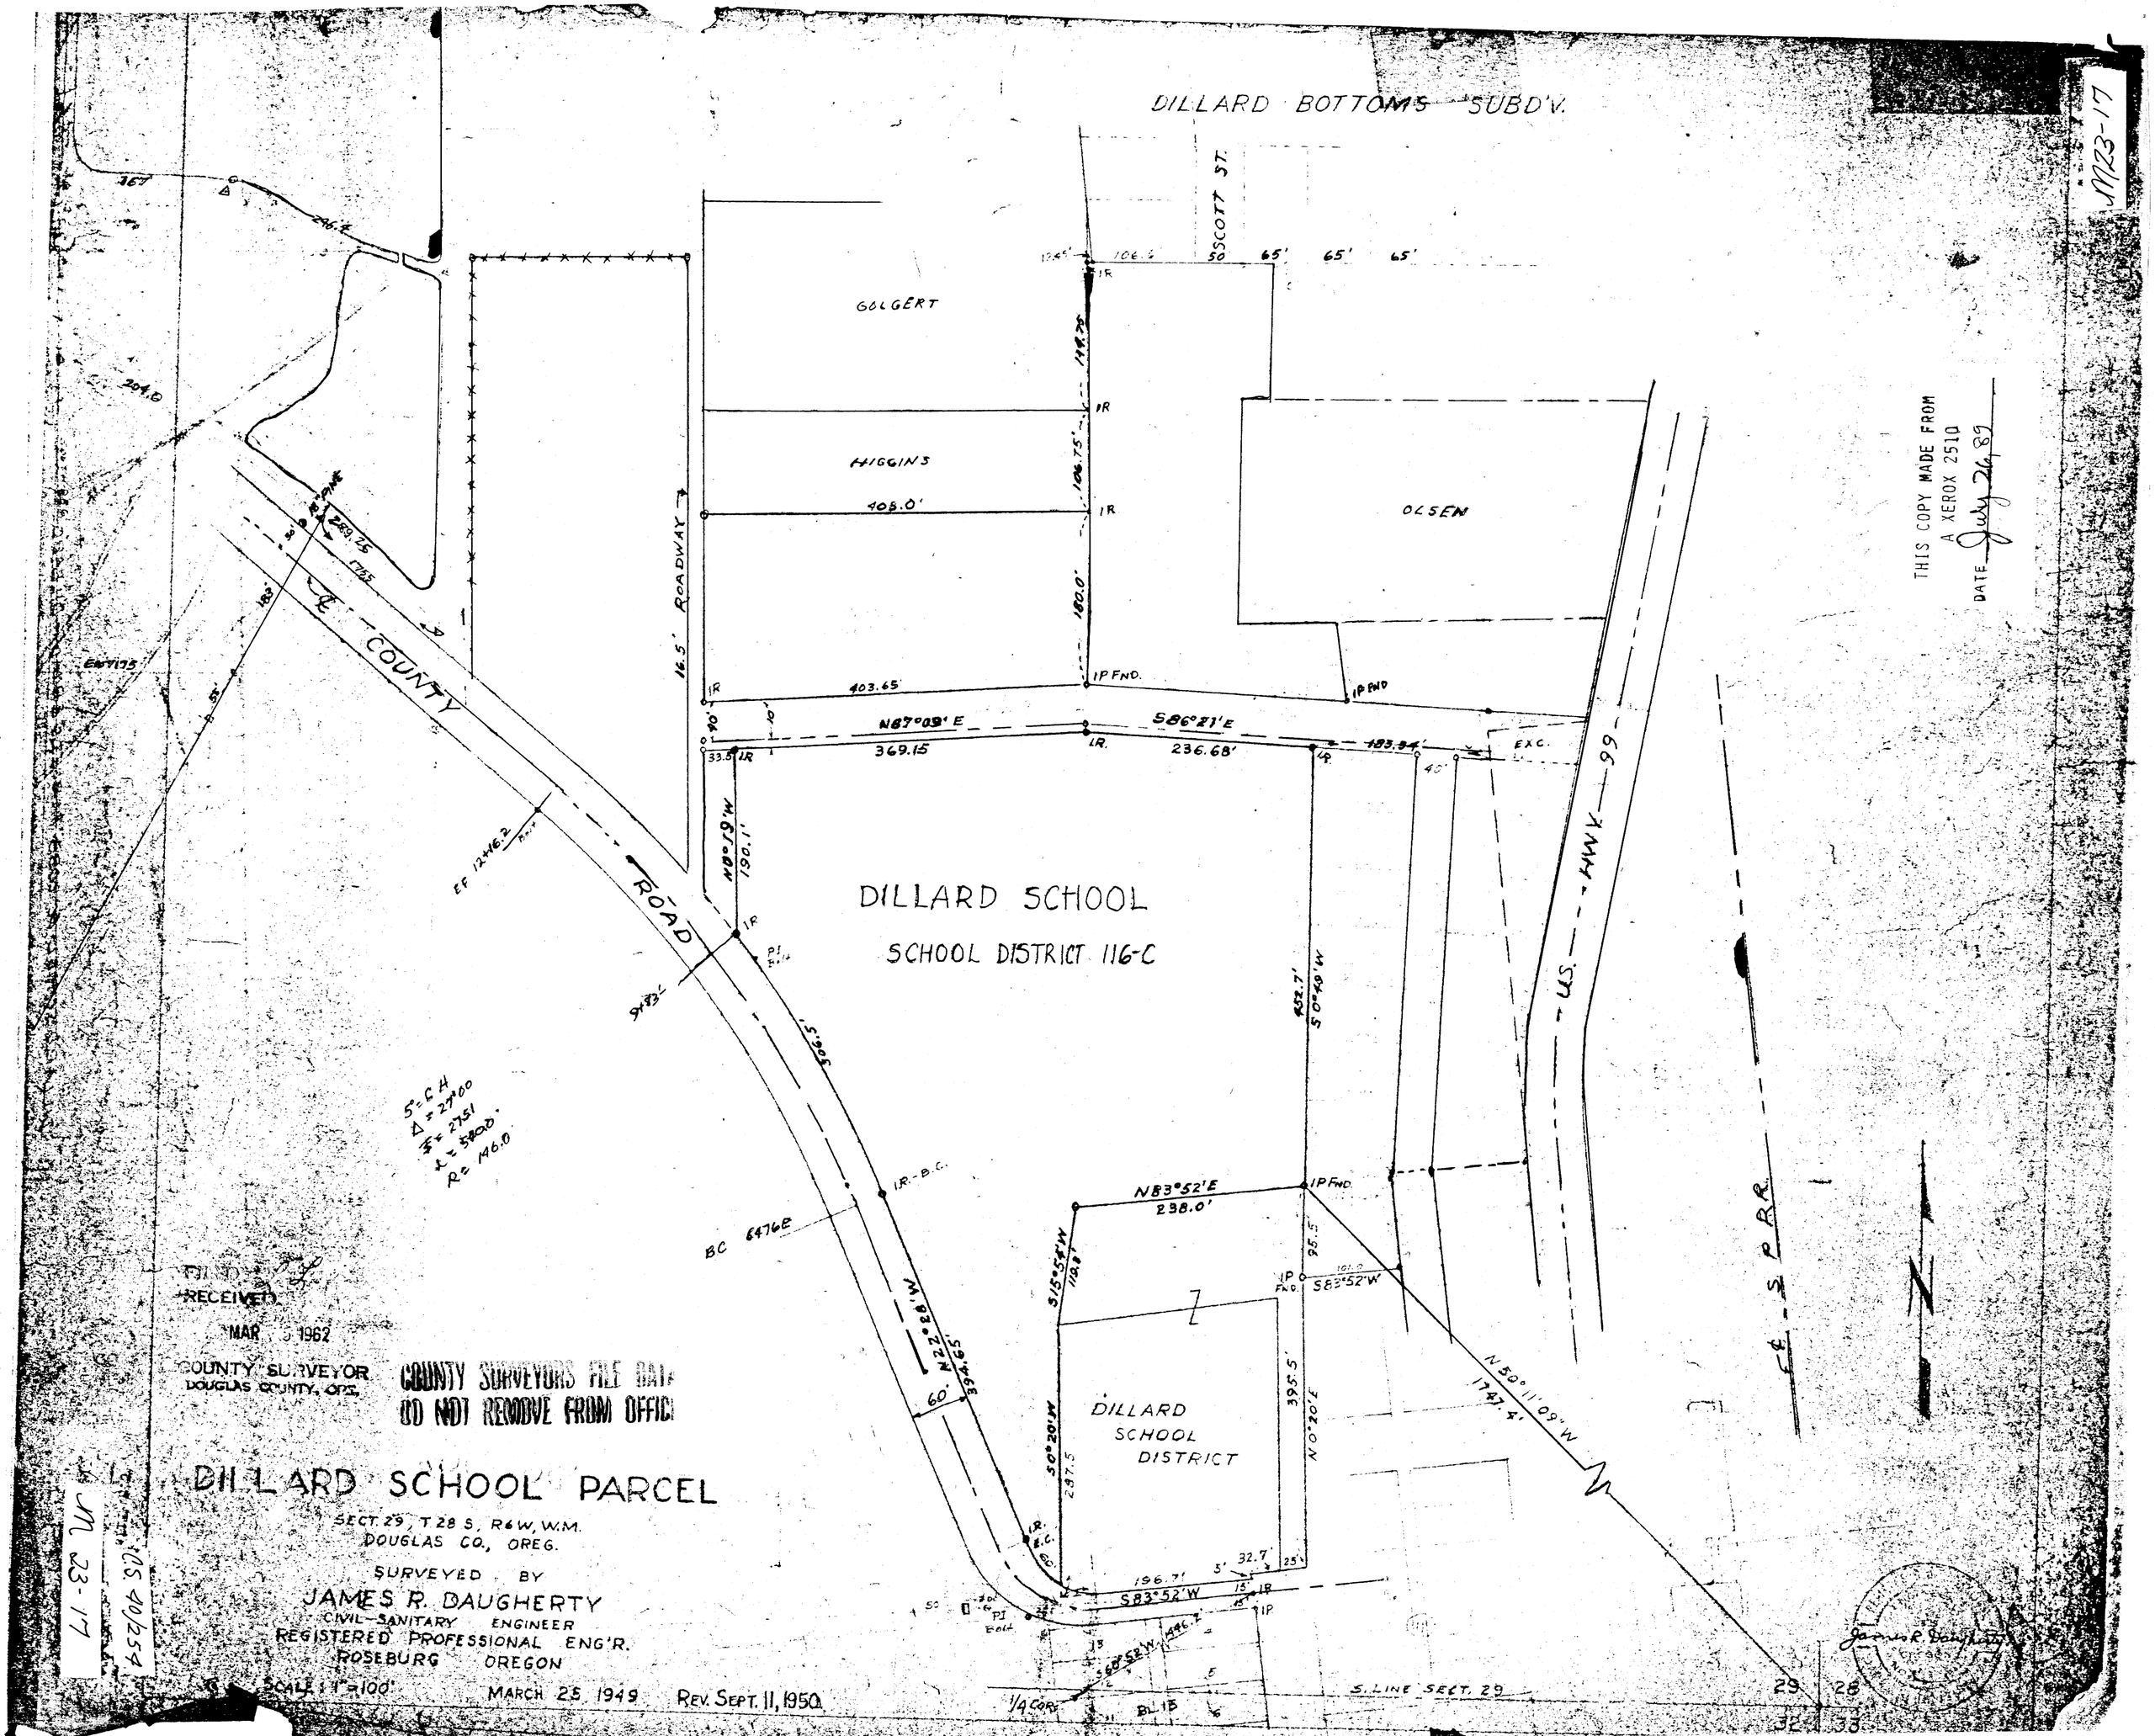
DILLARD BOTTOMS SUBD'V.
SCOTT ST.
GOLGERT
HIGGINS
OLSEN
408.0'
403.65'
N87°09' E
369.15
S86°21' E
236.68'
183.94'
EXC.
N0°19' W
190.1'
16.5' ROADWAY
COUNTY ROAD
DILLARD SCHOOL
SCHOOL DISTRICT 116-C
U.S. HWY 99
S.P.R.R.
N83°52' E
238.0'
S83°52' W
DILLARD SCHOOL DISTRICT
N50°11'09" W
1747.4'
S.LINE SECT. 29
1/4 CORS
BL 18
29
28
32
33
THIS COPY MADE FROM A XEROX 2510
DATE July 26, 89
M23-17
RECEIVED
MAR 1962
COUNTY SURVEYOR
DOUGLAS COUNTY, ORE.
COUNTY SURVEYORS FILE DATA
DO NOT REMOVE FROM OFFICE
DILLARD SCHOOL PARCEL
SECT. 29, T 28 S, R 6 W, W.M.
DOUGLAS CO., OREG.
SURVEYED BY
JAMES R. DAUGHERTY
CIVIL-SANITARY ENGINEER
REGISTERED PROFESSIONAL ENG'R.
ROSEBURG OREGON
SCALE: 1" = 100'
MARCH 25, 1949
REV. SEPT. 11, 1950
M 23-17
U.S. 40/254