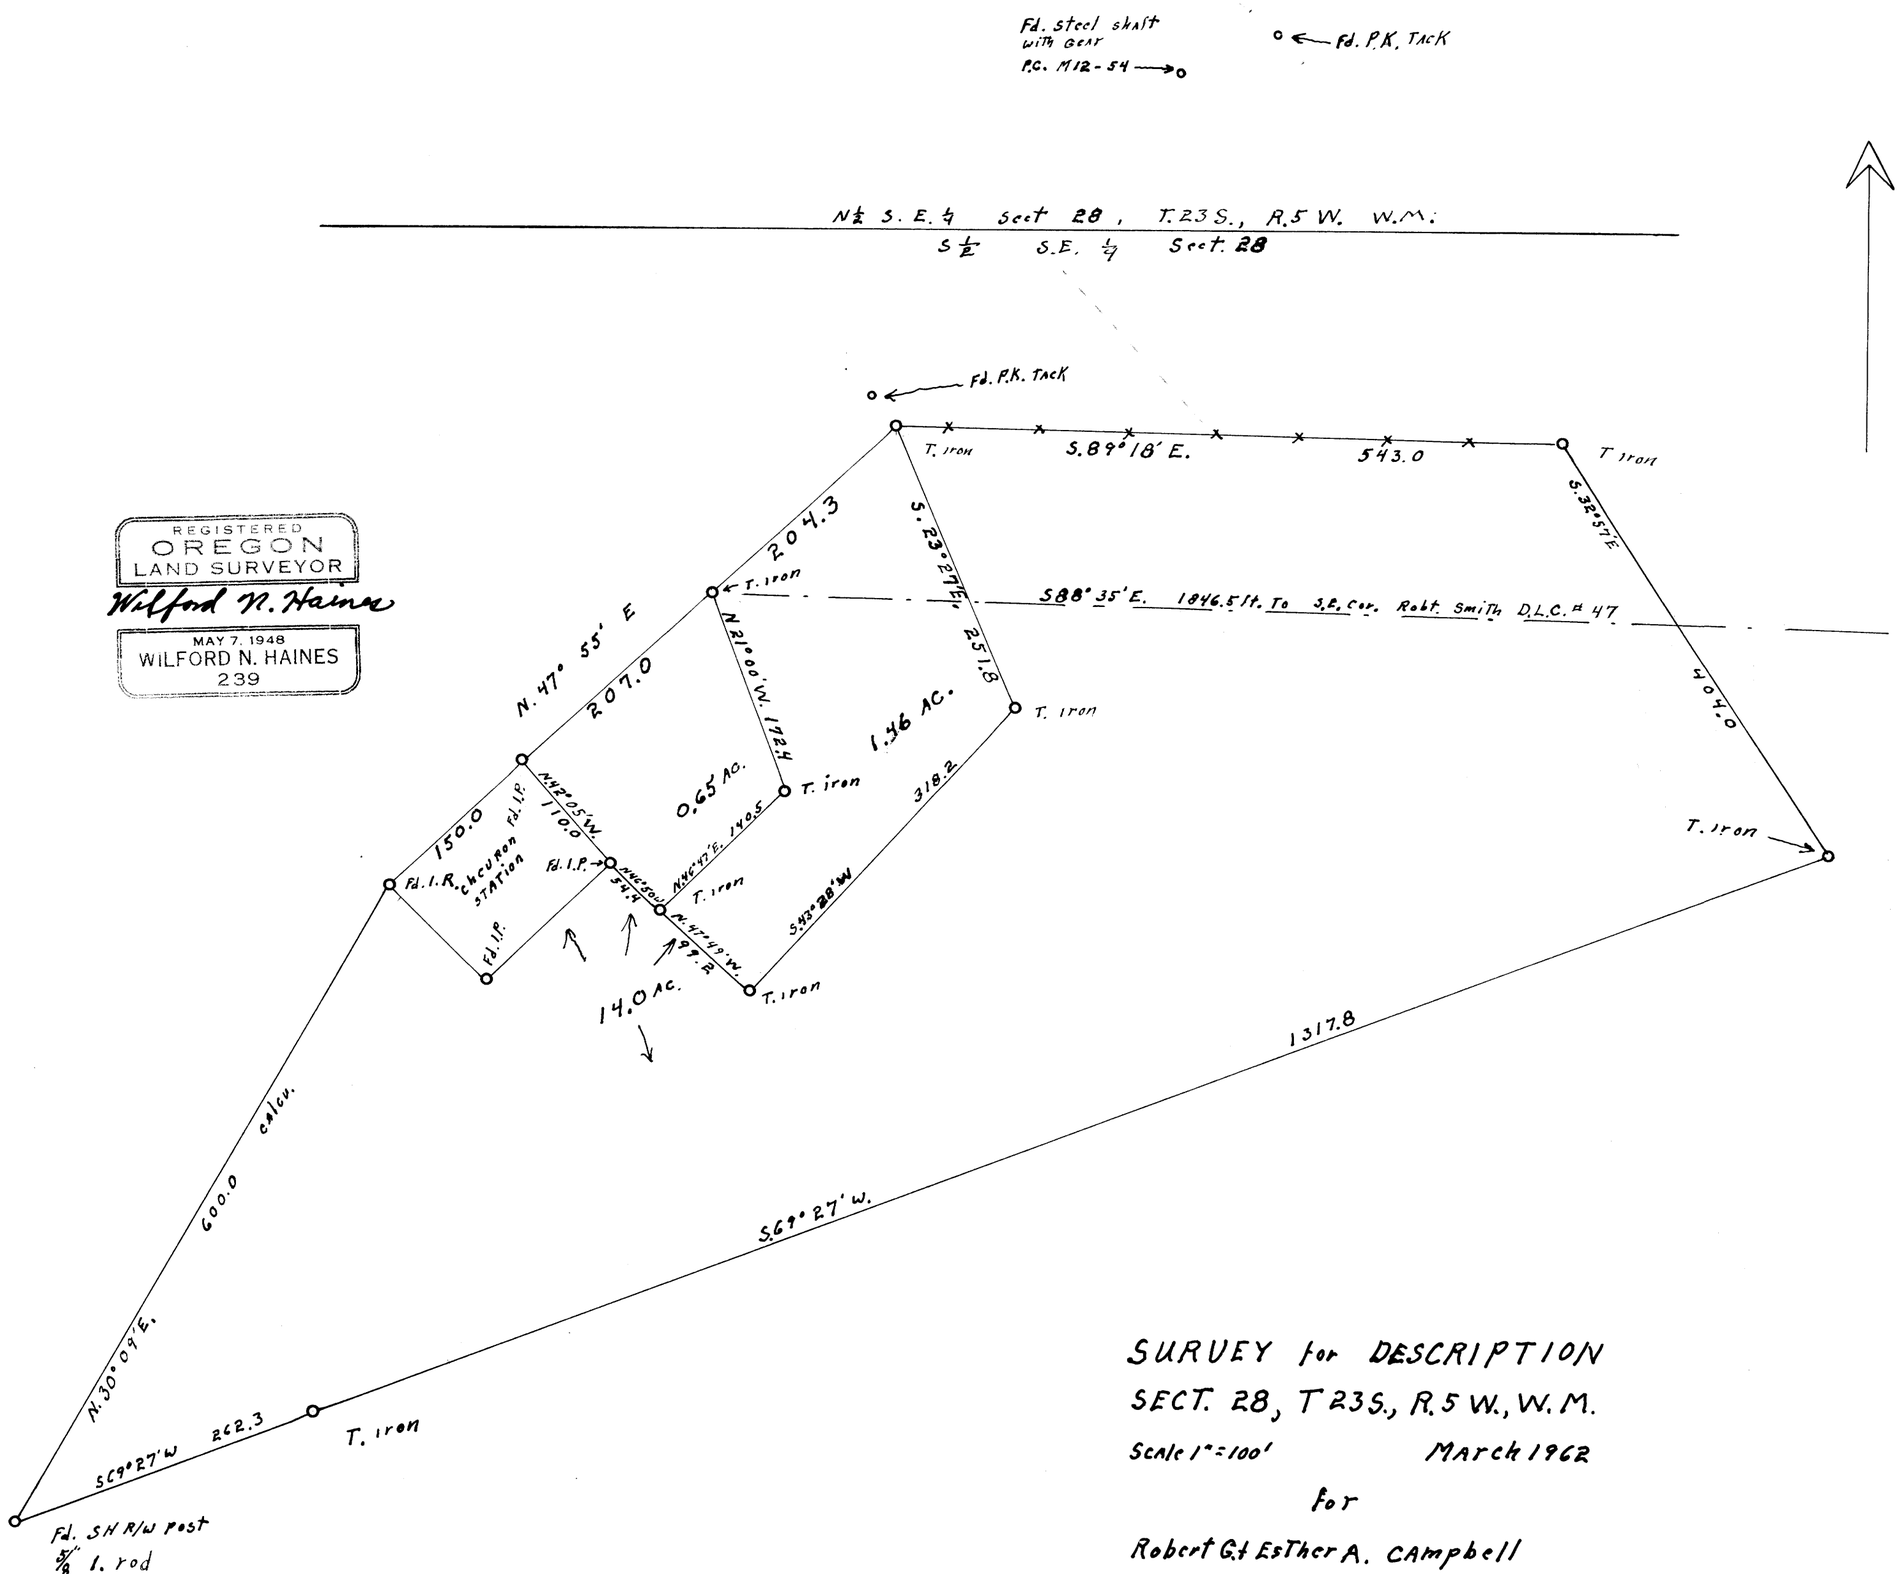

REGISTERED
OREGON
LAND SURVEYOR
Wilford N. Haines
MAY 7, 1948
WILFORD N. HAINES
239

SURVEY for DESCRIPTION
SECT. 28, T 23S., R.5 W., W.M.
Scale 1" = 100' March 1962
for
Robert G. & Esther A. Campbell

COUNTY SURVEYORS FILE DATA
DO NOT REMOVE FROM OFFICE

FILED
RECEIVED
APR 27 1962
COUNTY SURVEYOR
DOUGLAS COUNTY, ORE.

MAP FILE M 23-40

M 23-40