M 33-50

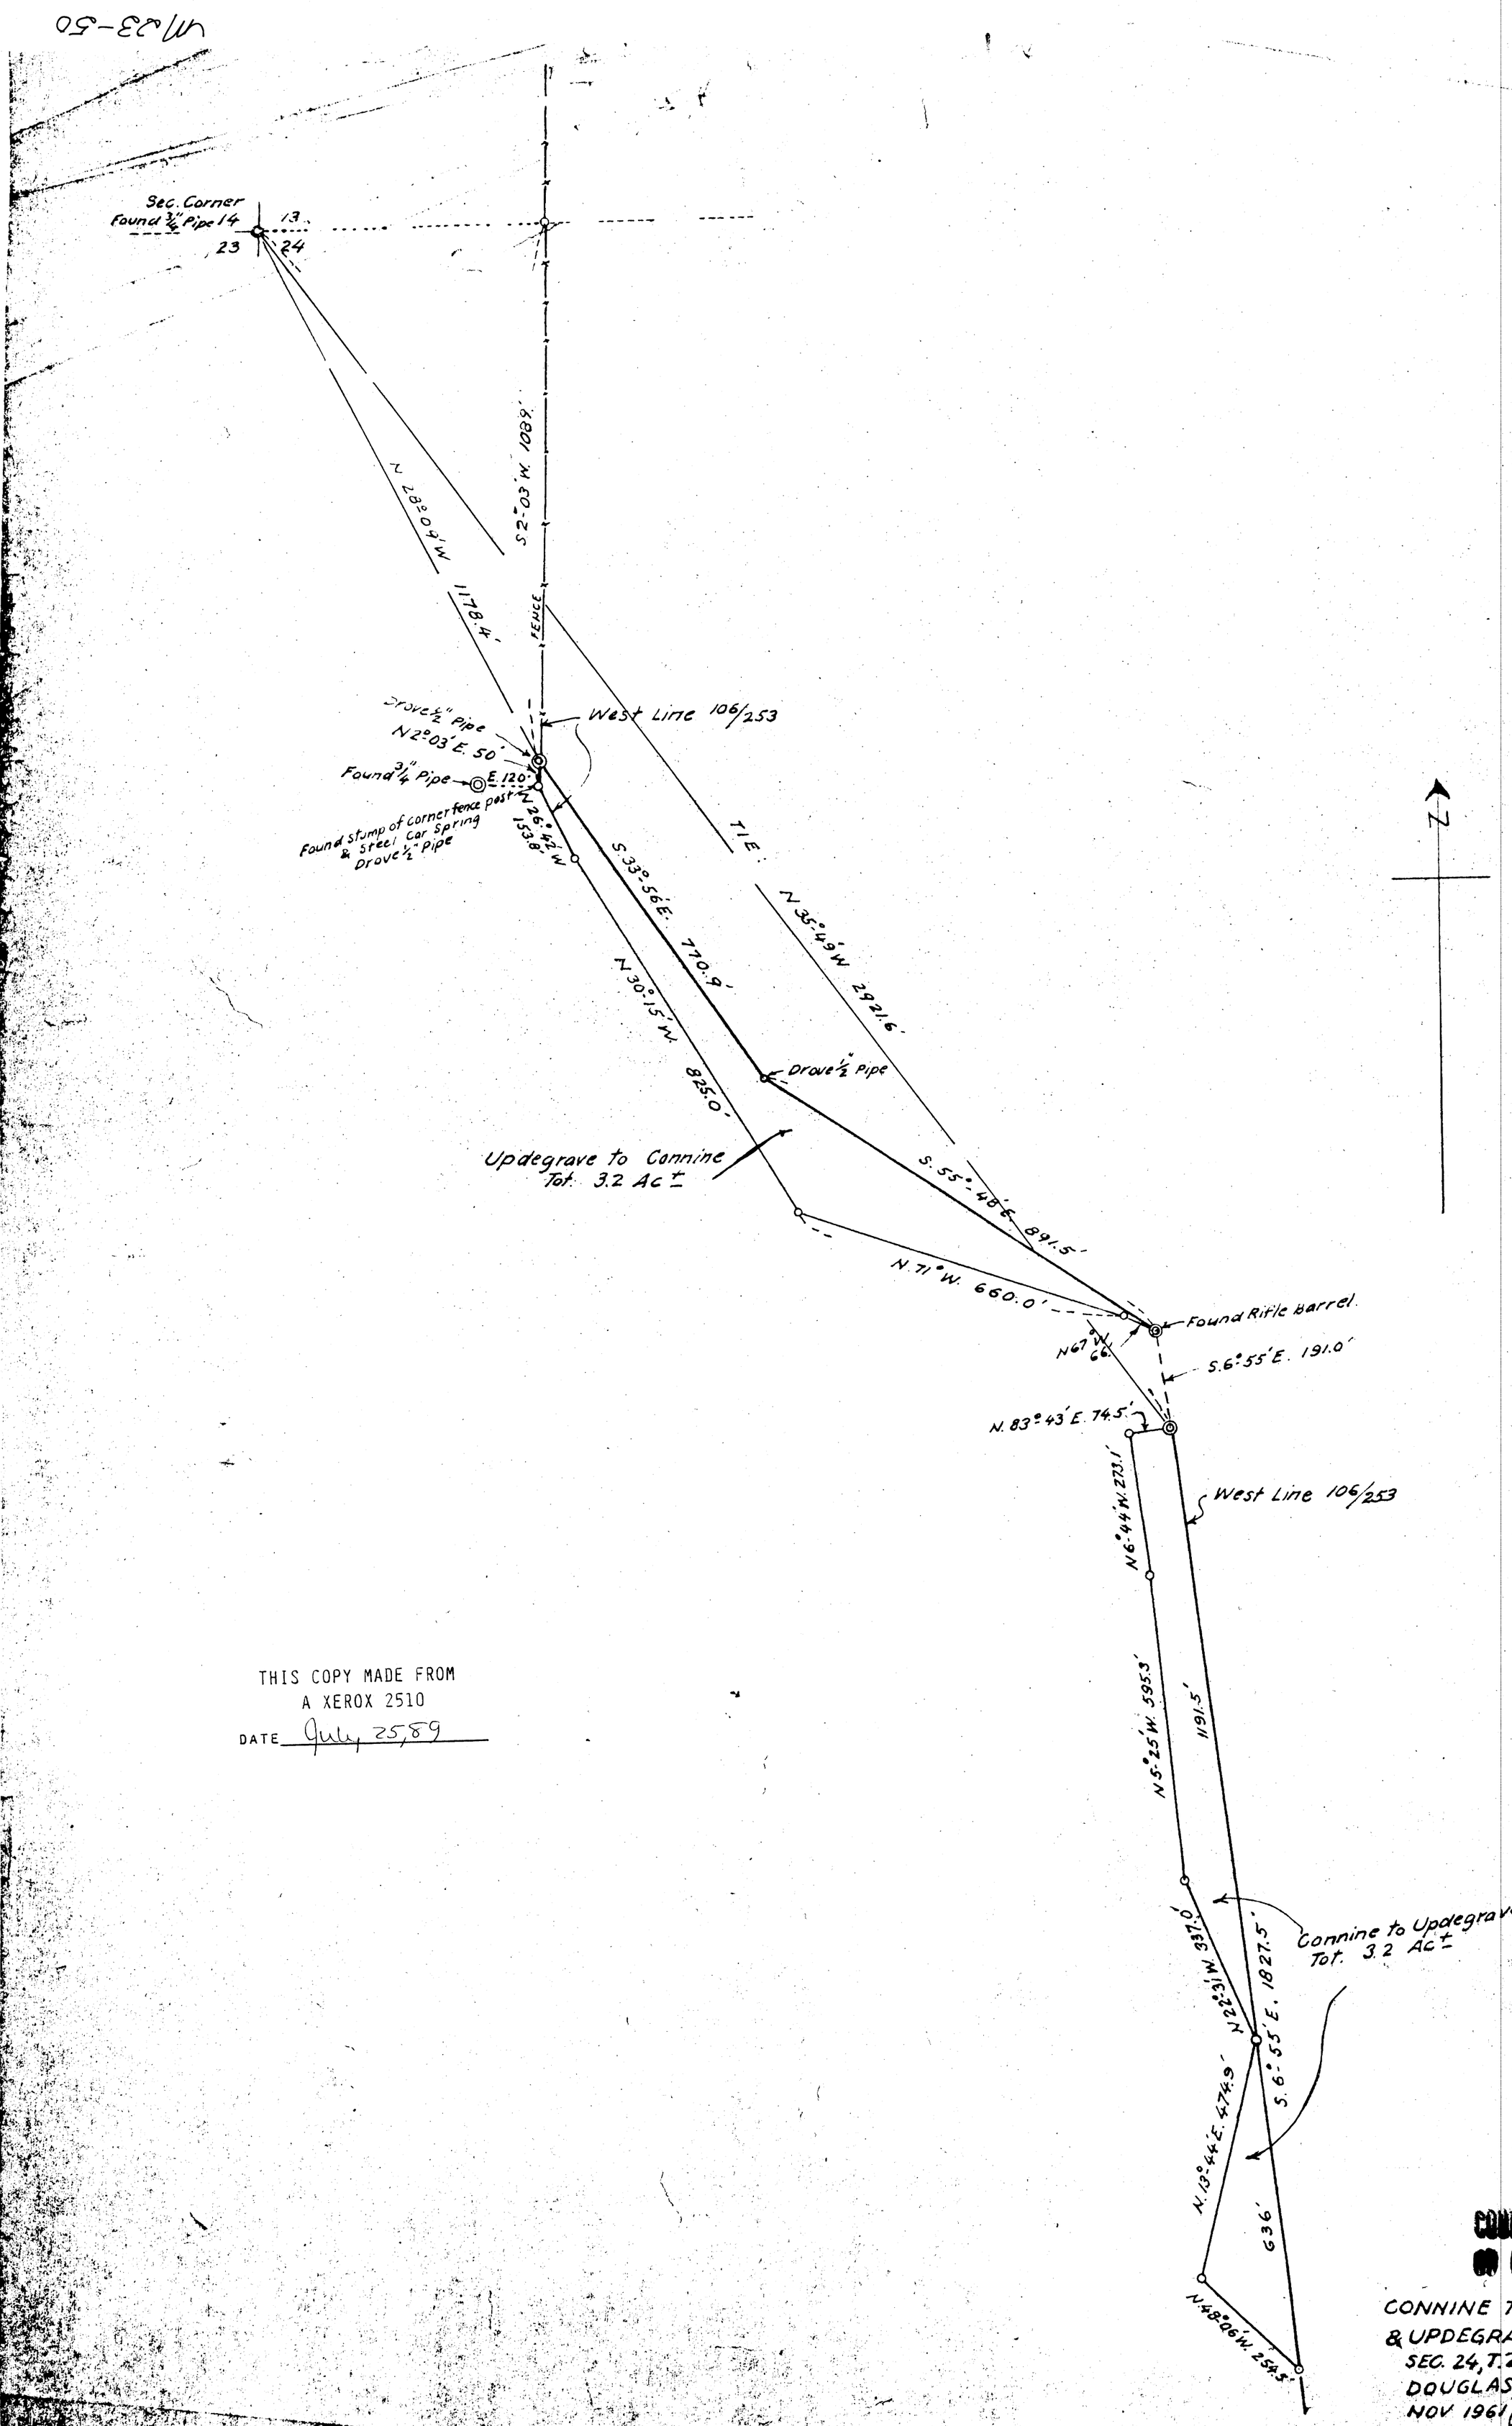

THIS COPY MADE FROM
A XEROX 2510
DATE July 25, 89

FILED L.L.
RECEIVED
MAY 7 1962
COUNTY SURVEYOR
DOUGLAS COUNTY, ORE.

COUNTY SURVEYORS FILE DATA
DO NOT REMOVE FROM OFFICE

CONNINE TO UPDEGRAVE
& UPDEGRAVE TO CONNINE
SEC. 24, T. 26S; R 4 W W.M.
DOUGLAS COUNTY, ORE
NOV 1961 Arthur Boyer 1"=200'

M 22-50